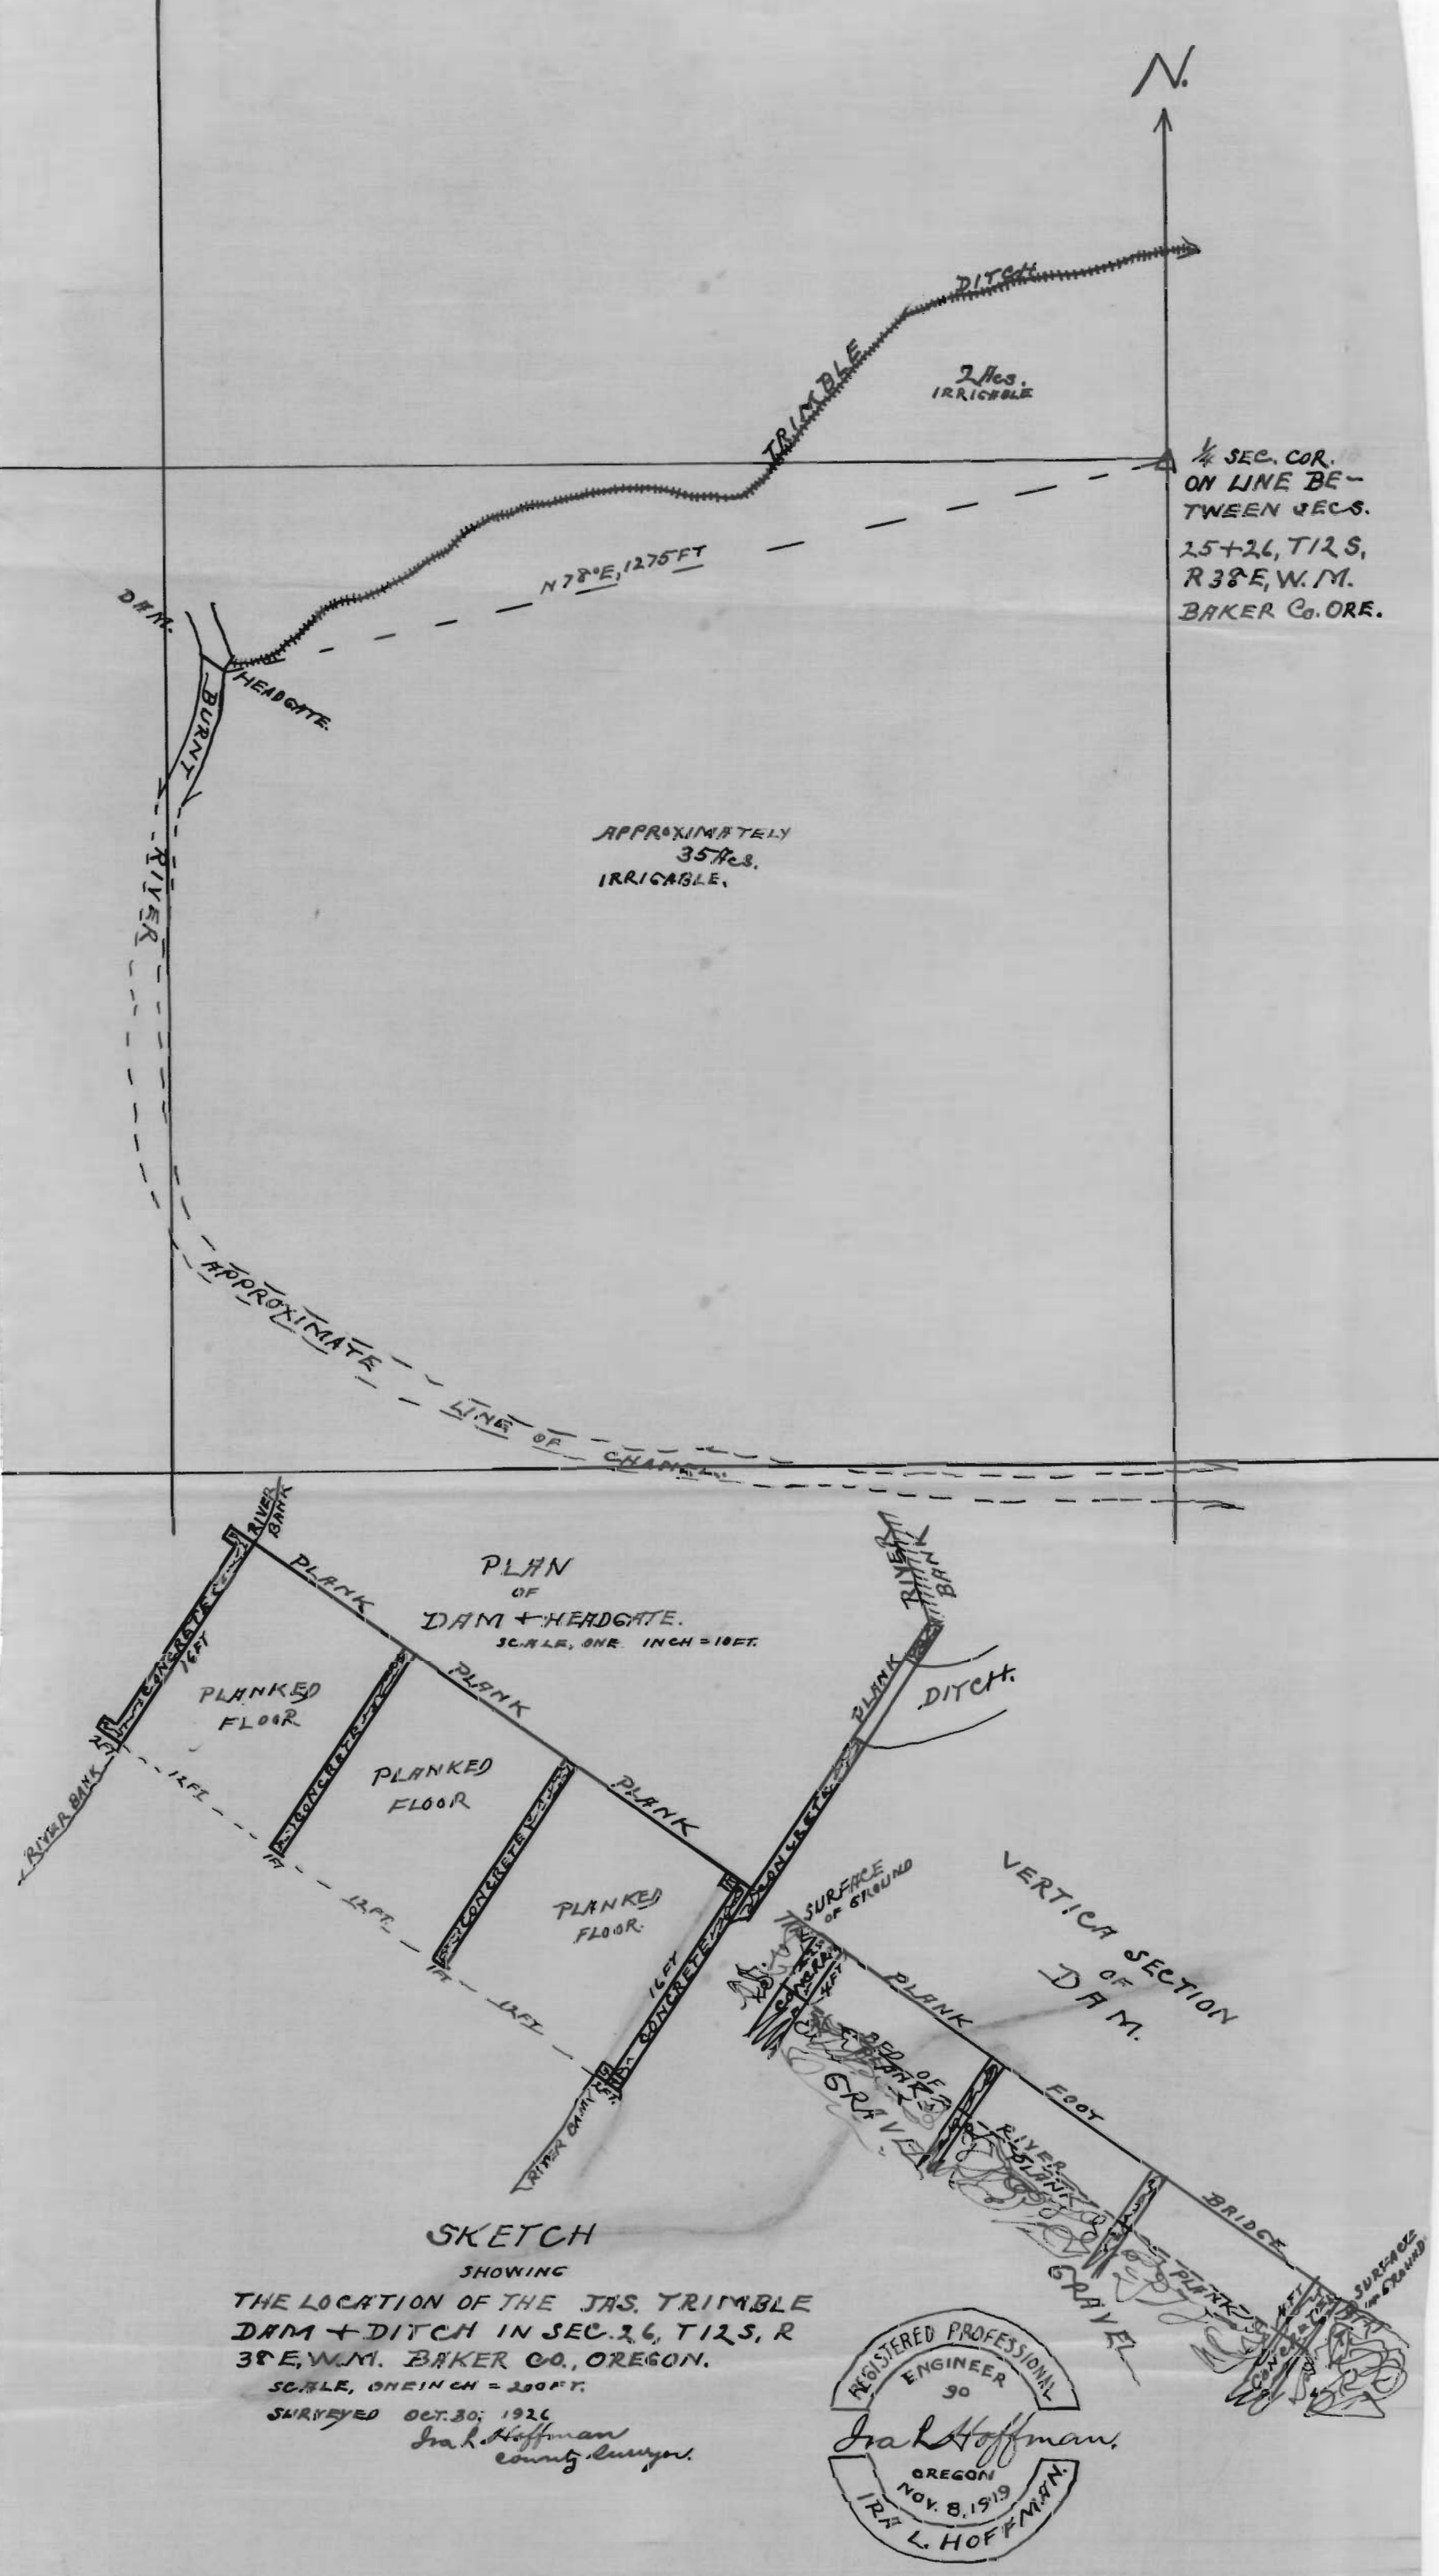

SKETCH
SHOWING
THE LOCATION OF THE JAS. TRIMBLE
DAM + DITCH IN SEC. 26, T12S, R
38E, W.M. BAKER CO., OREGON.
SCALE, ONE INCH = 200 FT.
SURVEYED OCT. 30, 1926
Ira L. Hoffman
County Surveyor.

REGISTERED PROFESSIONAL ENGINEER 90
Ira L Hoffman.
OREGON
NOV. 8, 1919
IRA L. HOFFMAN.

CERTIFICATE OF SURVEYOR.

I, IRA L. HOFFMAN, OF BAKER, ORE., DO HEREBY CERTIFY THAT THIS MAP WAS MADE FROM NOTES TAKEN DURING AN ACTUAL SURVEY MADE BY ME ON OCT. 30, 1926 + THAT IT CORRECTLY REPRESENTS THE DATA SHOWN THEREON AS PER SAID SURVEY.

Ira L Hoffman,
County Surveyor.

Application No. 11162
Permit No. 76[illegible]