


T.2S., R.45E., W.M.

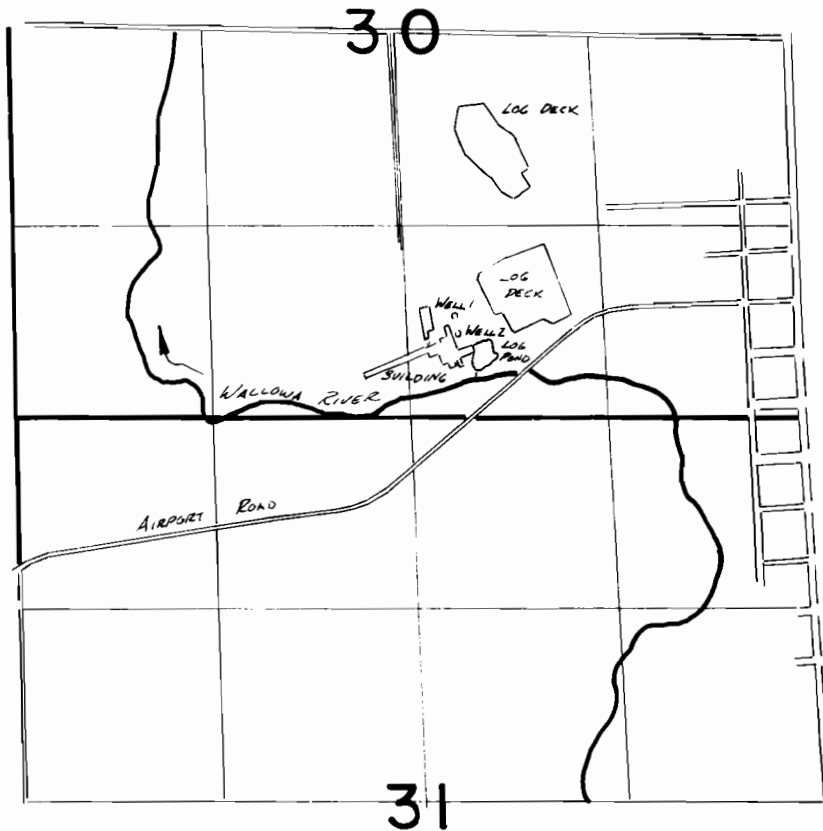

WELL 1 Loc: 700' N. & 340' E. FROM SPT COR. SEC 30  
WELL 2 Loc: 580' N. & 35' E. FROM SPT COR. SEC 30

**FINAL PROOF SURVEY**  
UNDER

Application No. **G:6435** Permit No. **G:6026**...  
IN NAME OF

**BOISE CASCADE CORP.**

Surveyed *Aug. 11*..... 19*82*., by *V.L. Church*.....