11181

ROZELLA WATER WORKS
T. 14 S. R. 8 W. W.M.

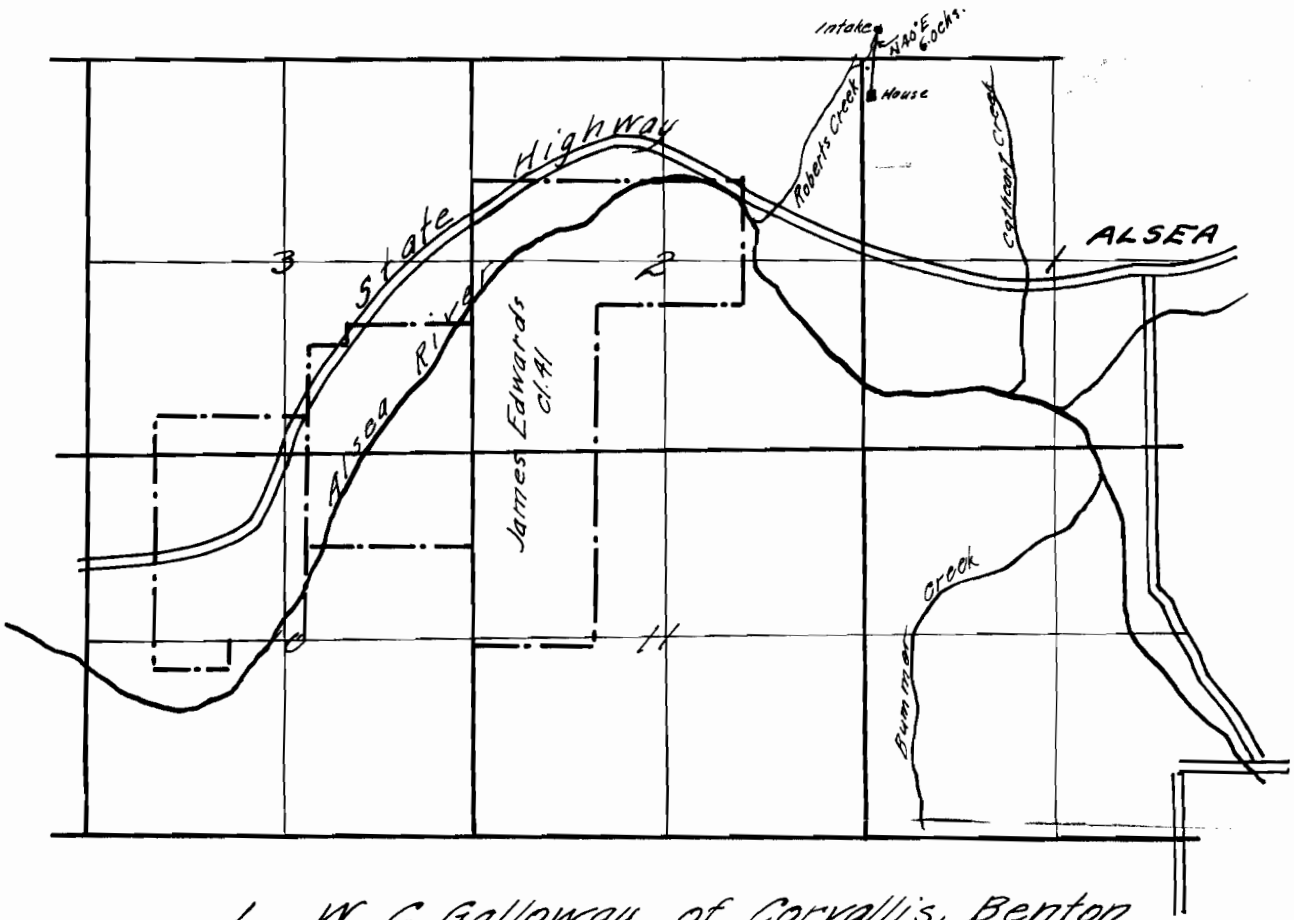

I, W. C. Galloway, of Corvallis, Benton County, Oregon, do hereby certify that this map was made from notes taken during an actual survey made by me on April 20, 1920, and that it correctly represents the works described in the accompanying application, together with the location of streams and other ditches in the immediate vicinity.

W. C. Galloway
County Engineer
Ore. Reg. No. 44

Scale:- 1 in. = 40 chs.

Application No.
Permit No. 7663