


T.39S.R.8W.W.M.

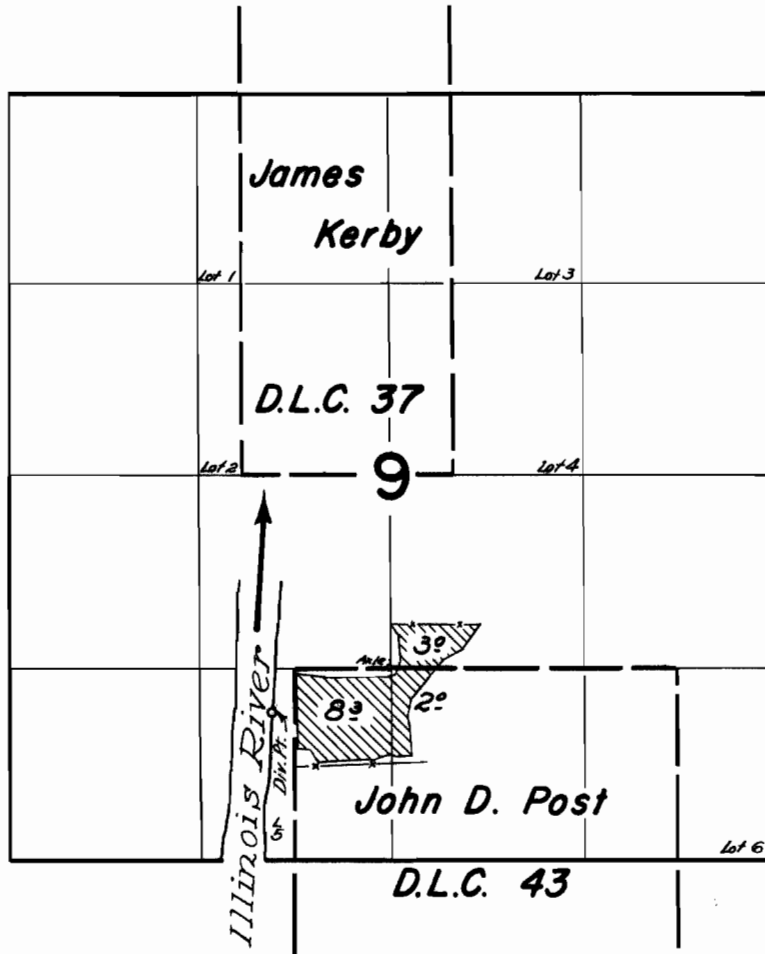

**FINAL PROOF SURVEY**  
UNDER

Application No. 33449 Permit No. 26436  
IN NAME OF

WILLIAM KLEIN

Surveyed July 12, 1963, by [Signature]