






**HOOD RIVER COUNTY**  
1"=400'

THIS MAP WAS PREPARED FOR  
ASSESSMENT PURPOSE ONLY

Cancelled No's.  
1300  
200  
301  
102

**RECEIVED**  
JUN 03 2002  
WATER RESOURCES DEPT.  
SALEM, OREGON

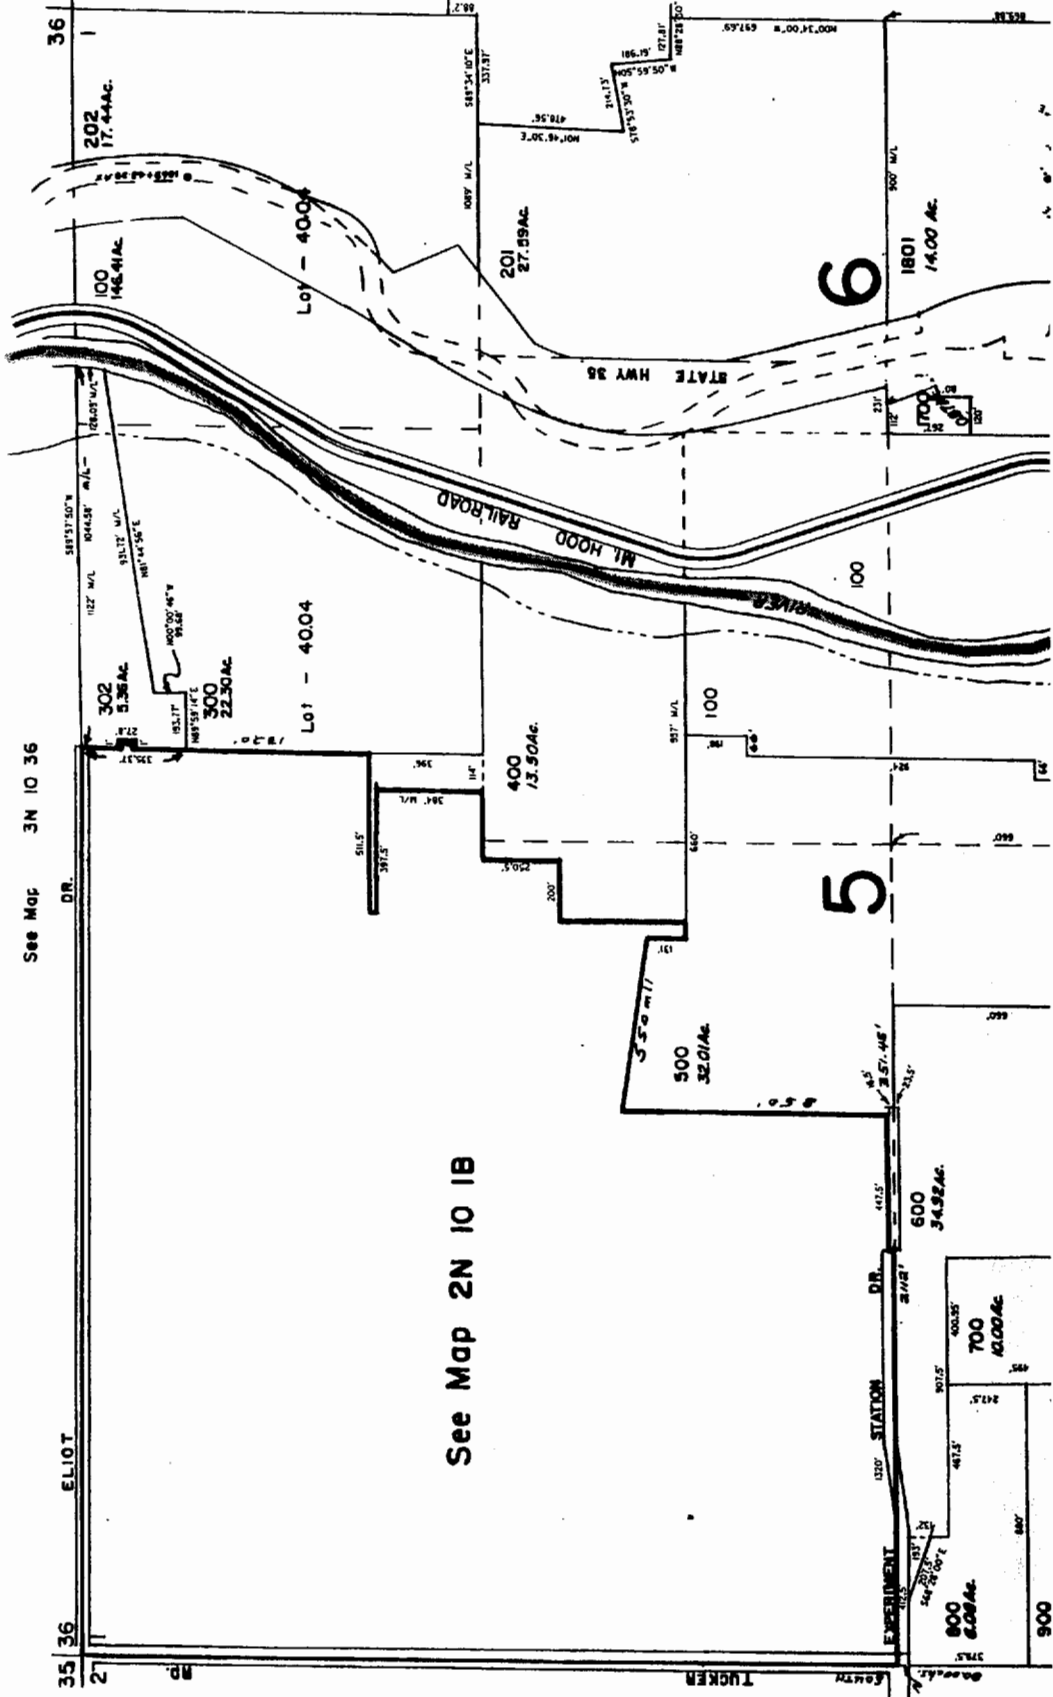


See Map 2N 10 2

See Map 2N 11 6

PARCEL  
 1. 5 247' 30" 30'  
 2. 5 147' 00" 30'  
 3. 5 224' 20" 30'  
 4. 5 047' 21" 30"  
 5. 5 047' 21" 30"  
 6. 5 047' 21" 30"

2N  
 11E

REVISED 9-26-96, LC

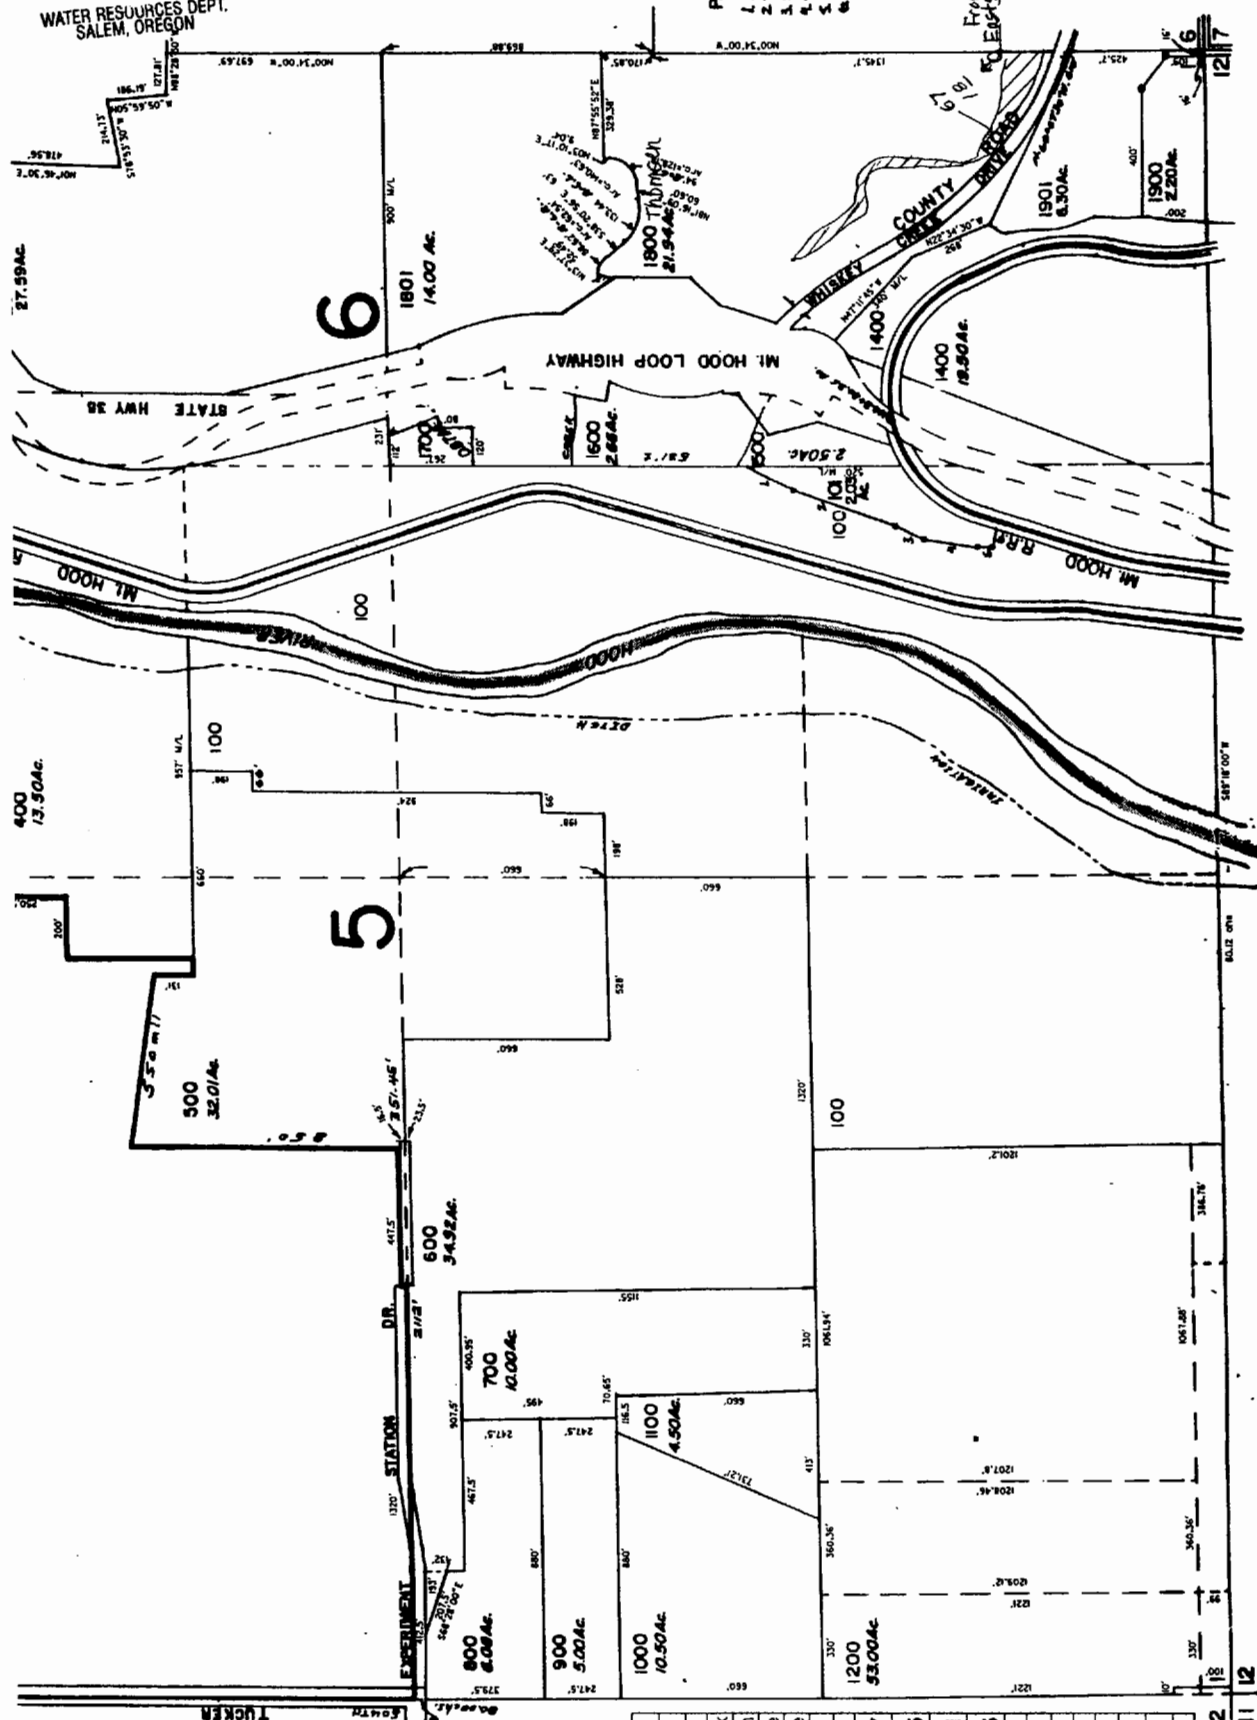

See Map 2N 10 2

See Map 2N 10 12

Map Legend	
Map Symbols	
Turnout Box	—
Open Ditch	---
Pipeline	---
Property Line	---
Water Right Certificate	
P - 26517	
P - 30825	
P - 32101	
P - 32685	
East Fork Irrigation District	
Hood River, Oregon	
Section 2N-10-01	
Scale 1" = 400 cms	

2 11 12

THIS MAP WAS PREPARED FOR  
ASSESSMENT PURPOSE ONLY

Hood River County  
1" = 200'

RECEIVED

JUN 03 2002


WATER RESOURCES DEPT.  
SALEM, OREGON

1/4 Cor.

See Map 2N 10 13

See Map 2N 10 13

PARCEL 301  
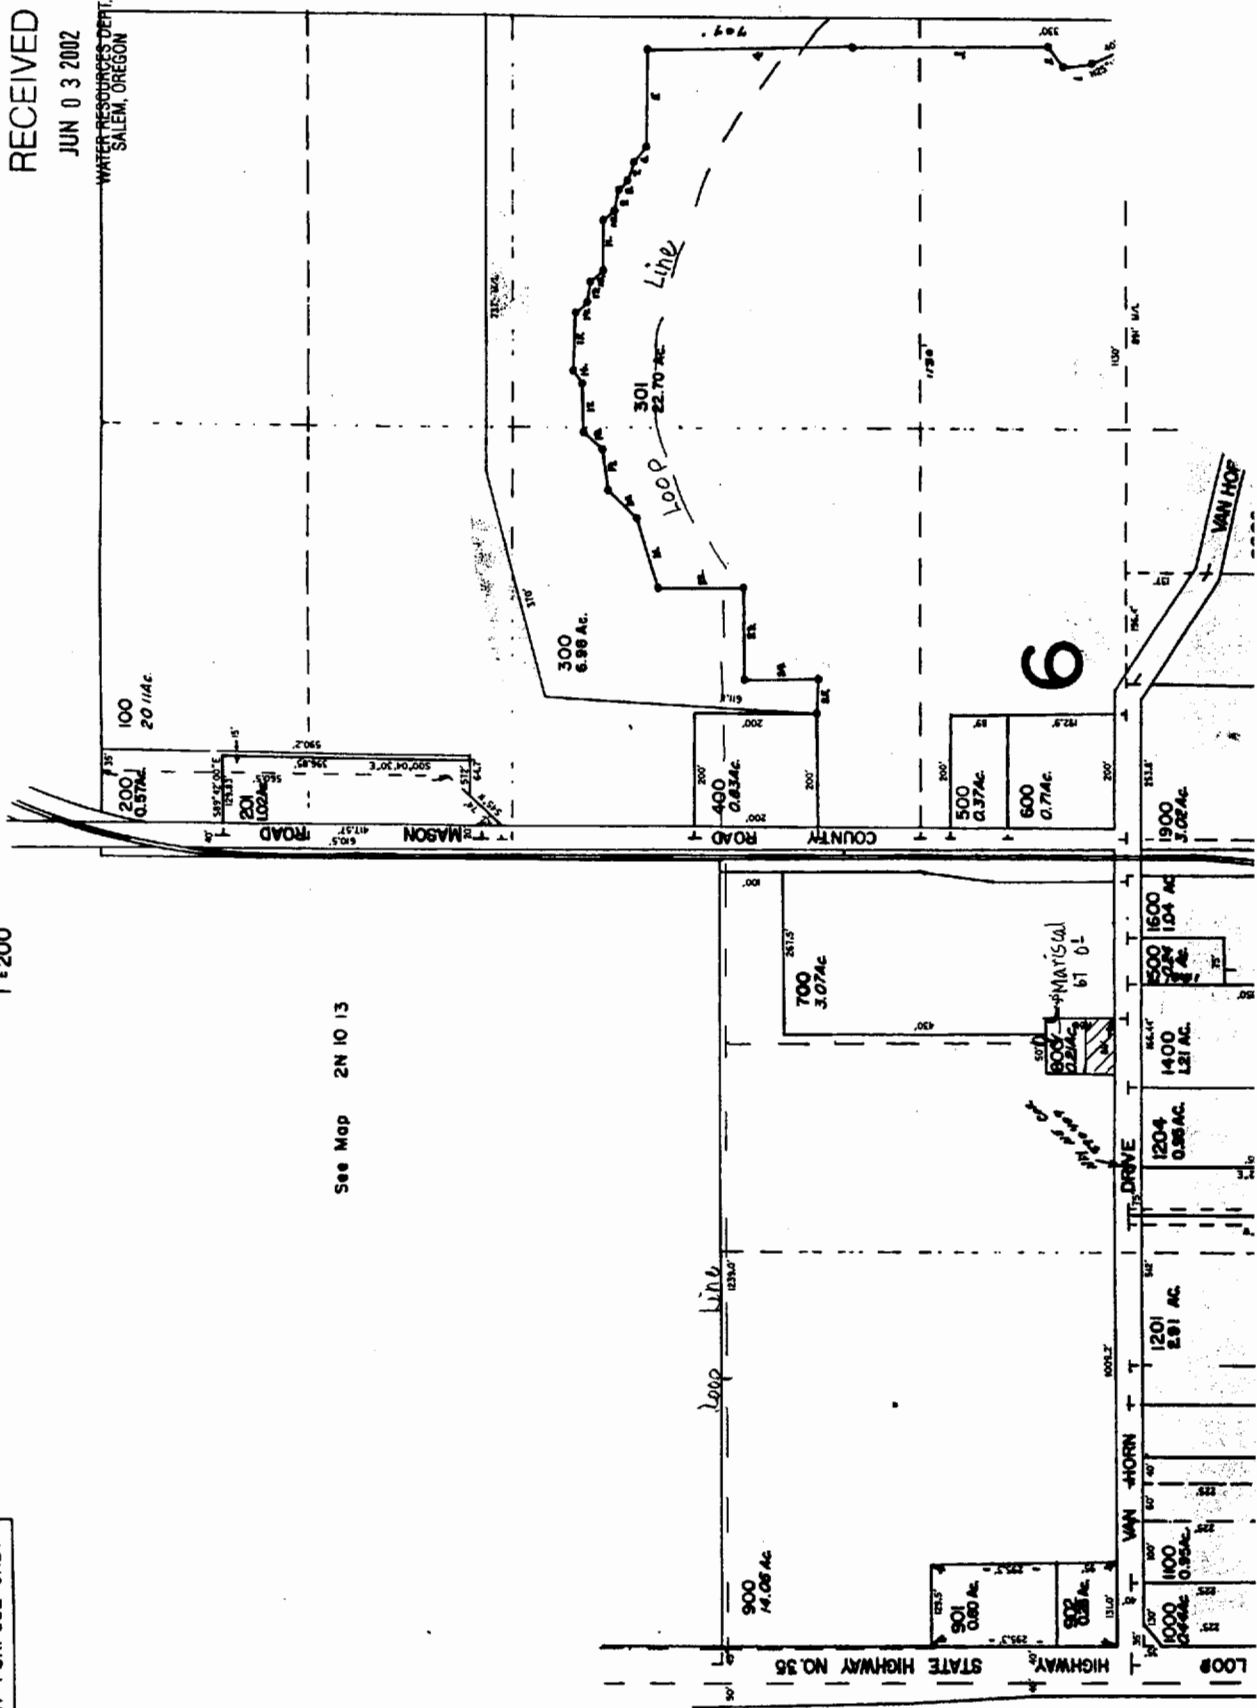

1" = 200'



Section 36 T2N R10E WM  
Hood River County

- Cancelled No's  
 501 3000 thru  
 502 4001  
 1101 1601  
 1602 3500  
 3500 3601  
 3601

RECEIVED  
 JUN 03 2002  
 WATER RESOURCES DEPT.  
 SALEM, OREGON

THIS MAP WAS PREPARED FOR  
 ASSESSMENT PURPOSE ONLY

1"=400'

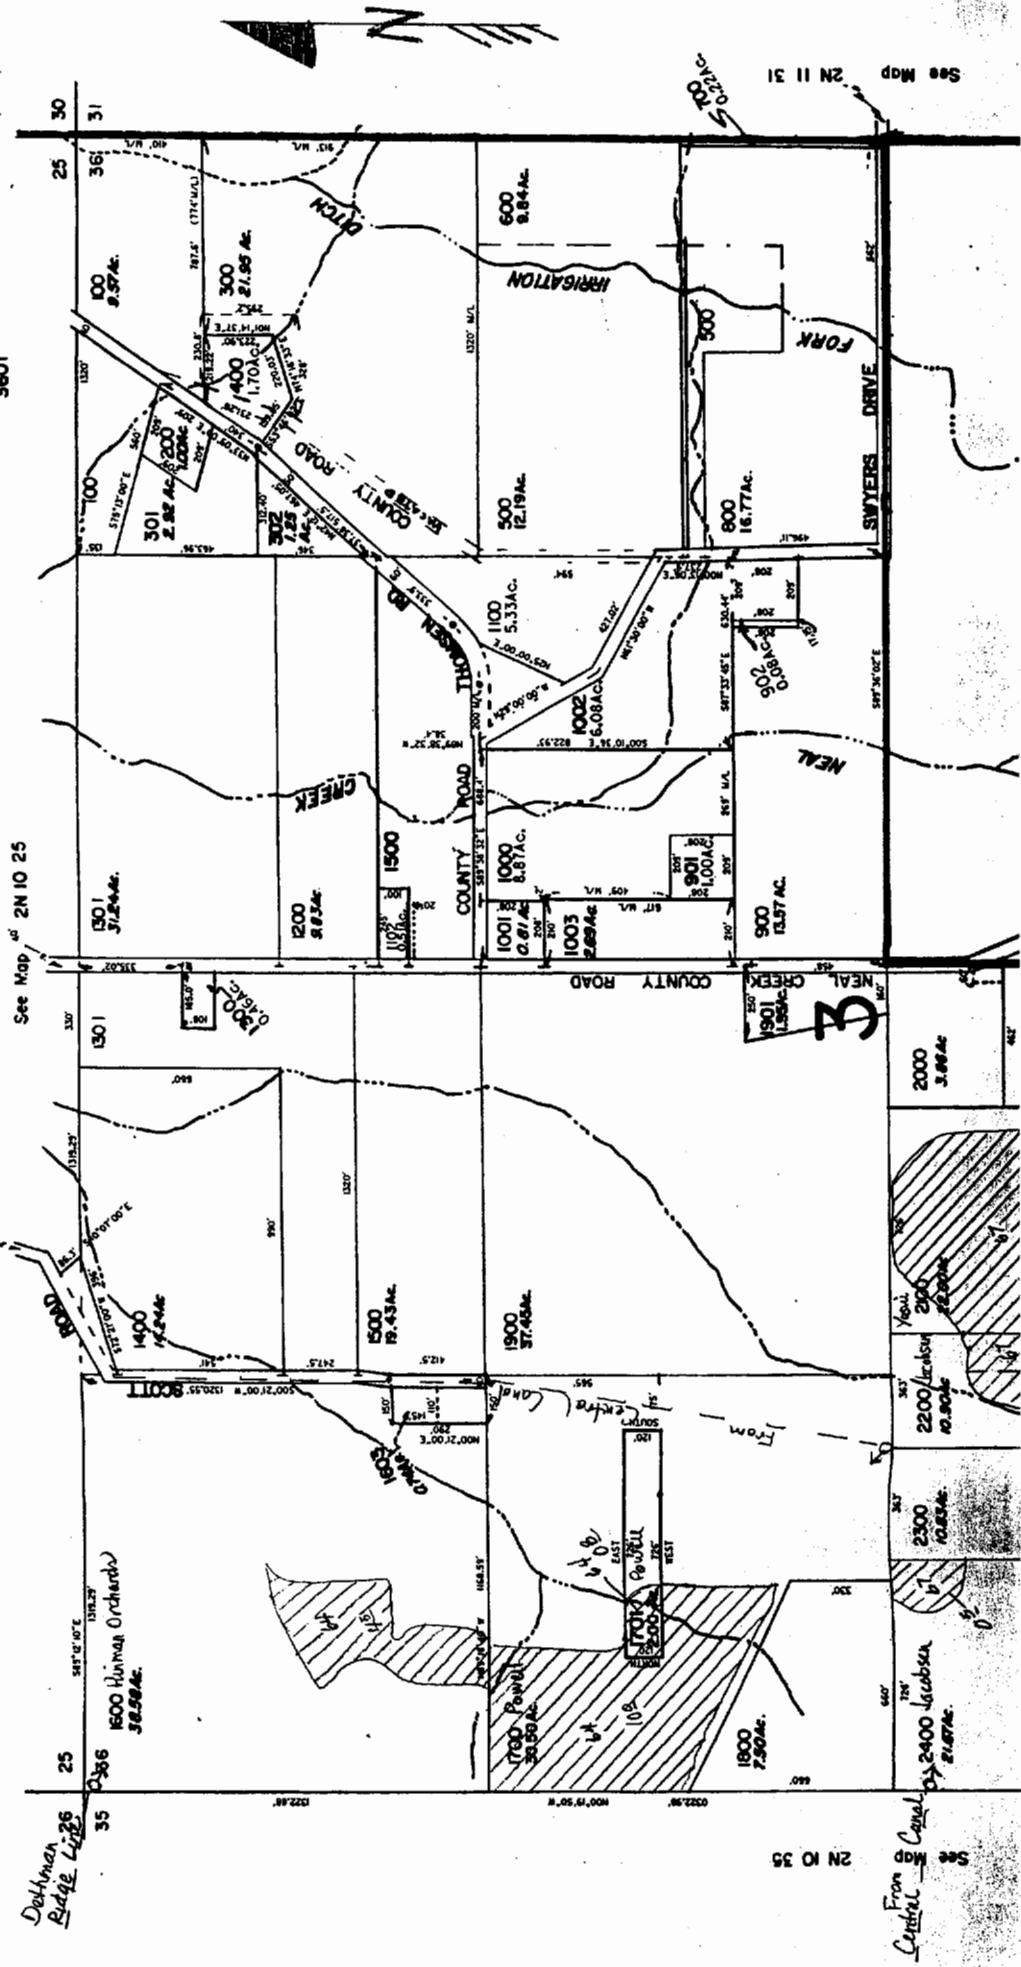

See Map 2N 10 35

From Central  
 Canal

See Map 2N 11 31


See Map 2N 10 25

Dekelman  
 Ridge Line

RECEIVED  
 JUN 03 2002  
 WATER RESOURCES DEPT.  
 SALEM, OREGON

Map Legend	
Map Symbols	
--- Turnout Box	
--- Open Ditch	
--- Pipeline	
--- Property Line	
Water Right Certificate	
P - 26517	
P - 30825	
P - 32101	
P - 32685	
East Fork Irrigation District Hood River, Oregon	
Section 2N-10-36	
Scale 1" = 400 cms	

2N 10 36  
 REVISED 10-4-96, LC

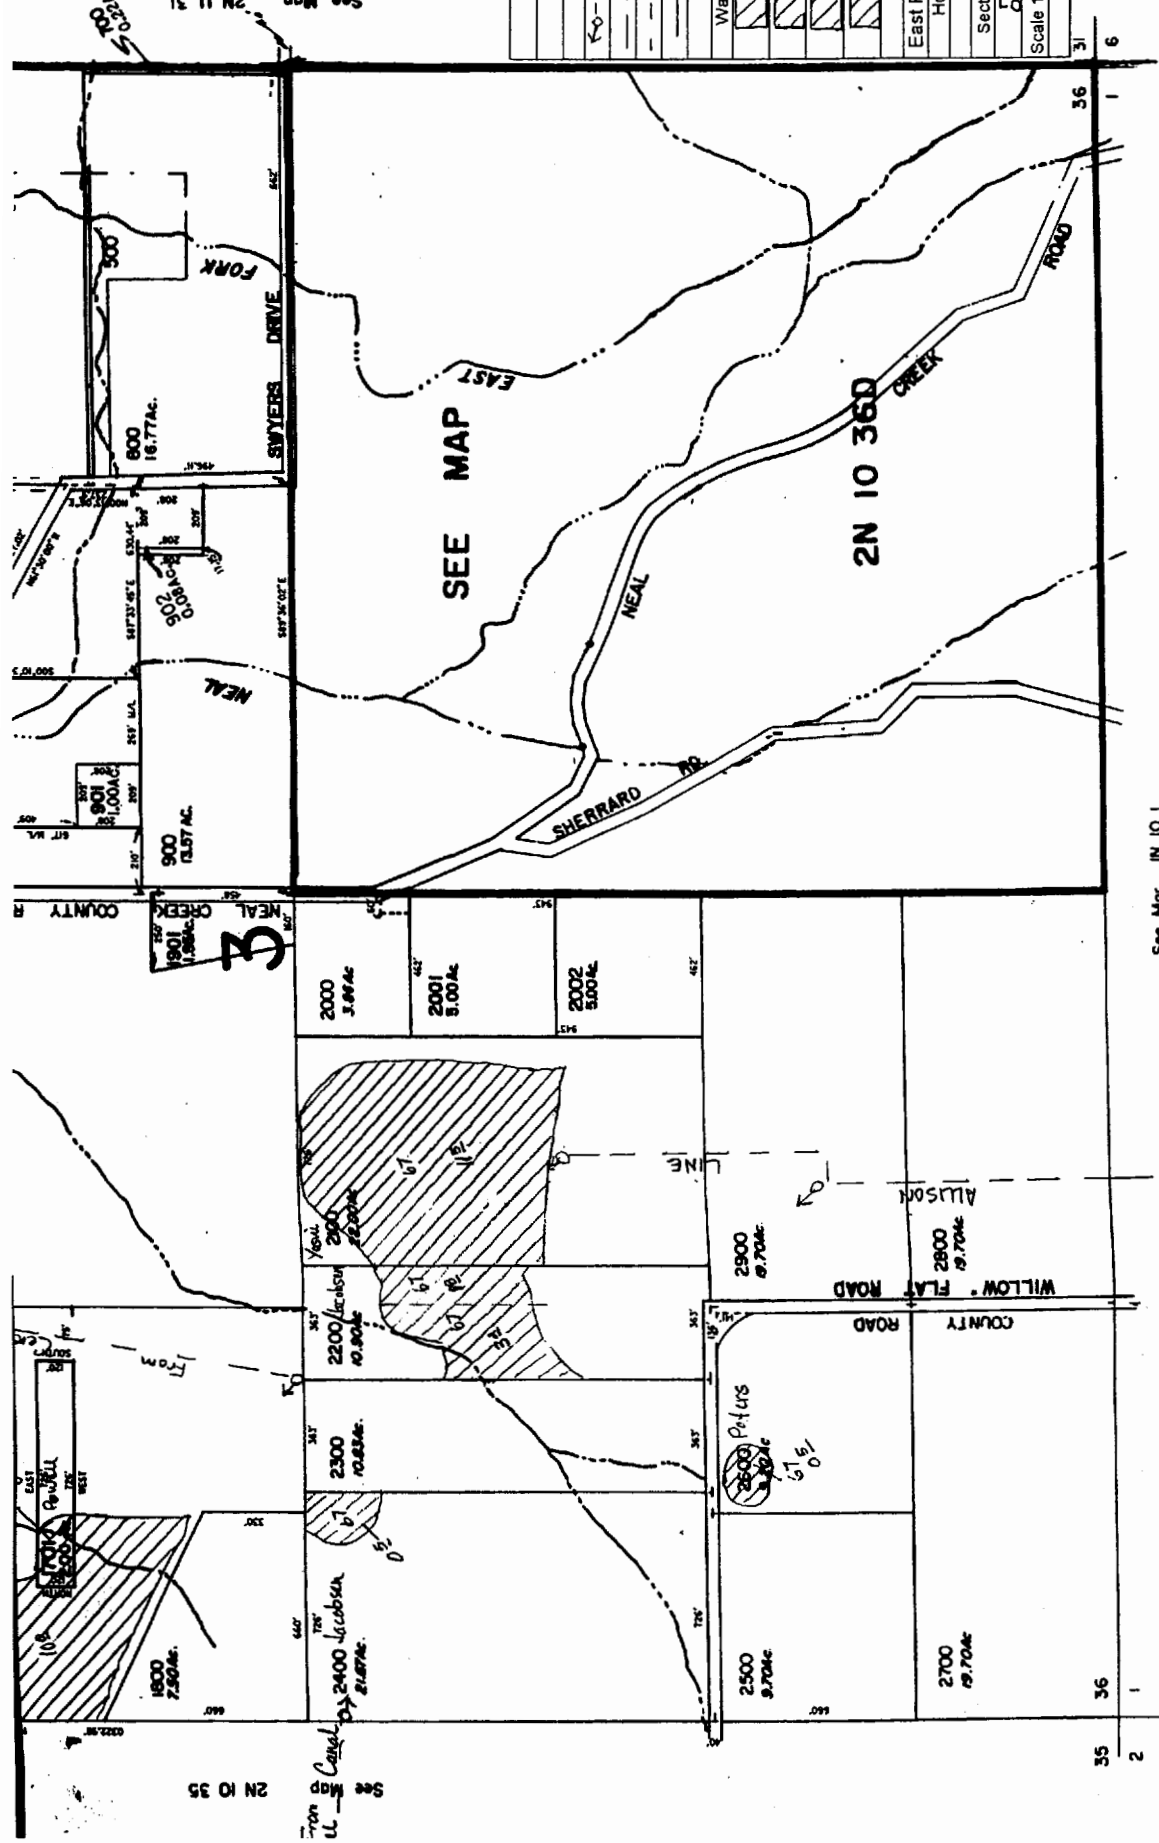

See Map 2N 10 35  
 U.L. Caryl

See Map IN 10 1