




8  
301  
34.6  
58°40' E

MAP 01N 11 06

Map Legend	
Map Symbols	
Turnout Box	—
Open Ditch	---
Pipeline	----
Property Line	---
Water Right Certificate	
64	P - 26517
66	P - 30825
66	P - 32101
67	P - 32685
East Fork Irrigation District Hood River, Oregon	
Section	1N-10-01
1	200 400
Scale 1" = 400 cms	

RECEIVED  
7 JUN 3 2002  
WATER RESOURCES DEPT.  
SALEM, OREGON

Re  
4/20/11

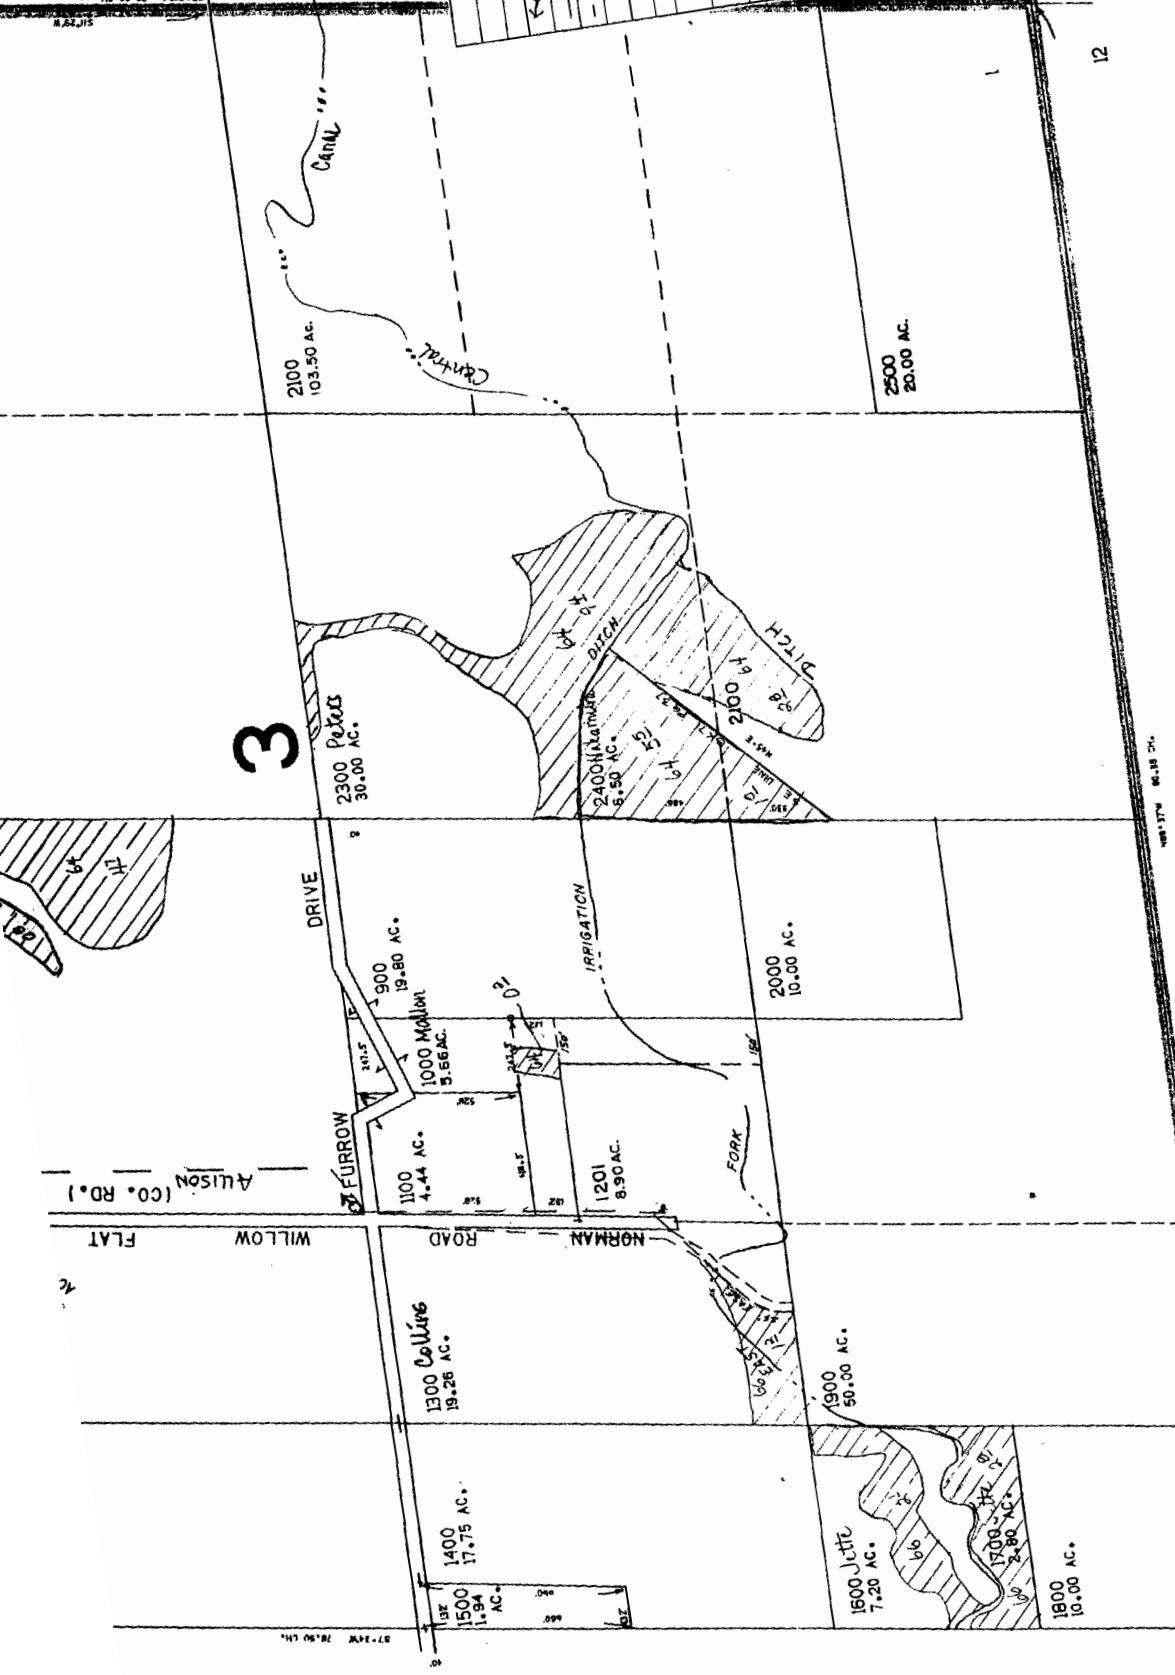

3

SEE MAP 01N 10 12

SEE MAP 01N 10 02

2

11


W

Application No. 39634  
Permit No. 29617  
Certificate No. 80929  
Map 3 of 72

SECTION 02 T.01N. R.10E. W.M.  
HOOD RIVER COUNTY

RECEIVED  
JUN 13 2002  
WATER RESOURCES DEPT.  
SALEM, OREGON

THIS MAP WAS PREPARED FOR  
ASSESSMENT PURPOSE ONLY

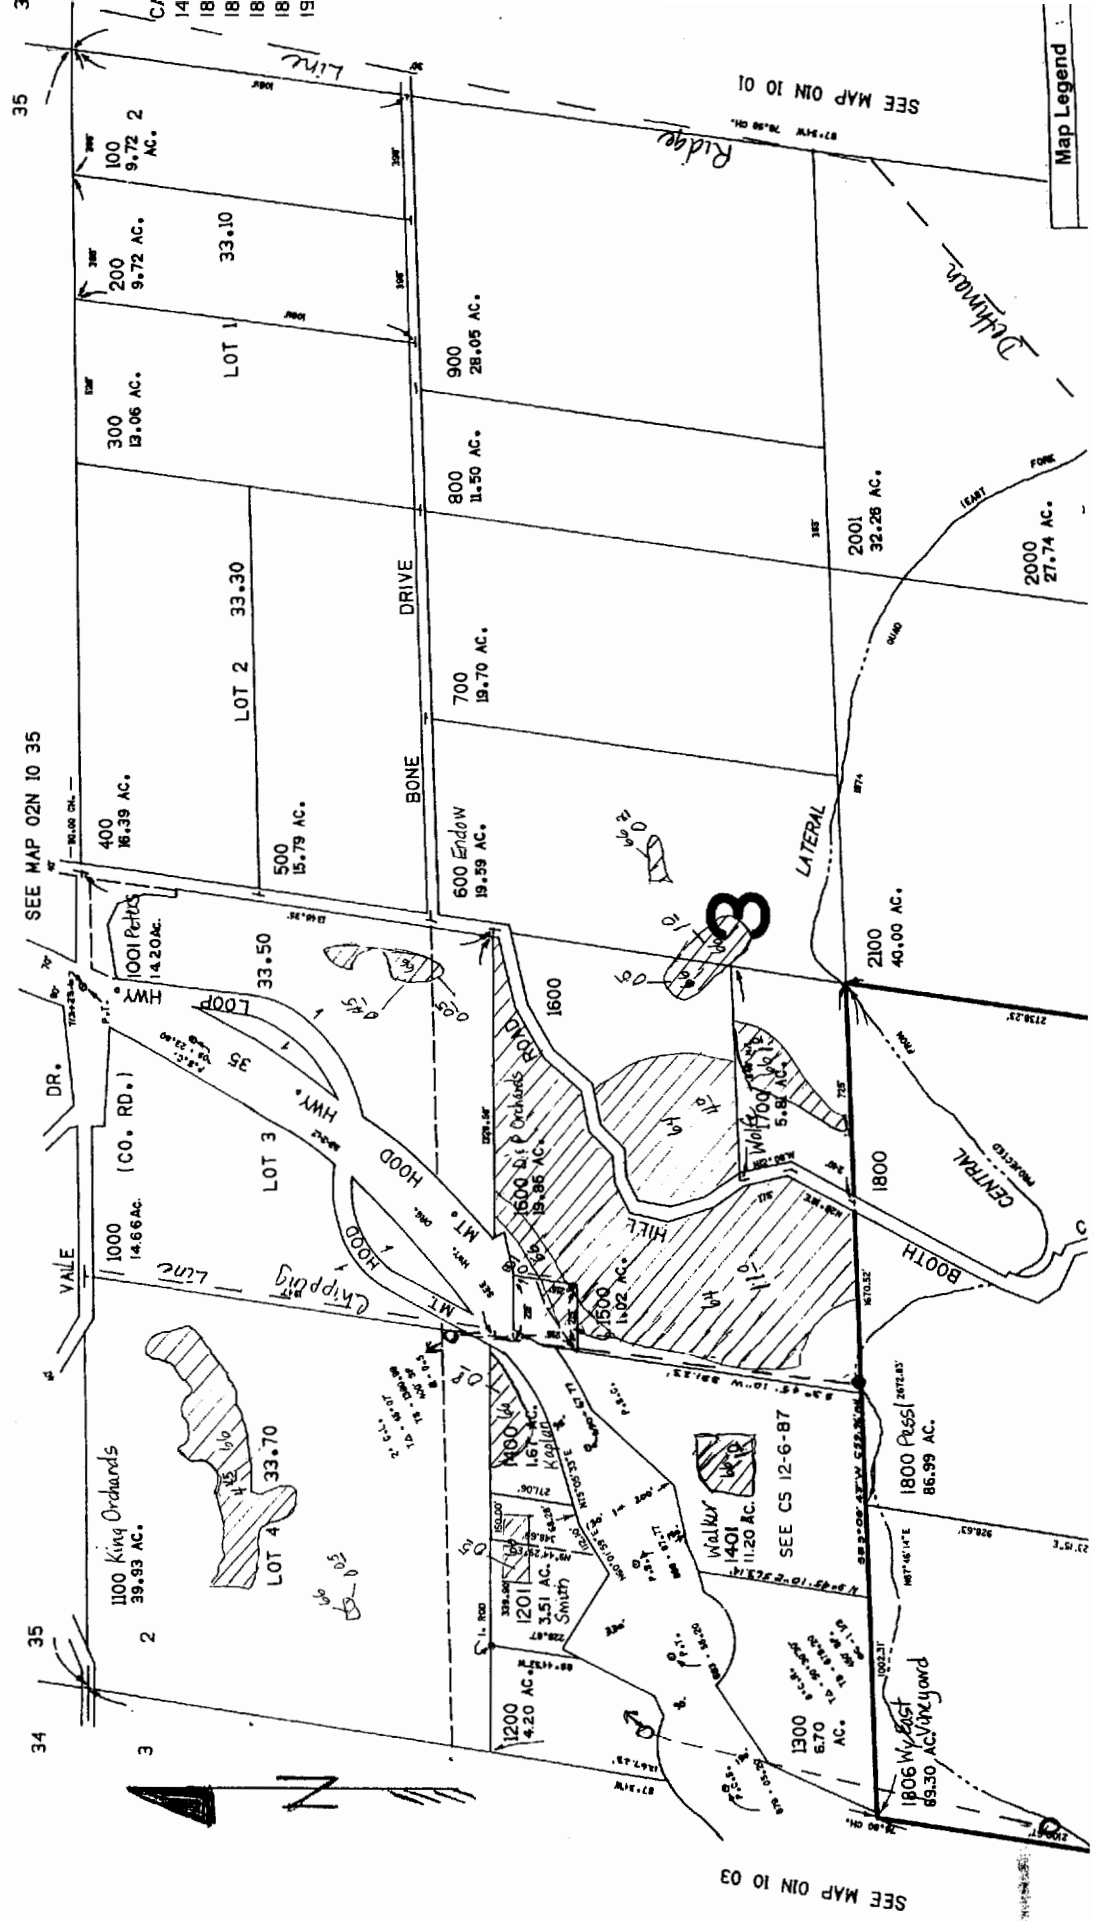

Map Legend

SEE MAP 01N 10 01

SEE MAP 01N 10 03

SEE MAP OIN 10 01

87.84' 78.80' CH.


Map Legend	
Map Symbols	
Turnout Box	—
Open Ditch	—
Pipeline	—
Property Line	—
Water Right Certificate	
	P - 26517
	P - 30825
	P - 32101
	P - 32685
East Fork Irrigation District Hood River, Oregon	
Section	1N-10-02
	400 400
Scale	1" = 400 cms

RECEIVED

JUN 03 2002  
WATER RESOURCES DEPT.  
SALEM, OREGON

12

11

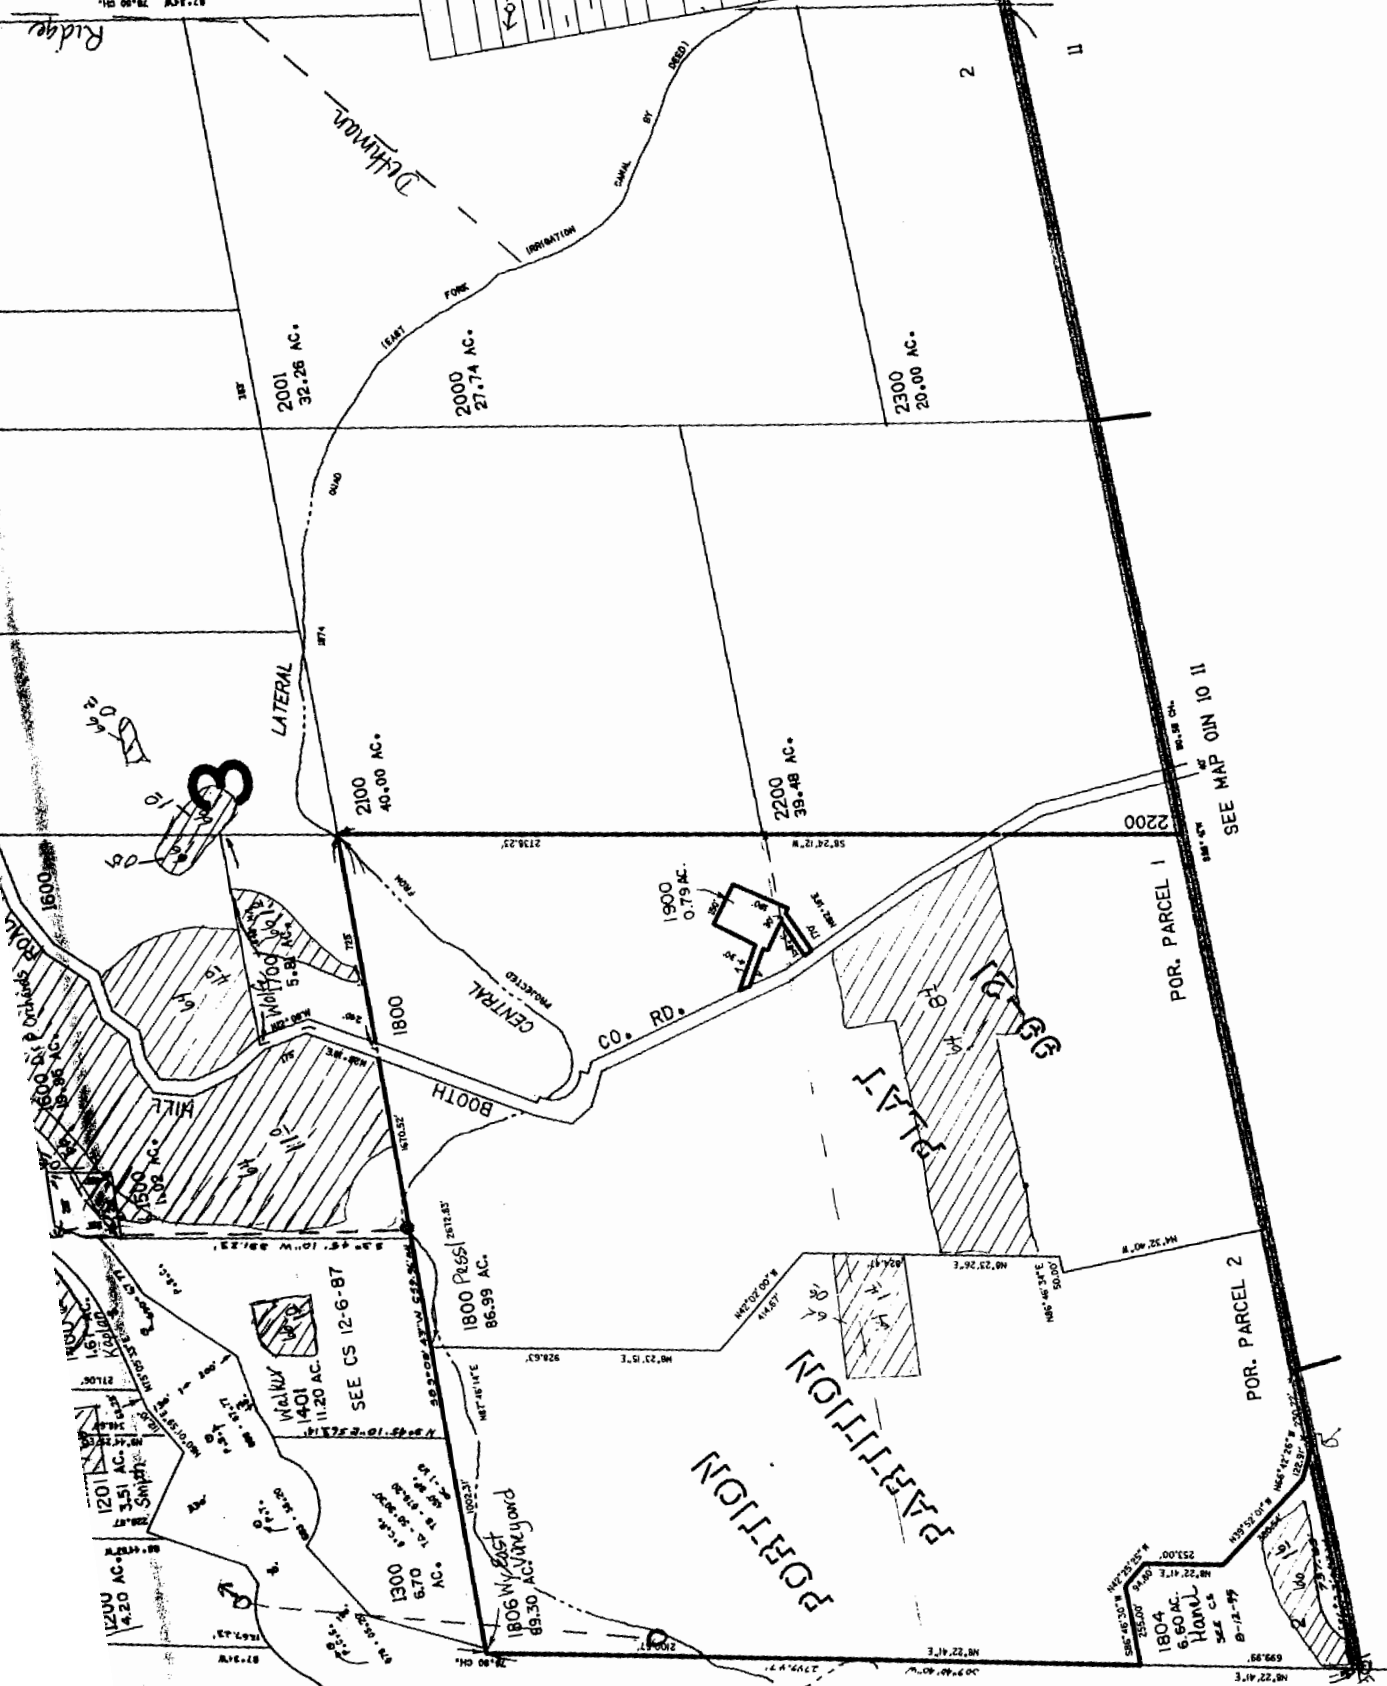

SEE MAP OIN 10 03

SEE MAP OIN 10 11

POR. PARCEL 1

POR. PARCEL 2


11



RECEIVED

JUN 3 2002  
WATER RESOURCES DEPT.  
SALEM, OREGON

Map Legend
Map Symbols
--- Turnout Box
--- Open Ditch
--- Pipeline
--- Property Line
Water Right Certificate
P - 26517
P - 30825
P - 32101
P - 32685
East Fork Irrigation District
Hood River, Oregon
Section 1N-10-03
Scale 1" = 400 cms

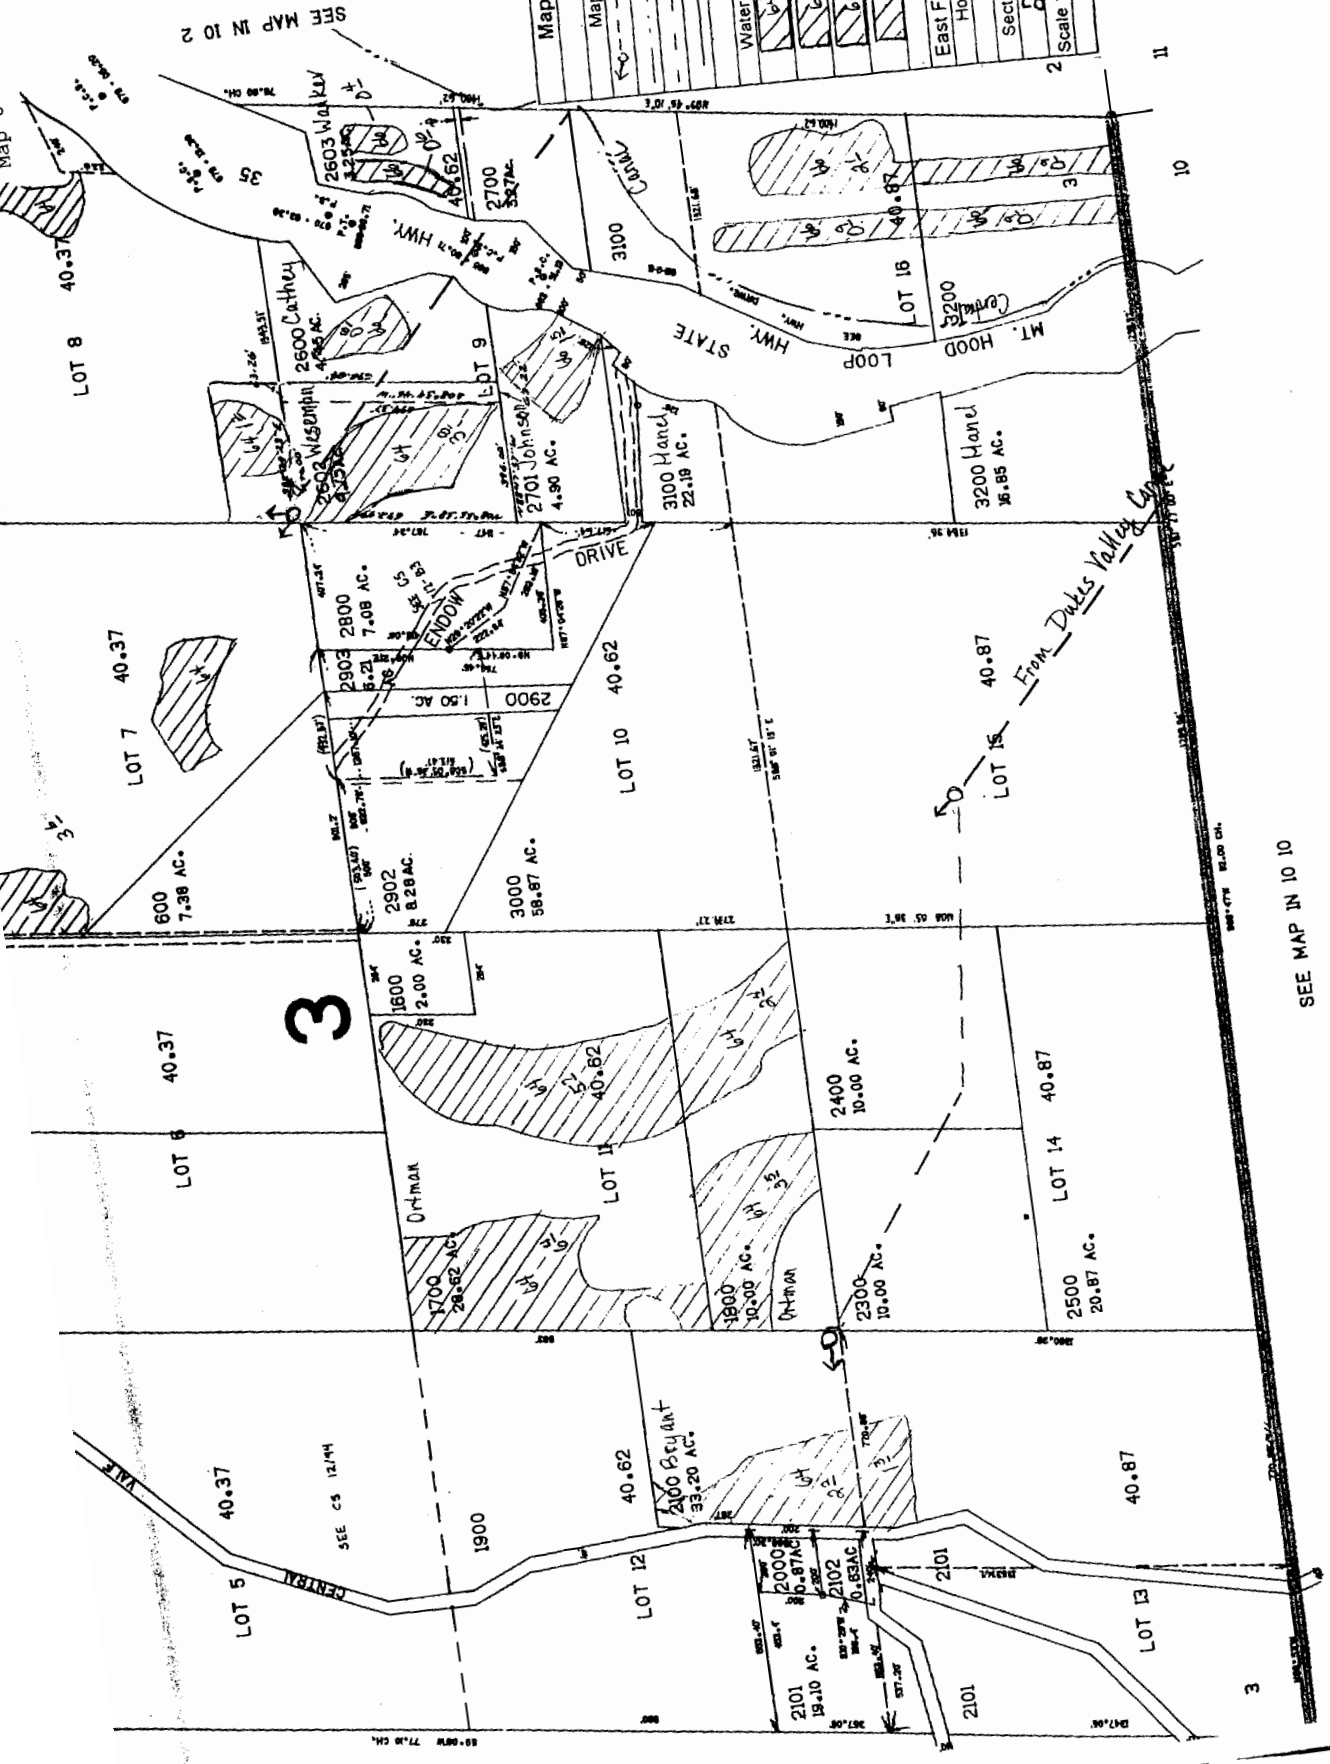

SEE MAP IN 10 2

SEE MAP IN 10 4

SEE MAP IN 10 10

SE1/4 SEC. 10 T.1N. R.10E. W.M.  
HOOD RIVER COUNTY

1"=200'


RECEIVED

JUN 03 2002

WATER RESOURCES DEPT.  
SALEM, OREGON

SEE MAP IN 10 10

THIS MAP WAS PREPARED FOR  
ASSESSMENT PURPOSE ONLY

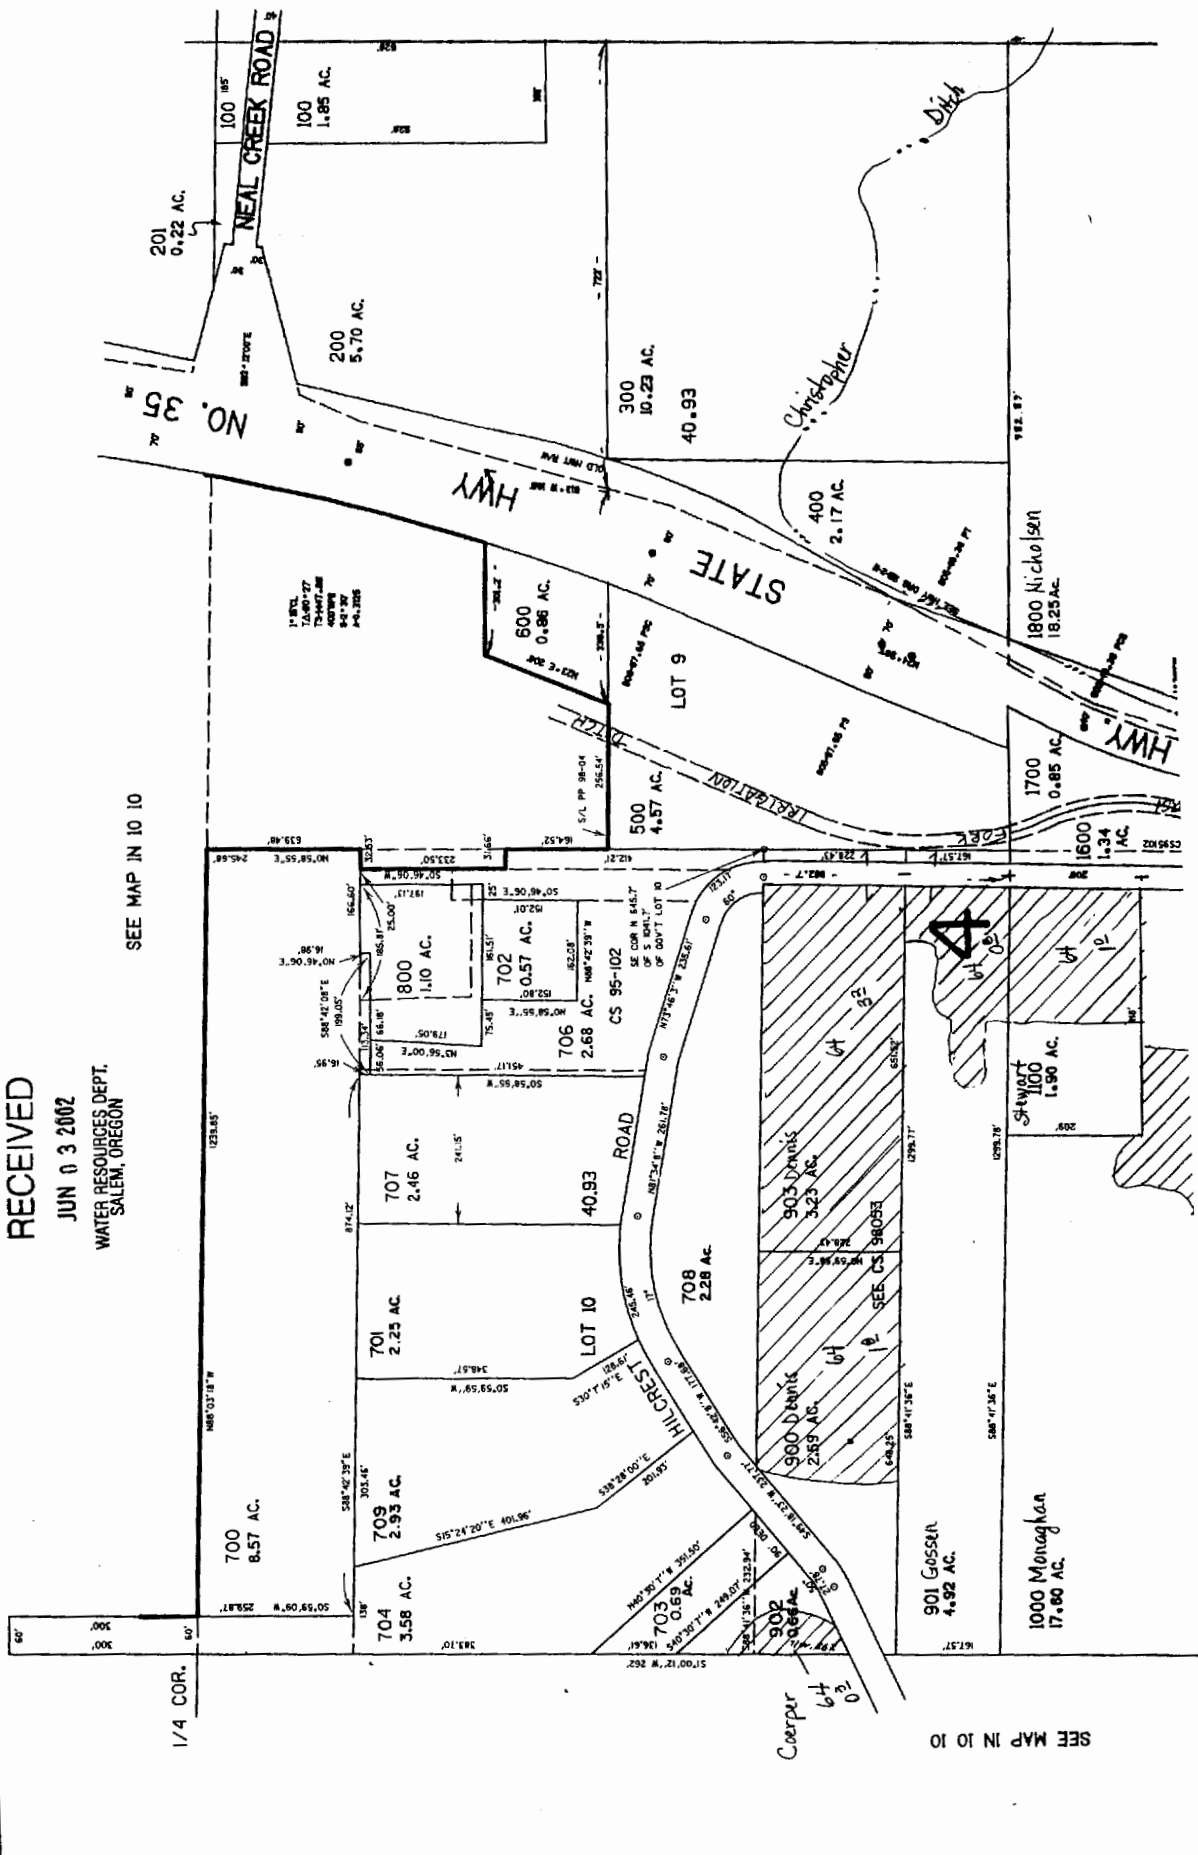

SEE MAP IN 10 10





Application No. 39634  
 Permit No. 29617  
 Certificate No. 80929  
 Map 9 of 72


SECTION 11 T.01N. R.10E. W.M.  
 HOOD RIVER COUNTY

THIS MAP WAS PREPARED FOR  
 ASSESSMENT PURPOSE ONLY

RECEIVED

JUN 03 2002  
 WATER RESOURCES DEPT.  
 SALEM, OREGON

1"-400'

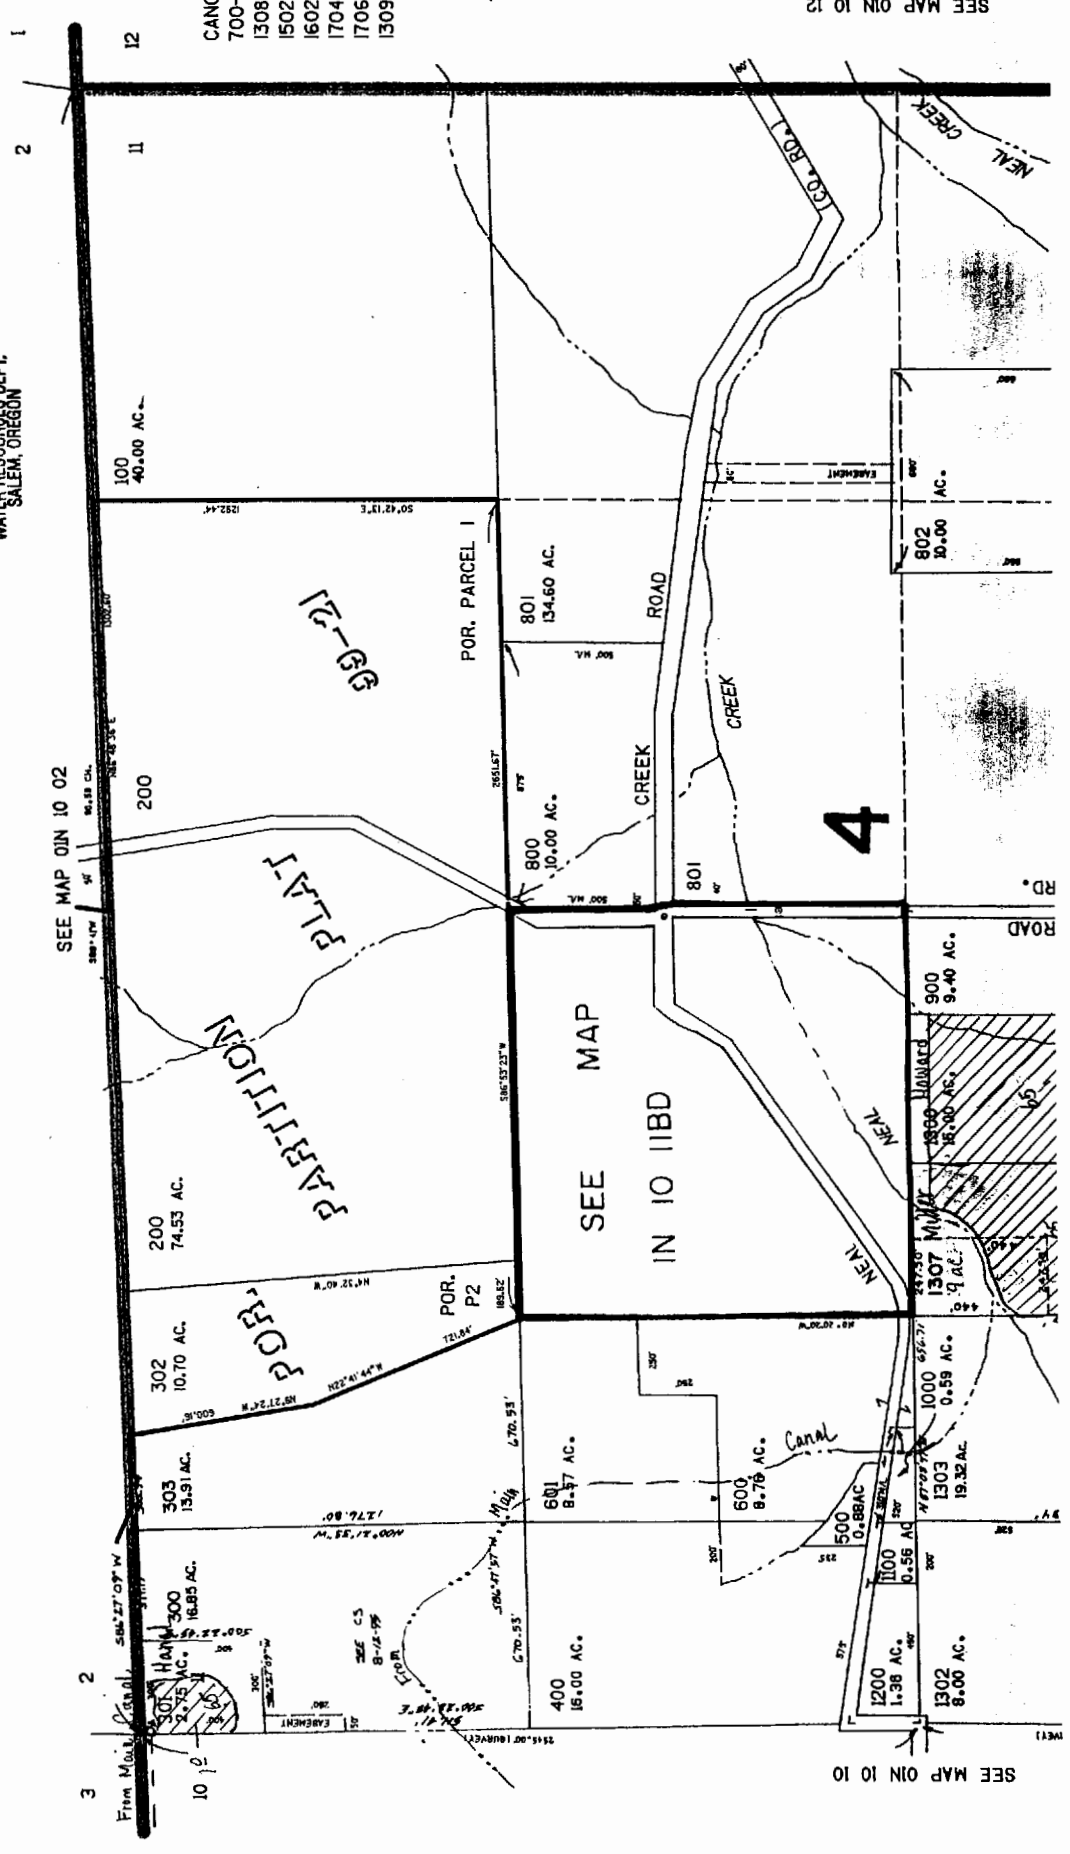

SEE MAP ON 10 12

SEE MAP ON 10 10


CANCE  
 700-7  
 1308  
 1502  
 1602  
 1704  
 1706  
 1309

Application No. 39634  
 Permit No. 29617  
 Certificate No. 80929  
 Map 10 of 72

SEE MAP OIN 10 12

RECEIVED  
 JUN 03 2002  
 WATER RESOURCES DEPT.  
 SALEM, OREGON

Map Legend	
Map Symbols	
	Turnout Box
	Open Ditch
	Pipeline
	Property Line
Water Right Certificate	
	P - 26517
	P - 30825
	P - 32101
	P - 32685
East Fork Irrigation District Hood River, Oregon	
Section 1N-10-11	
Scale 1" = 400 cms	

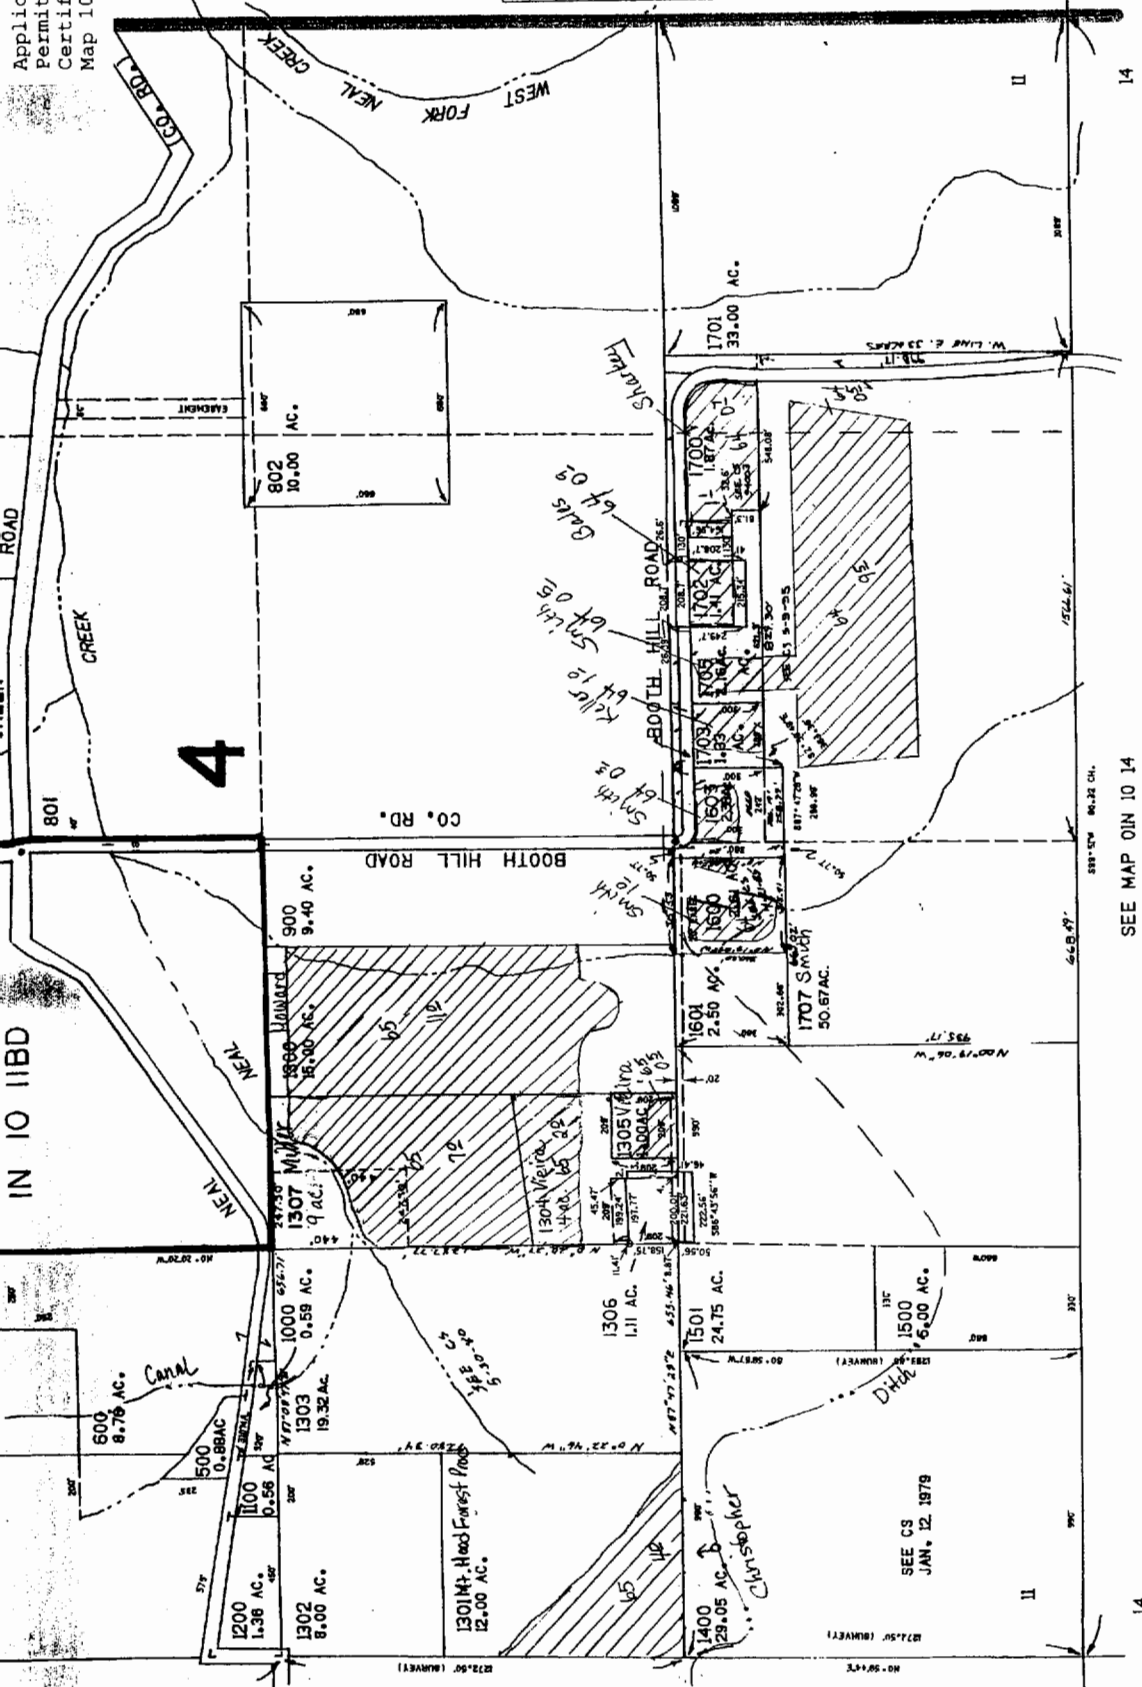

SEE MAP OIN 10 10

SEE MAP OIN 10 14

10 15

14 14

13

14

OIN 10

Revised 12/2/99, JD

SEE CS  

Christopher

1301 Mt. Hood Forest Road

Canal

Ditch


Booth Hill Road

NEAL CREEK

NEAL CREEK

Application No. 39634  
 Permit No. 29617  
 Certificate No. 80929  
 Map 12 of 72

IN 10 15A

LOT 5 40.84

LOT 6 40.84

LOT 9 40.80

LOT 10 40.80

LOT 12 40.80

LOT 14 40.76

LOT 16 40.76

LOT 15

LOT 16

Application No. 39634  
 Permit No. 29617  
 Certificate No. 80929  
 Map 14 of 72

PLAT 11-13  
 81-13

LOT 1 40.88  
 40.88

LOT 2 40.88  
 40.88

LOT 3 1500  
 1.03 AC.

LOT 4 1200  
 0.14 AC.

LOT 5 1500  
 1.03 AC.

LOT 6 1800  
 0.96 AC.

LOT 7 2500  
 6.20 AC.

LOT 8 2600  
 0.46 AC.

LOT 9 2700  
 4.94 AC.

LOT 10 2800  
 2.50 AC.

LOT 11 3000  
 4.89 AC.

LOT 12 3200  
 0.21 AC.

LOT 13 3100  
 12.56 AC.

LOT 14 2400  
 3.44 AC.

LOT 15 2300  
 1.00 AC.

LOT 16 2900  
 2.89 AC.

LOT 17 2200  
 20.90 AC.





































































































































































































THIS MAP WAS PREPARED FOR  
ASSESSMENT PURPOSE ONLY


SECTION 22 T.01N. R.10E. W.M.  
HOOD RIVER COUNTY

Application No. 39634  
Permit No. 29617  
Certificate No. 80929  
Map 15 of 72  
JUN 0

RECEIVED  
WATER RESOURCES DEPT.  
SALEM, OREGON

1"-400'

SEE MAP O1N 10 15  
SEE MAP O1N 10 21  
SEE MAP O1N 10 22

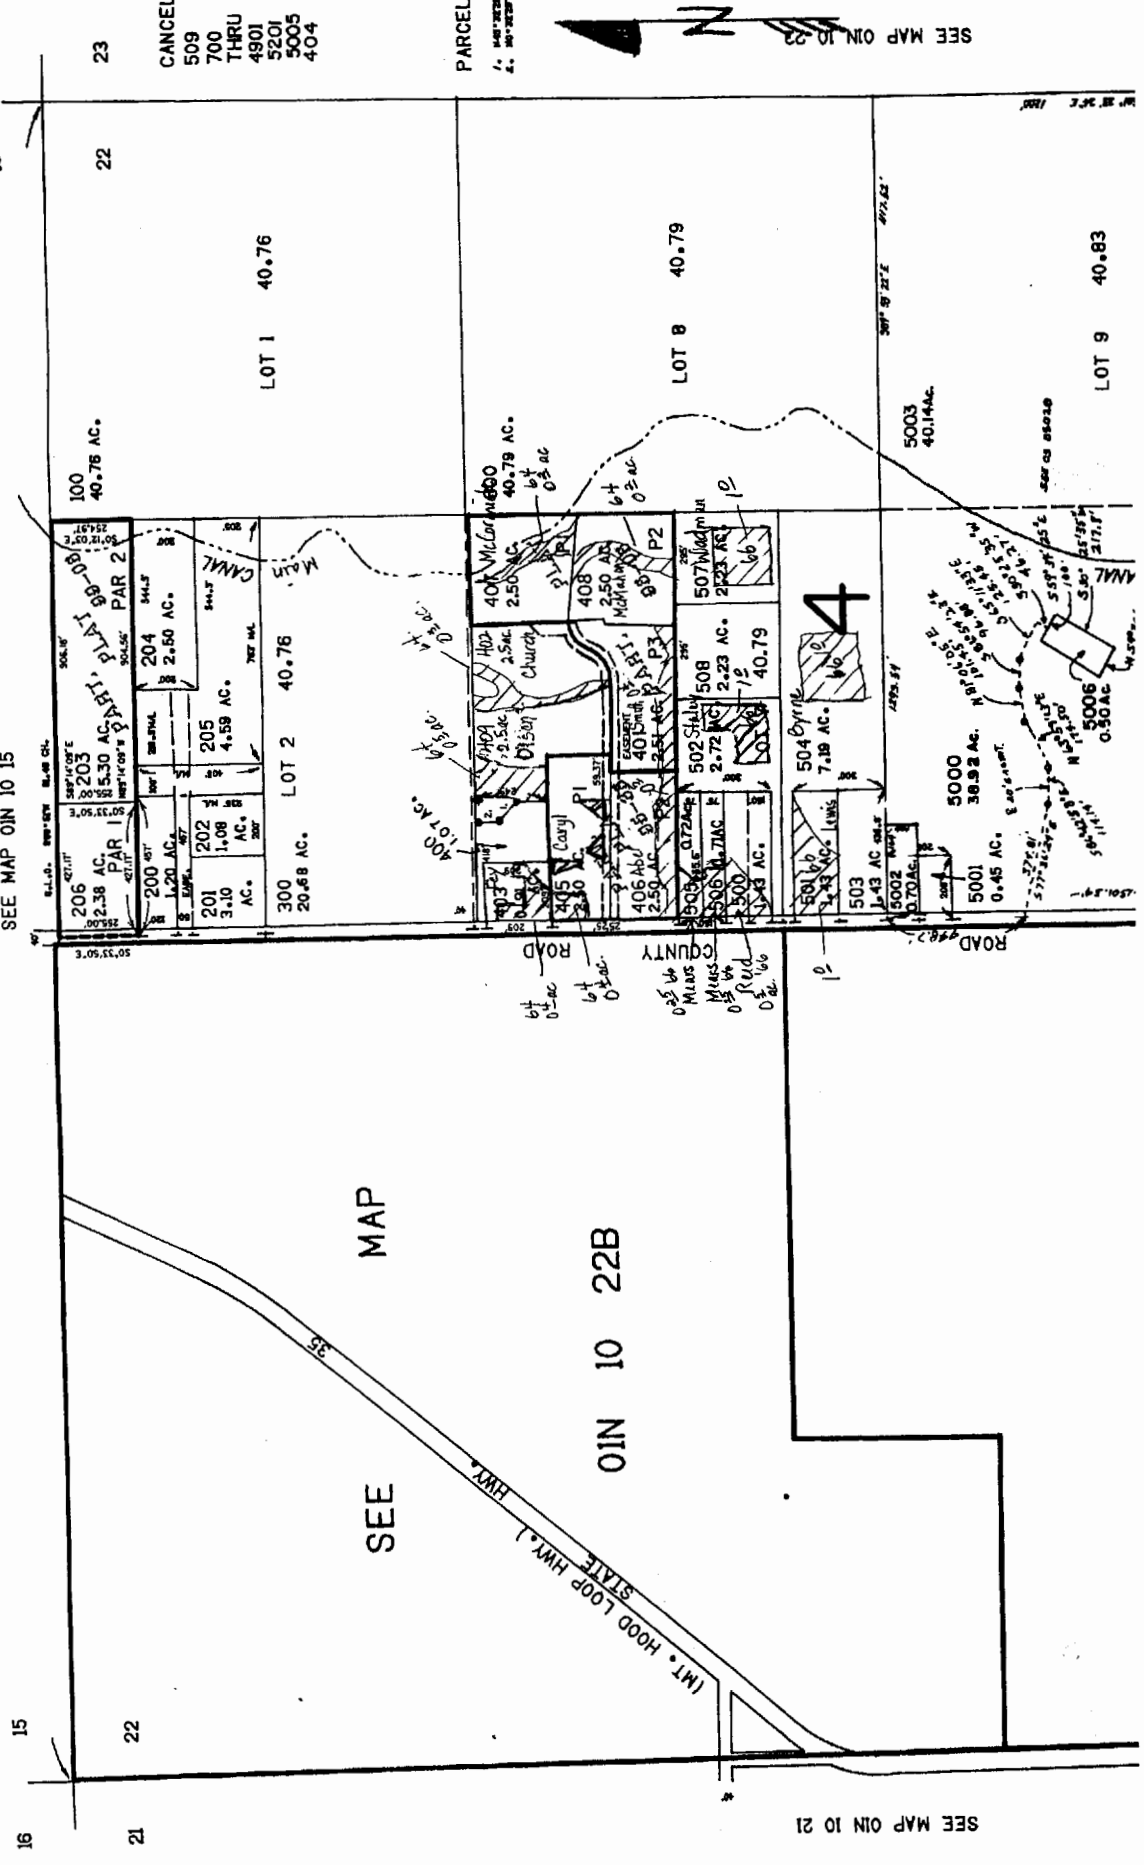

WATER RESOURCES DEPT.  
SALEM, OREGON

SEE MAP O1N 10 22

PARCEL

1. HOOD RIVER COUNTY  
2. HOOD RIVER COUNTY

CANCELLED  
509  
700  
THRU  
4901  
5201  
5005  
404








Application No. 39634  
 Permit No. 29617  
 Certificate No. 80929  
 Map 18 of 72

SEE MAP IN IO 2

RECEIVED  
 JUN 03 2002  
 WATER RESOURCES DEPT.  
 SALEM, OREGON

Map Legend	
Map Symbols	
	Turnout Box
	Open Ditch
	Pipeline
	Property Line
Water Right Certificate	
	P - 26517
	P - 30825
	P - 32101
	P - 32685
East Fork Irrigation District Hood River, Oregon	
Section 1N-10-22B	
Scale 1" = 800' cms	

Revised  
 3/20/01, JD  
 IN IO 22B

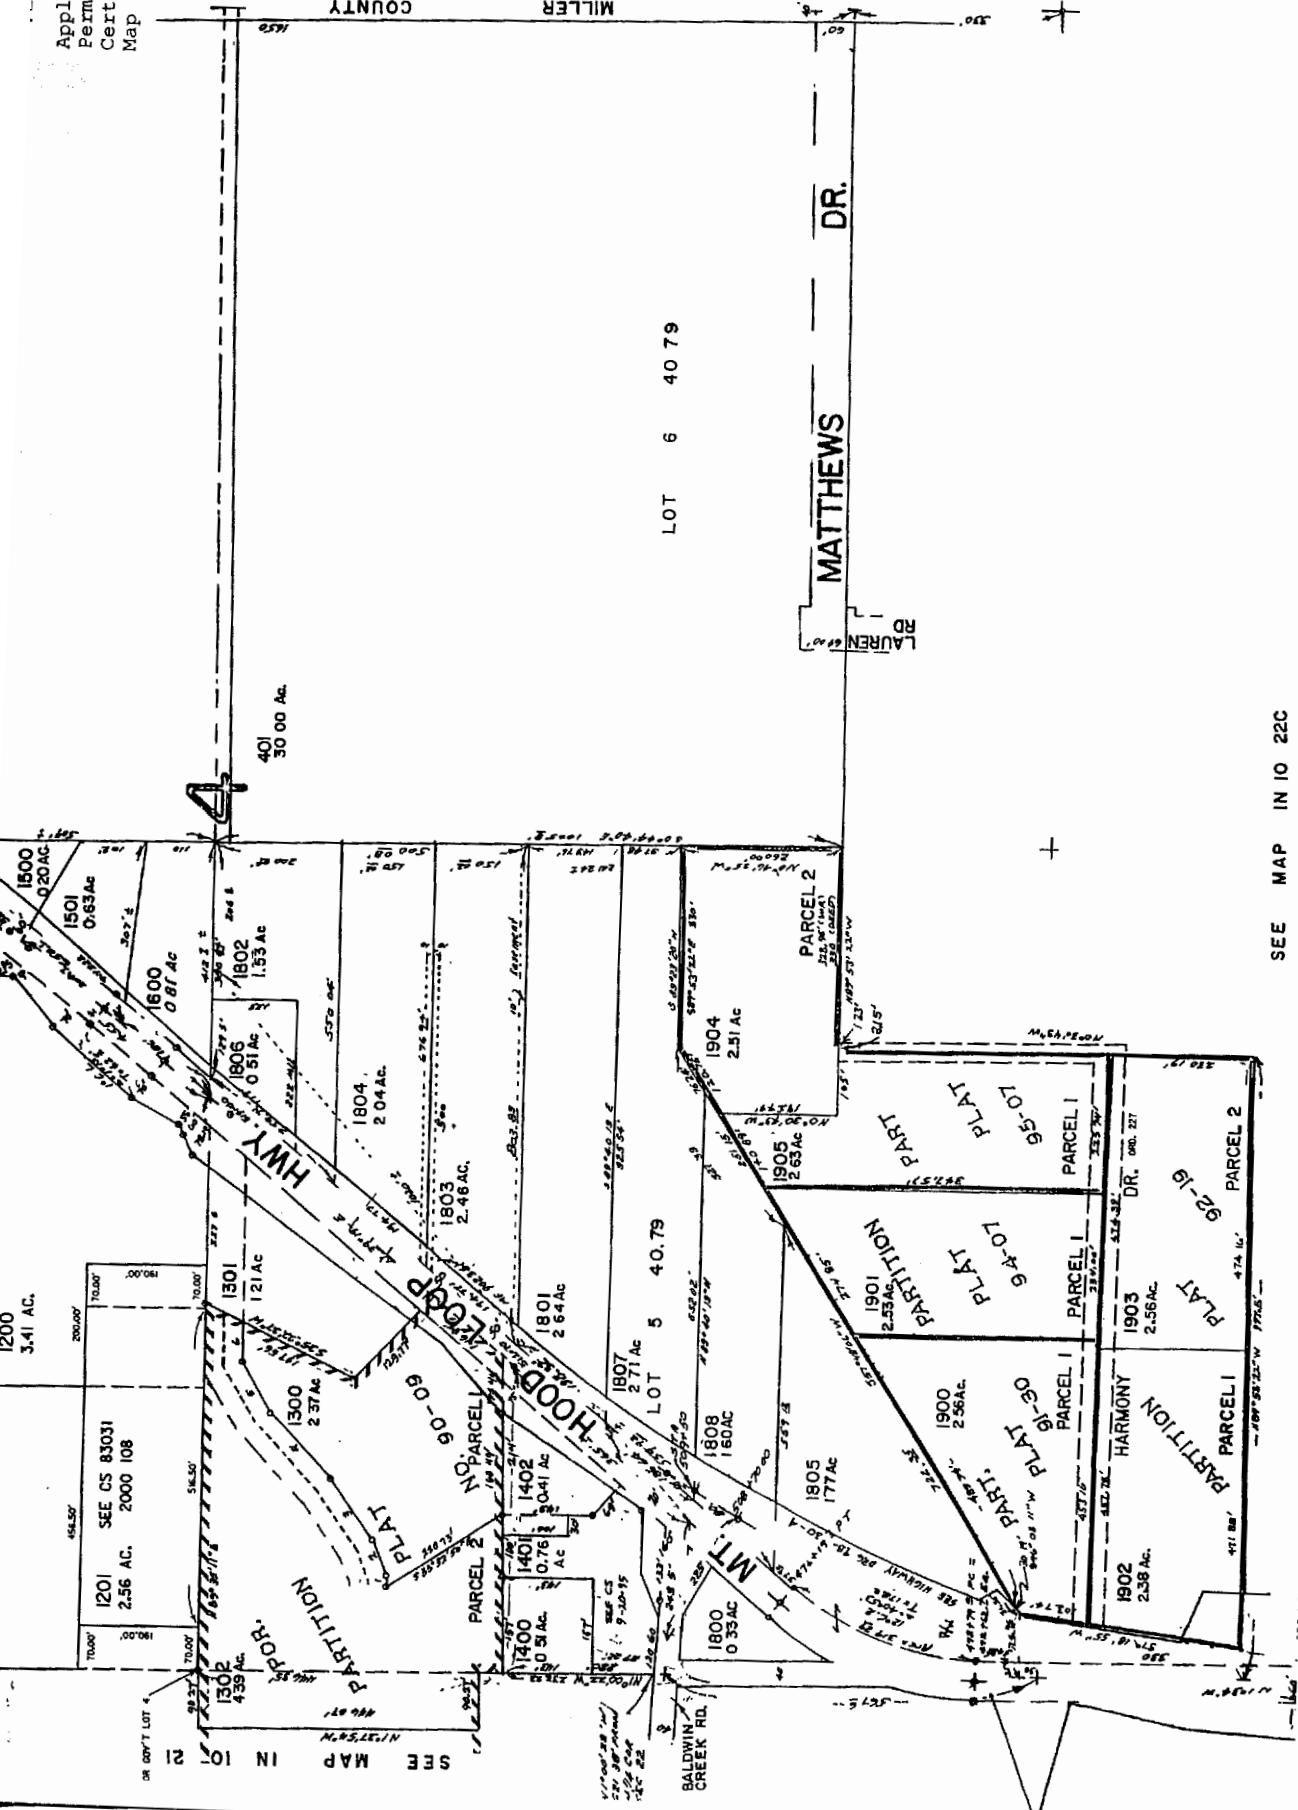

LOT 6 40 79

LOT 5 40 79

SEE MAP IN IO 22C


**SECTION 34T IN RICE WM  
HOOD RIVER COUNTY**

1" = 400'

Application No. 39634  
Permit No. 29617  
Certificate No. 80929  
Map 19 of 72

**RECEIVED**  
JUN 03 2002  
WATER RESOURCES DEPT.  
SALEM, OREGON


THIS MAP WAS PREPARED FOR  
ASSESSMENT PURPOSE ONLY

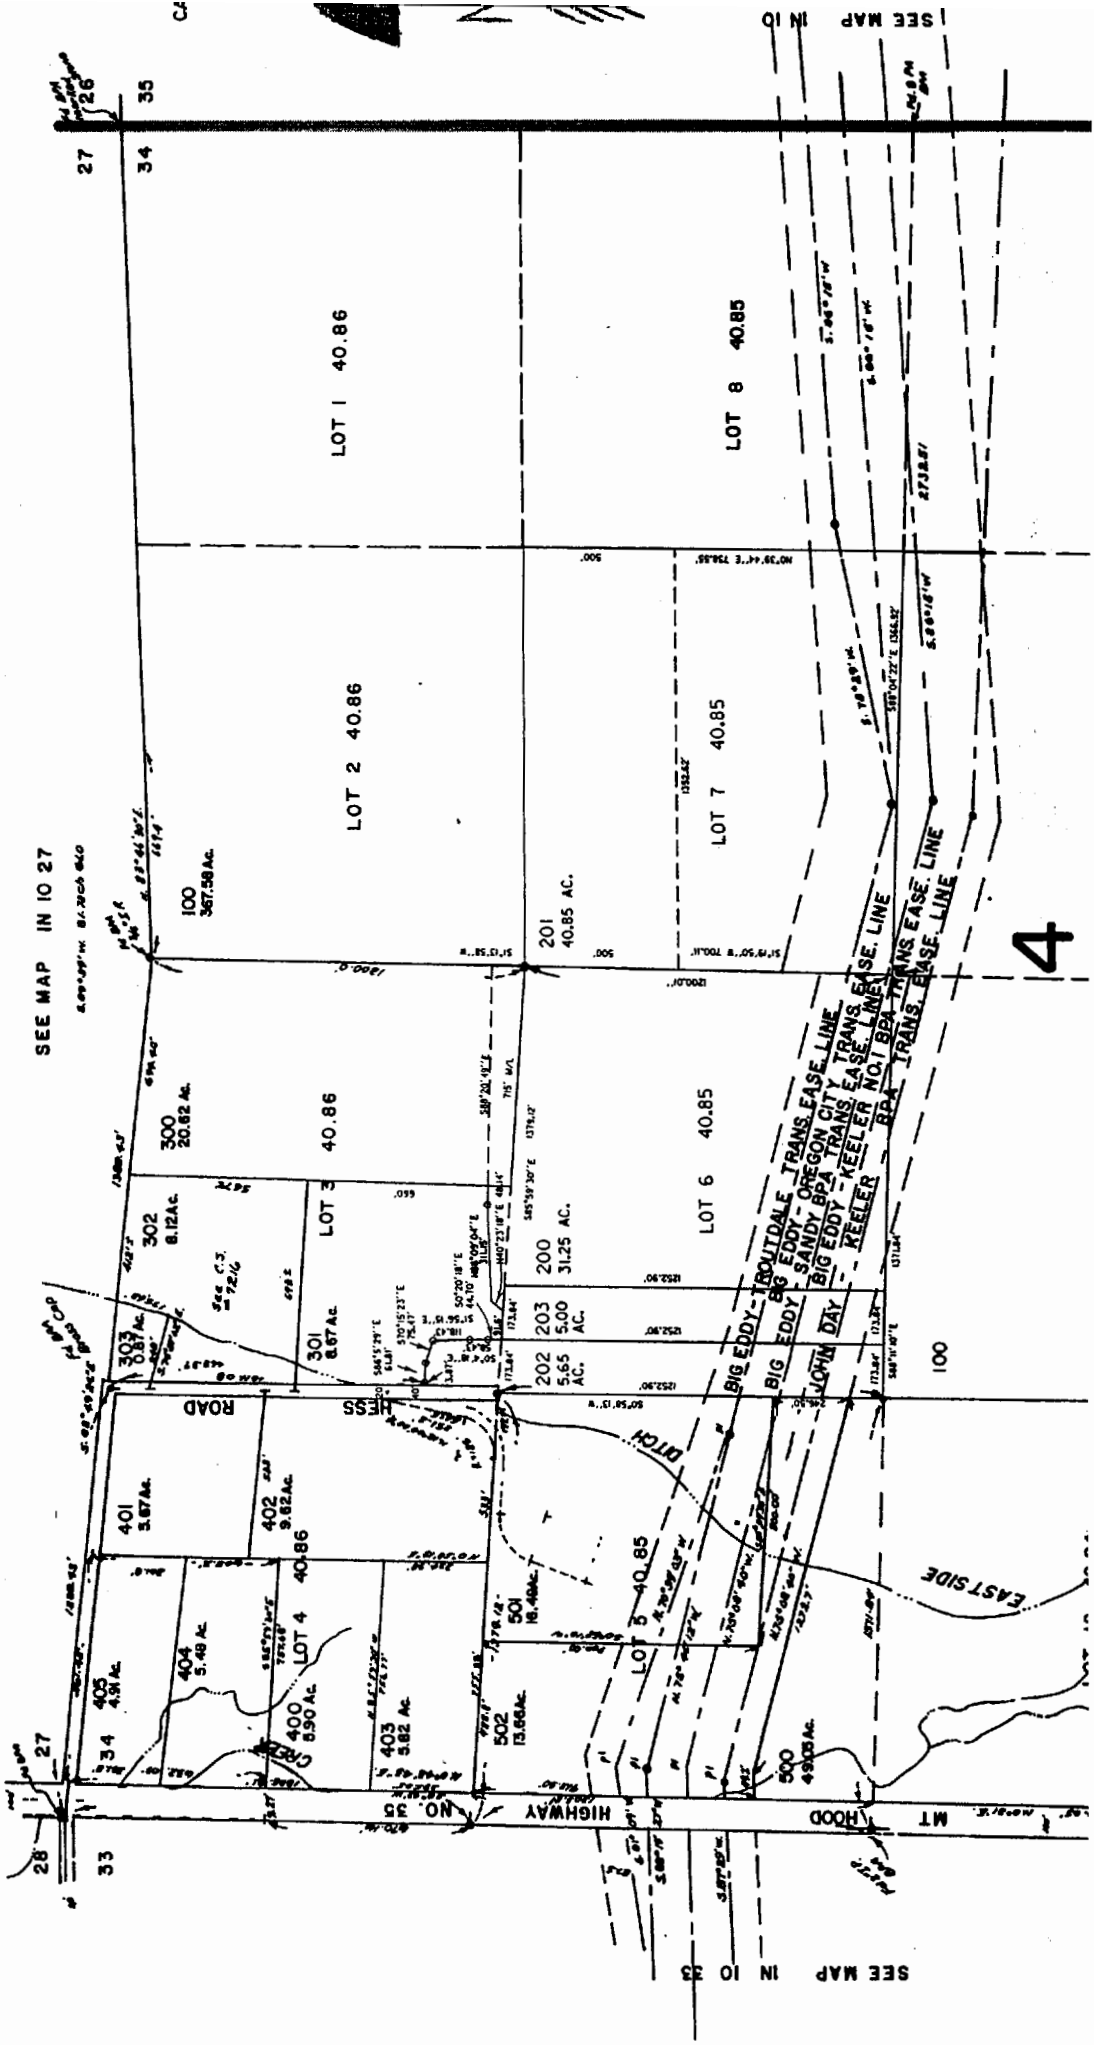

Application No. 39634  
 Permit No. 29617  
 Certificate No. 80929  
 Map 20 of 72

RECEIVED  
 JUN 03 2002  
 WATER RESOURCES DEPT.  
 SALEM, OREGON

Map Legend	
Map Symbols	
	Turnout Box
	Open Ditch
	Pipeline
	Property Line
Water Right Certificate	
	P - 26517
	P - 30825
	P - 32101
	P - 32685
East Fork Irrigation District Hood River, Oregon	
Section 1N-10-34	
	Scale 1" = 400 cms

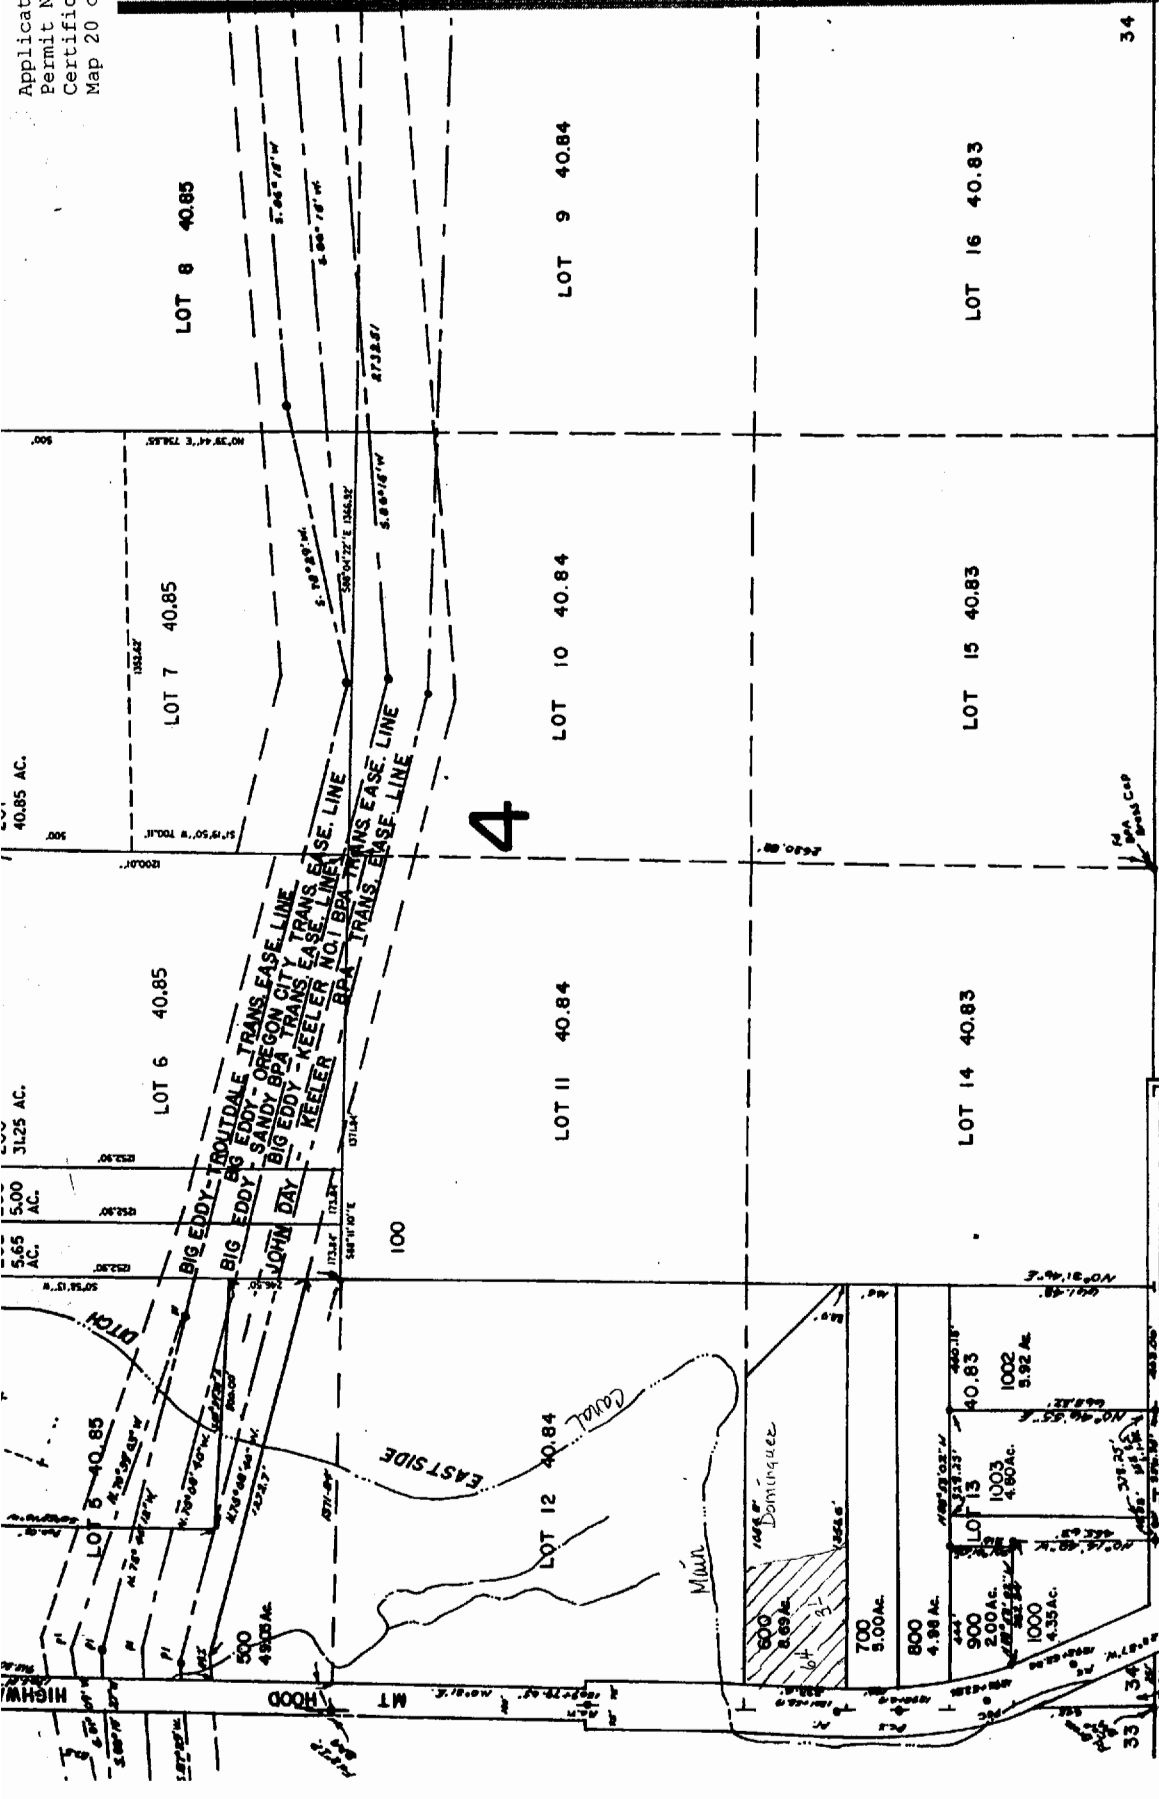

SEE MAP 15 10

IN 10 34  
 REVISED 5-8-96


Application No. 39634  
 Permit No. 29617  
 Certificate No. 80929  
 Map 21 of 72

JUN 03 2002  
 WATER RESOURCES DEPT.  
 SALEM, OREGON

Section 12 T2N R10E WM  
 Hood River County

1"=400'

THIS MAP WAS PREPARED FOR  
 ASSESSMENT PURPOSE ONLY


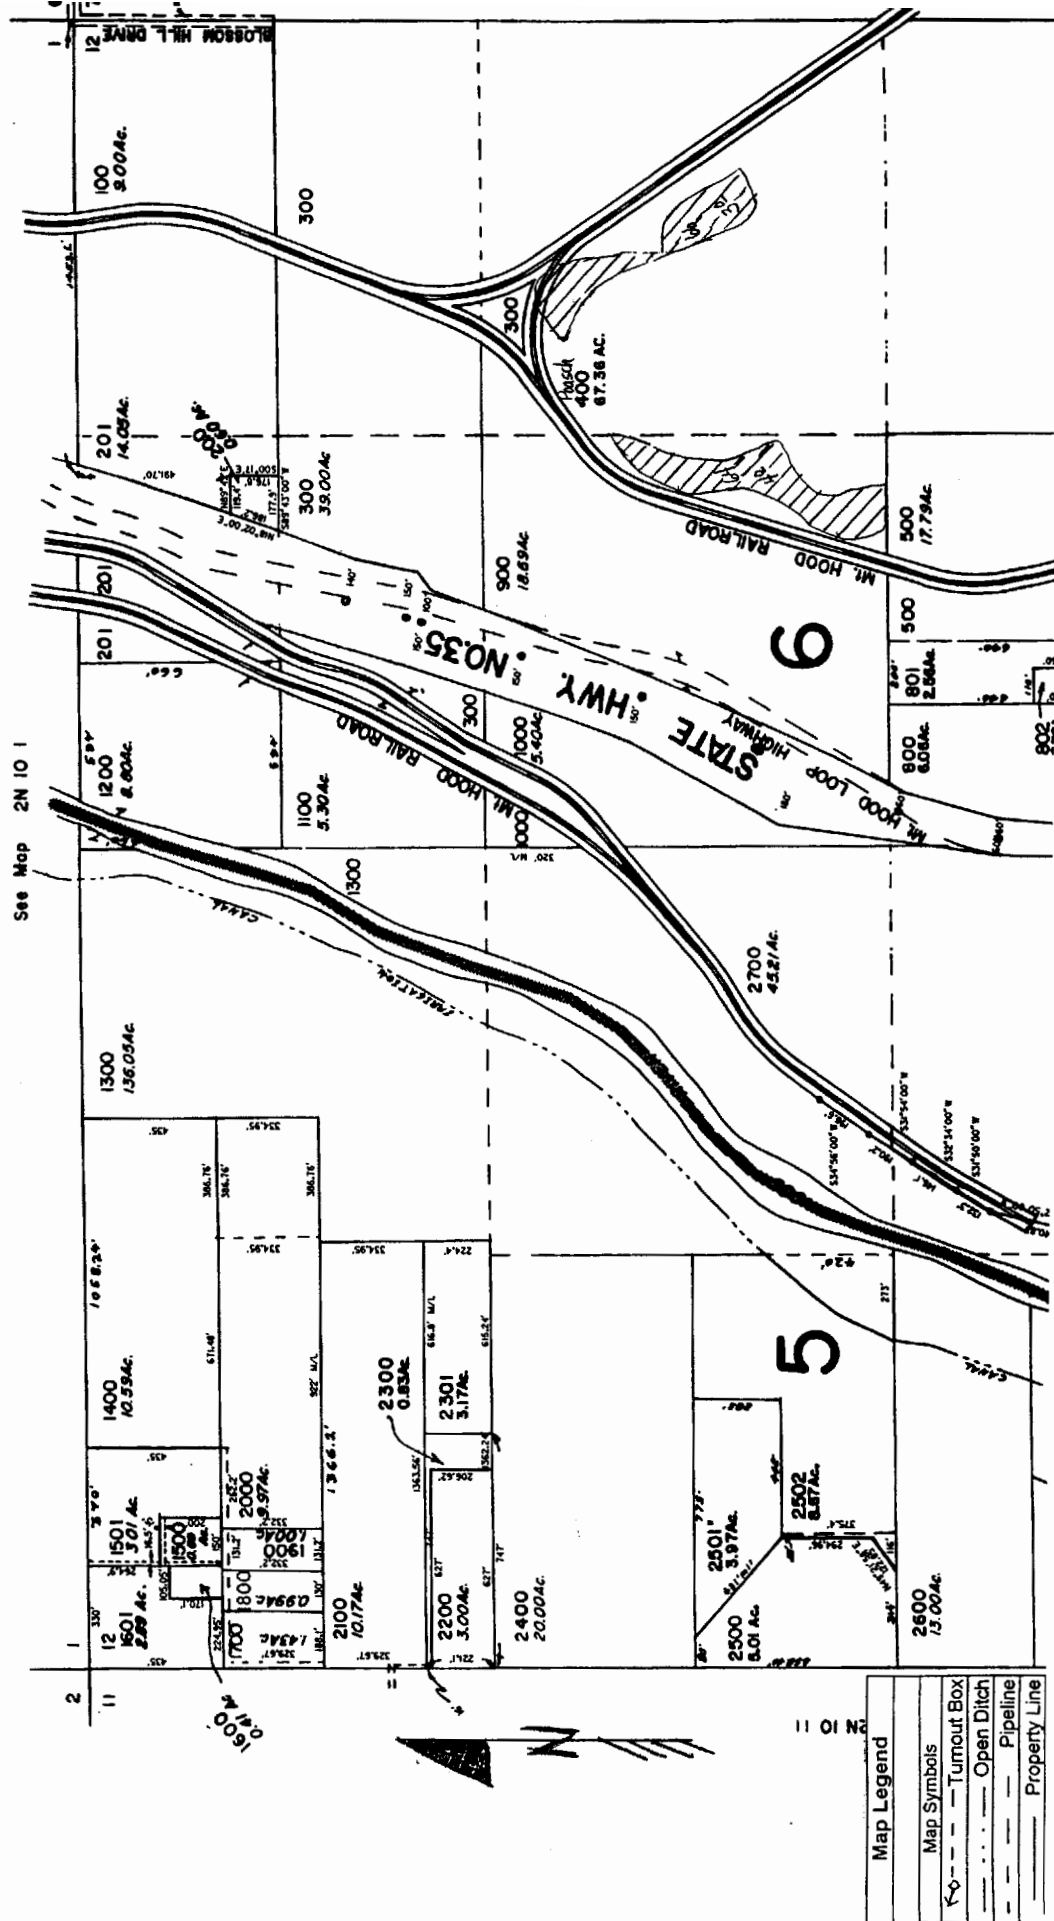


See Map 2N 10 1

Application No. 39634  
 Permit No. 29617  
 Certificate No. 80929  
 Map 22 of 72

WATER RESOURCES DEPT.  
 SALEM, OREGON

See Map 2N 11 7

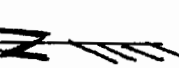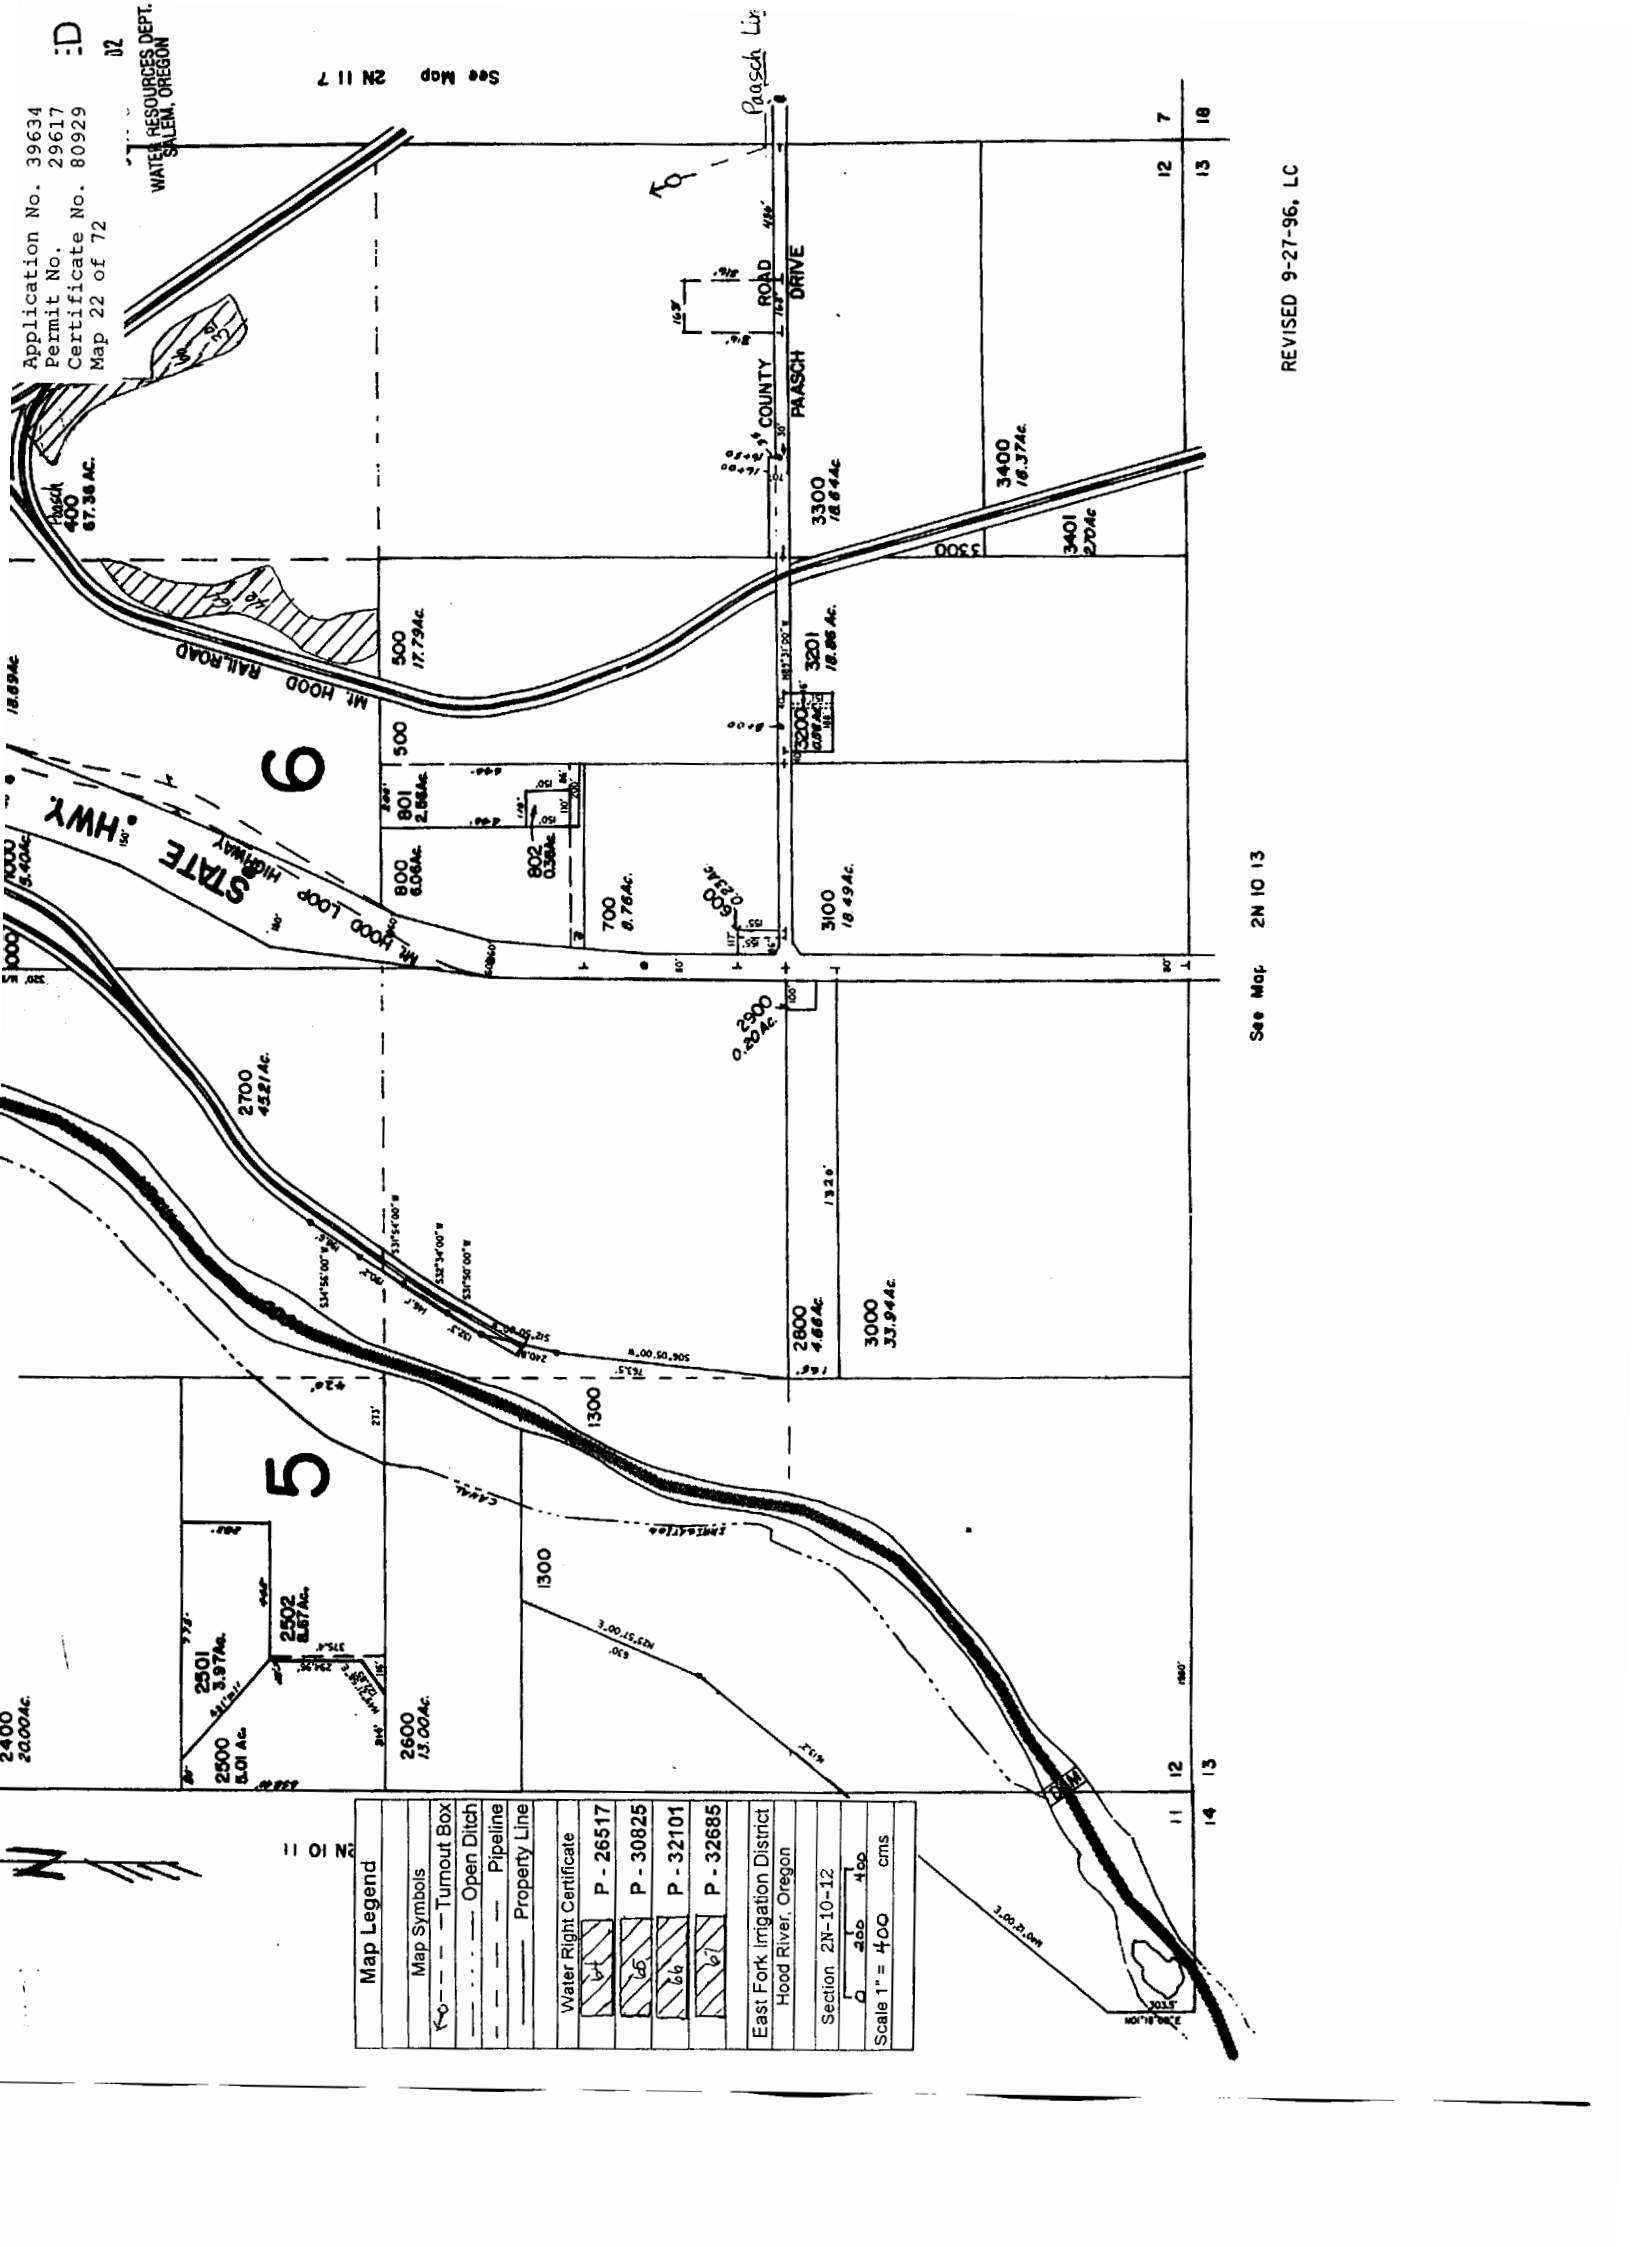

2 N 10 13

Map Legend	
Map Symbols	
	Turnout Box
	Open Ditch
	Pipeline
	Property Line
Water Right Certificate	
	P - 26517
	P - 30825
	P - 32101
	P - 32685
East Fork Irrigation District Hood River, Oregon	
	0 100 200 400
Scale 1" = 400' cms	

See Map 2N 10 13

REVISED 9-27-96, LC

Application No. 39634  
 Permit No. 29617  
 Certificate No. 80929  
 Map 23 of 72

SECTION 14 T.2N. R.10E. W.M.  
 HOOD RIVER COUNTY

1" = 400'


THIS MAP WAS PREPARED FOR  
 ASSESSMENT PURPOSE ONLY

SEE MAP 02 10

SEE MAP 02N 10 11D

SEE MAP 02N 10 11C

SEE MAP 02N 10 15

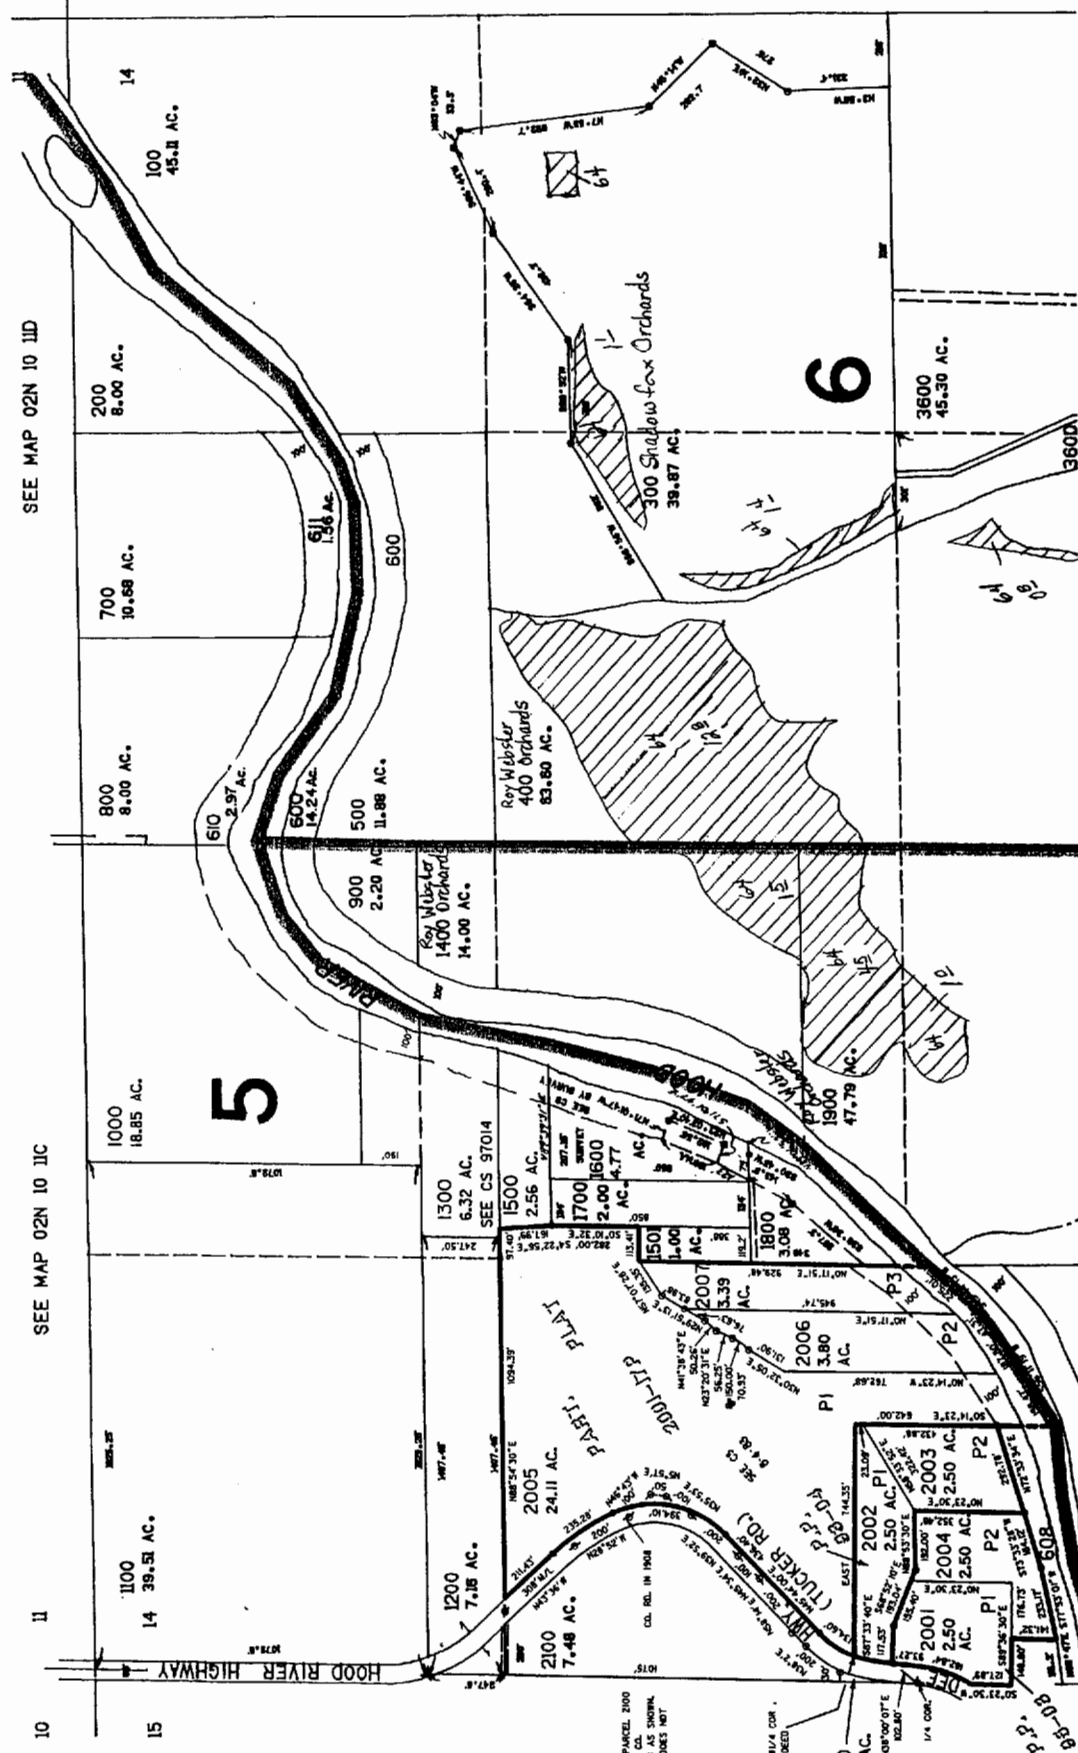

CANCEL  
 602 T  
 607  
 609  
 2200  
 2701  
 2900  
 3000  
 3201  
 3400  
 1001

SEE MAP 02N 10 13

NOTE: PARCEL 2000 AND PARCEL 2100  
 ORIGINALLY SHOWN IN THE 1/4 SECTION  
 PARTITION PLAT TOOK-IT DOES NOT  
 REFLECT THIS LINE.

NOTE: PARCEL 2100 IS W/4 COR.  
 E 1/4 LINE OF INT. BY DEED.


Application No. 39634  
 Permit No. 29617  
 Certificate No. 80929  
 Map 24 of 72

RECEIVED

JUN 03 2002  
 WATER RESOURCES DEPT  
 SALEM, OREGON

SEE MAP 02N 10 13

Map Legend	
Map Symbols	
	Turnout Box
	Open Ditch
	Pipeline
Property Line	
Water Right Certificate	
	P - 26517
	P - 30825
	P - 32101
	P - 32685
East Fork Irrigation District Hood River, Oregon	
Section 2N-10-14	
	Scale 1" = 400 cms

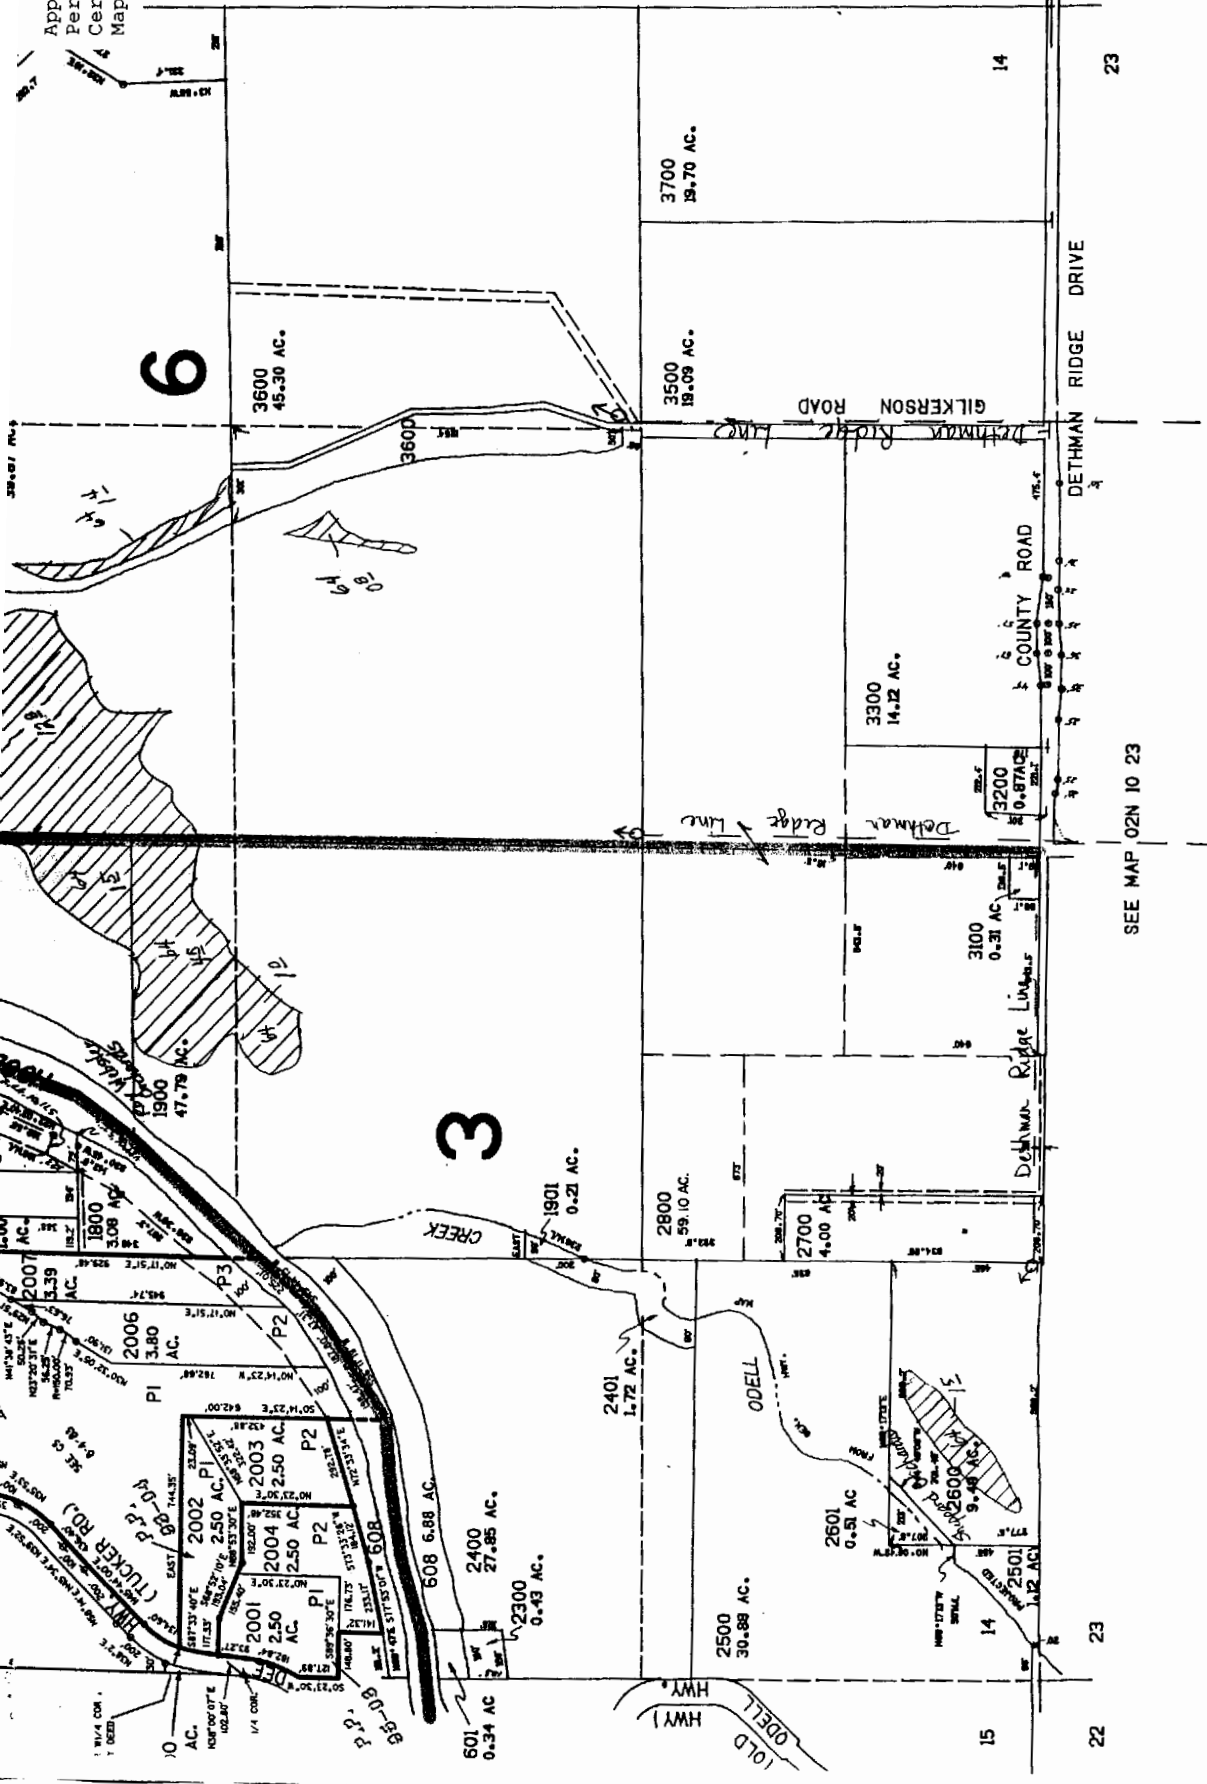

SEE MAP 02N 10 23

Revised  
 6/11/01, JD

2N 10 14




Application No. 39634  
 Permit No. 29617  
 Certificate No. 80929  
 Map 25 of 72

WATER RESOURCES DIVISION  
 SALEM, OREGON

SECTION 22 T.02N. R.10E. W.M.  
 HOOD RIVER COUNTY

1-400'

THIS MAP WAS PREPARED FOR  
 ASSESSMENT PURPOSE ONLY

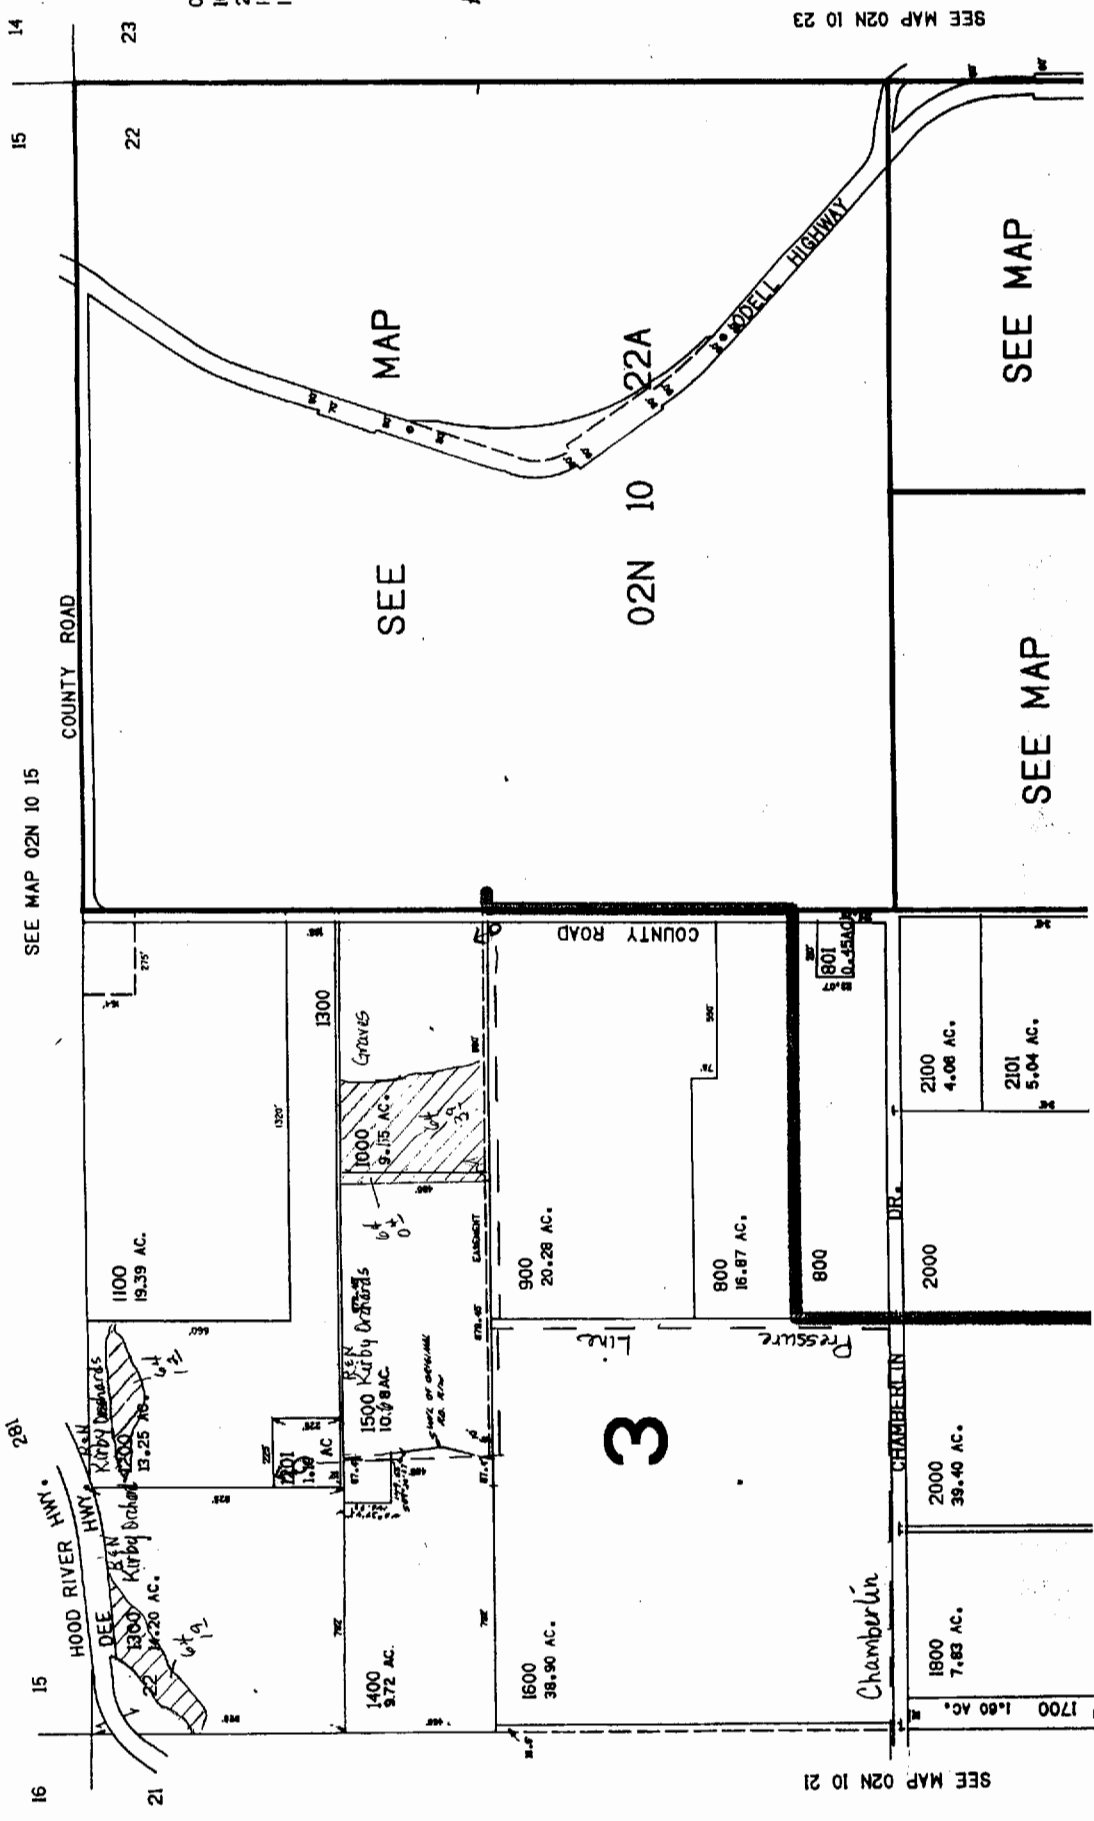

16

15








































































SEE MAP 02N 10 21

SEE MAP 02N 10 23

SEE MAP

SEE MAP

MAP

02N 10

22A

3

Chamberlin

DR.

COUNTY ROAD

RODDELL HIGHWAY

COUNTY ROAD

SEE MAP 02N 10 15

SEE MAP 02N 10 15

181

HOOD RIVER HWY

DEE KEN Kirby Dam

13.25 AC.

13.25 AC.

THIS MAP WAS PREPARED FOR  
ASSESSMENT PURPOSE ONLY


SECTION 24, T.2N. R.10E. W.M.  
HOOD RIVER COUNTY

Application No. 39634  
Permit No. 29617  
Certificate No. 80929  
Map 27 of 72

RECEIVED  
JUN 03 2002  
WATER RESOURCES DEPT.  
SALEM, OREGON

1" = 400'

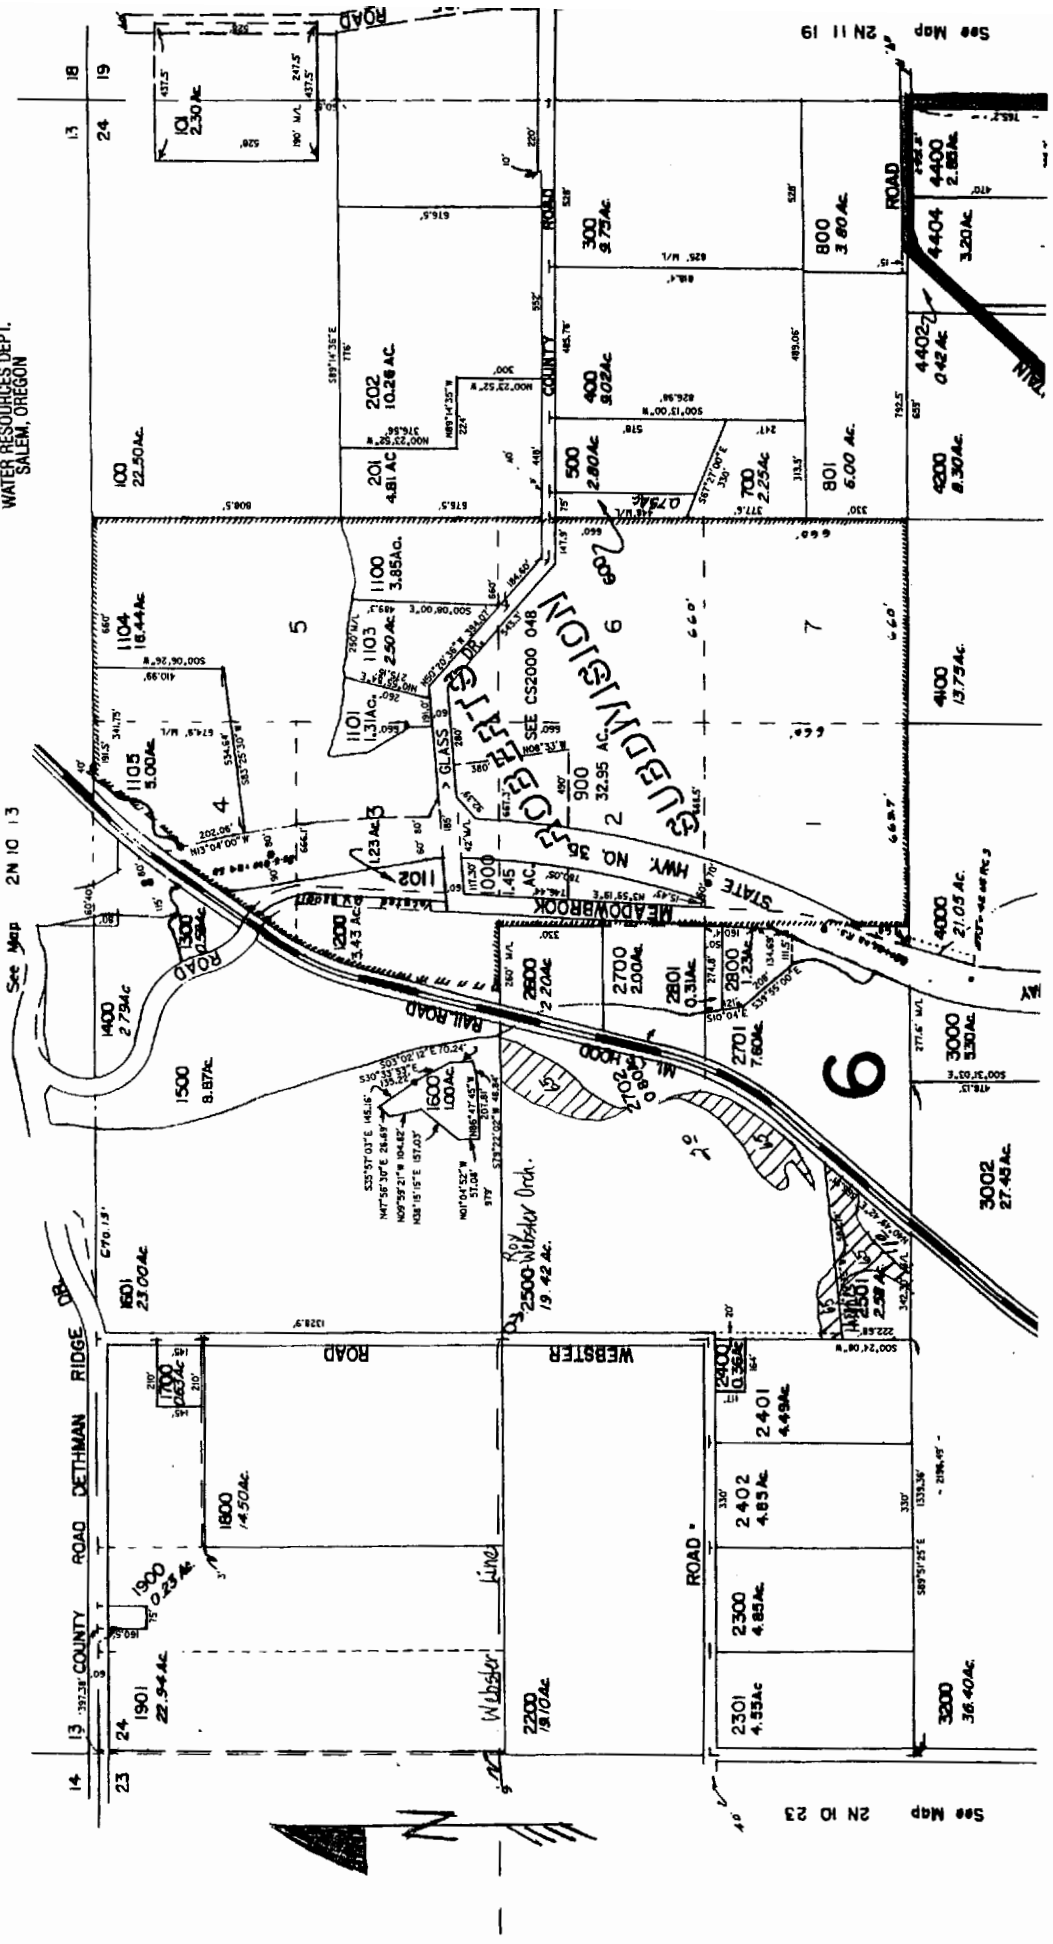

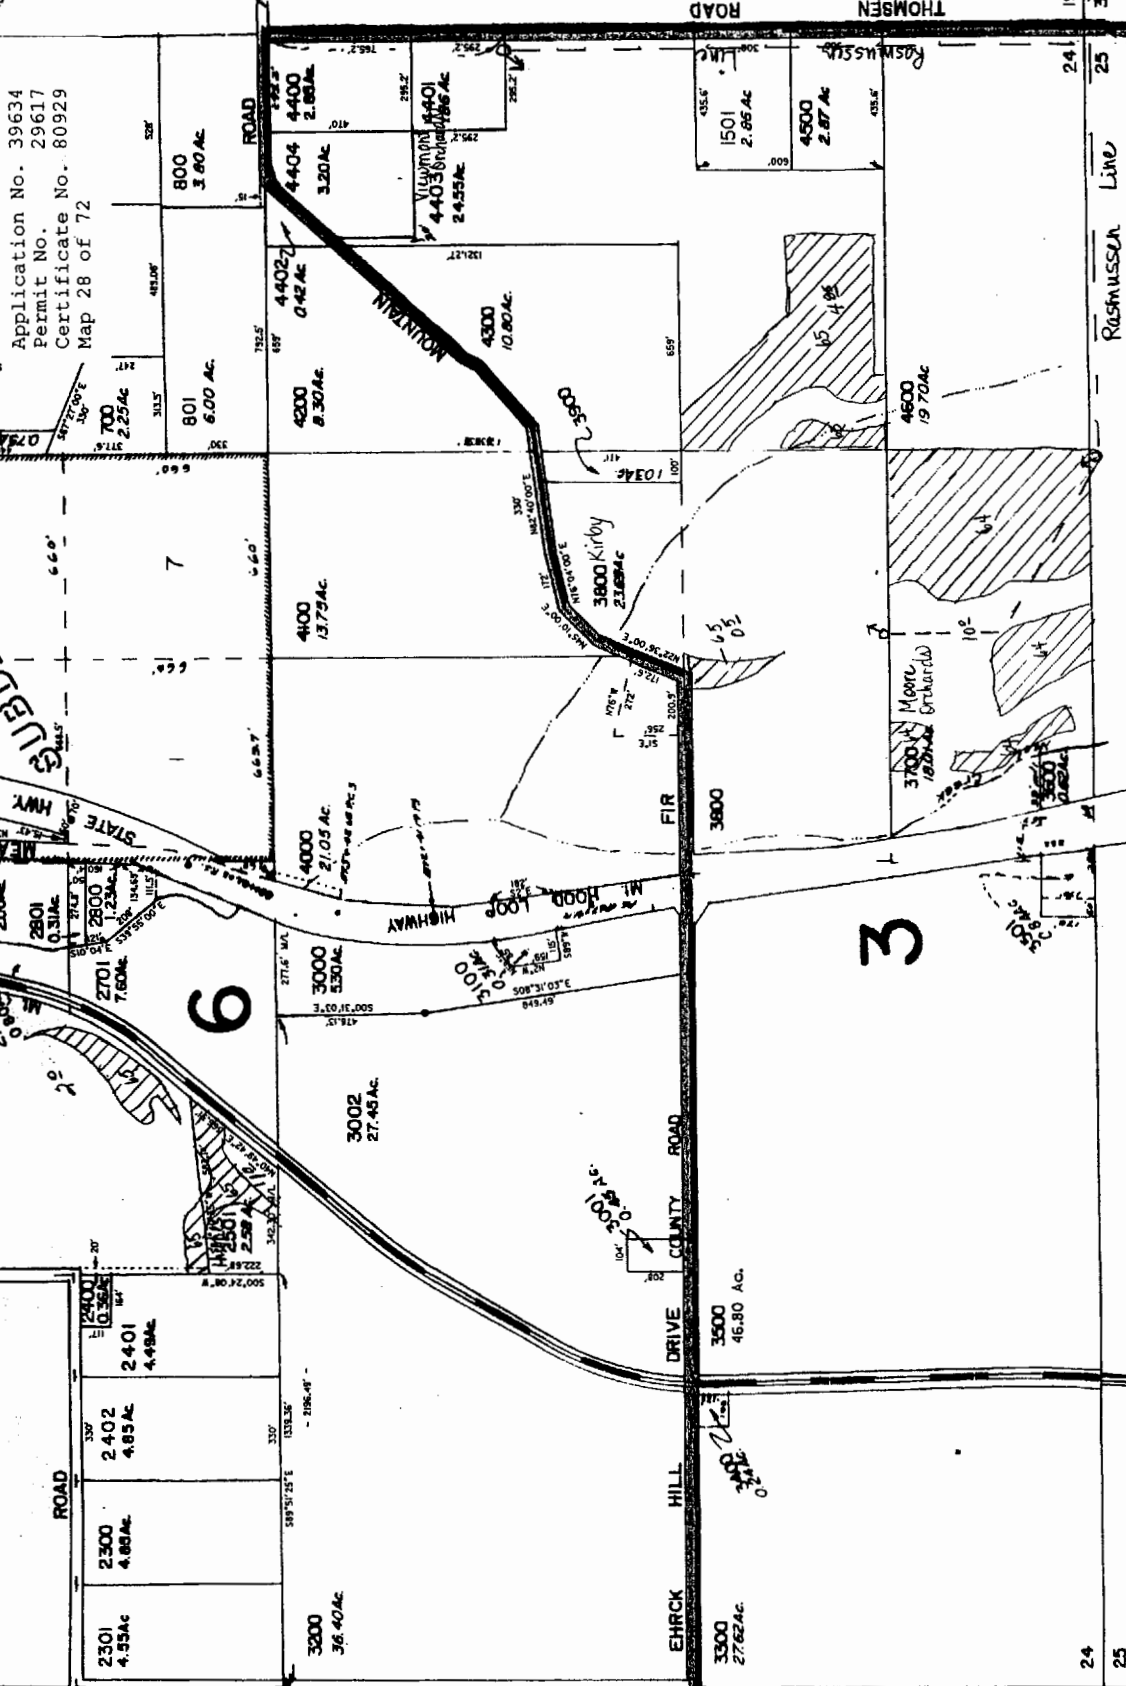

See Map 2N 10 23

See Map 2N 11 19

Map Legend	
Map Symbols	
	Turnout Box
	Open Ditch
	Pipeline
	Property Line
Water Right Certificate	
	P - 26517
	P - 30825
	P - 32101
	P - 32685
East Fork Irrigation District Hood River, Oregon	
Section 2N-10-24	
	400 cms
Scale 1" = 400 cms	

RECEIVED

JUN 03 2002

WATER RESOURCES DEPT.  
 SALEM, OREGON

See Map 2N 10 25

Revised 7/11/00, JD

2N


SECTION 25 T.2N. R.10E. W.M.  
HOOD RIVER COUNTY

THIS MAP WAS PREPARED FOR  
ASSESSMENT PURPOSE ONLY

Application No. 39634  
Permit No. 29617  
Certificate No. 80929  
Map 29 of 72

JUN 03 2002  
WATER RESOURCES DEPT.  
SALEM, OREGON

1" = 400'

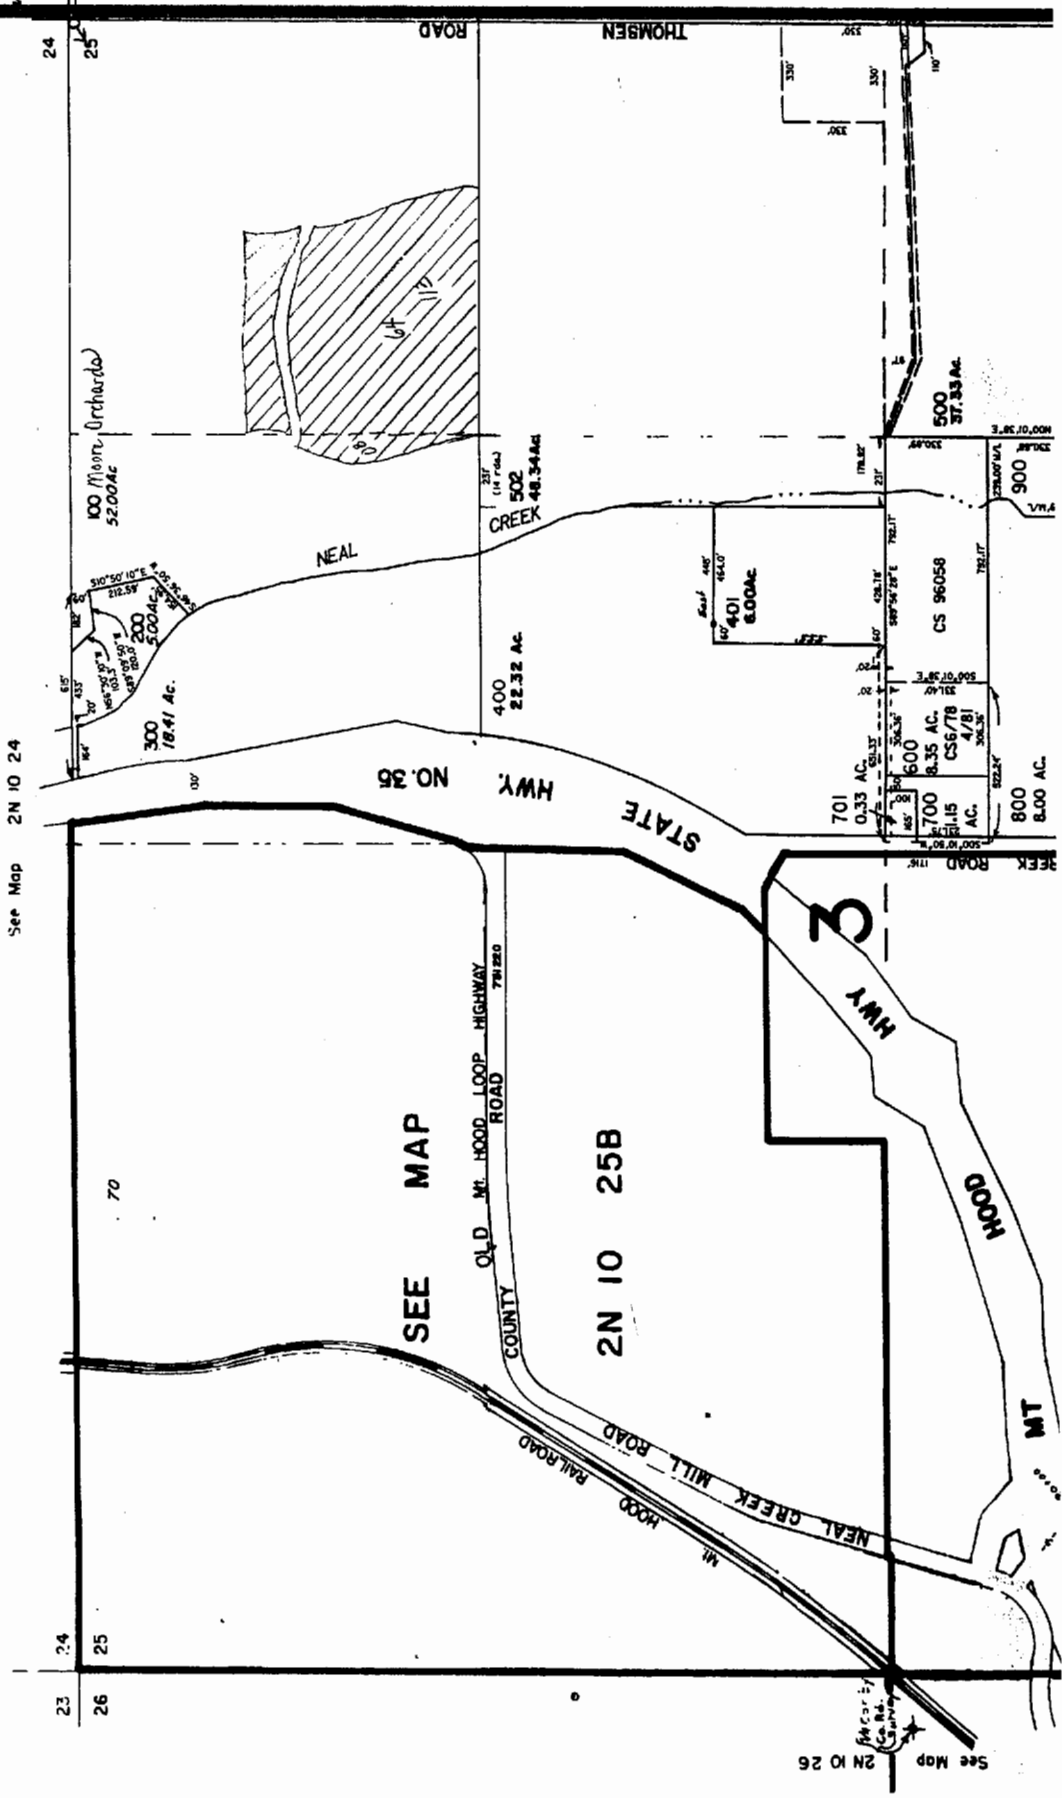

Application No. 39634  
 Permit No. 29617  
 Certificate No. 80929  
 Map 30 of 72

ED  
 002

WATER RESOURCES DEPT.  
 SALEM, OREGON


See Map 2N 10 26

See Map 2N 10 25

Map Legend	
Map Symbols	
	Turnout Box
	Open Ditch
	Pipeline
	Property Line
Water Right Certificate	
	P - 26517
	P - 30825
	P - 32101
	P - 32685
East Fork Irrigation District	
Hood River, Oregon	
Section 2N-10-25	
	25
	36
Scale 1" = 400 cms	

2N 10 25  
 & INDEX

REVISED 8-20-98, JD

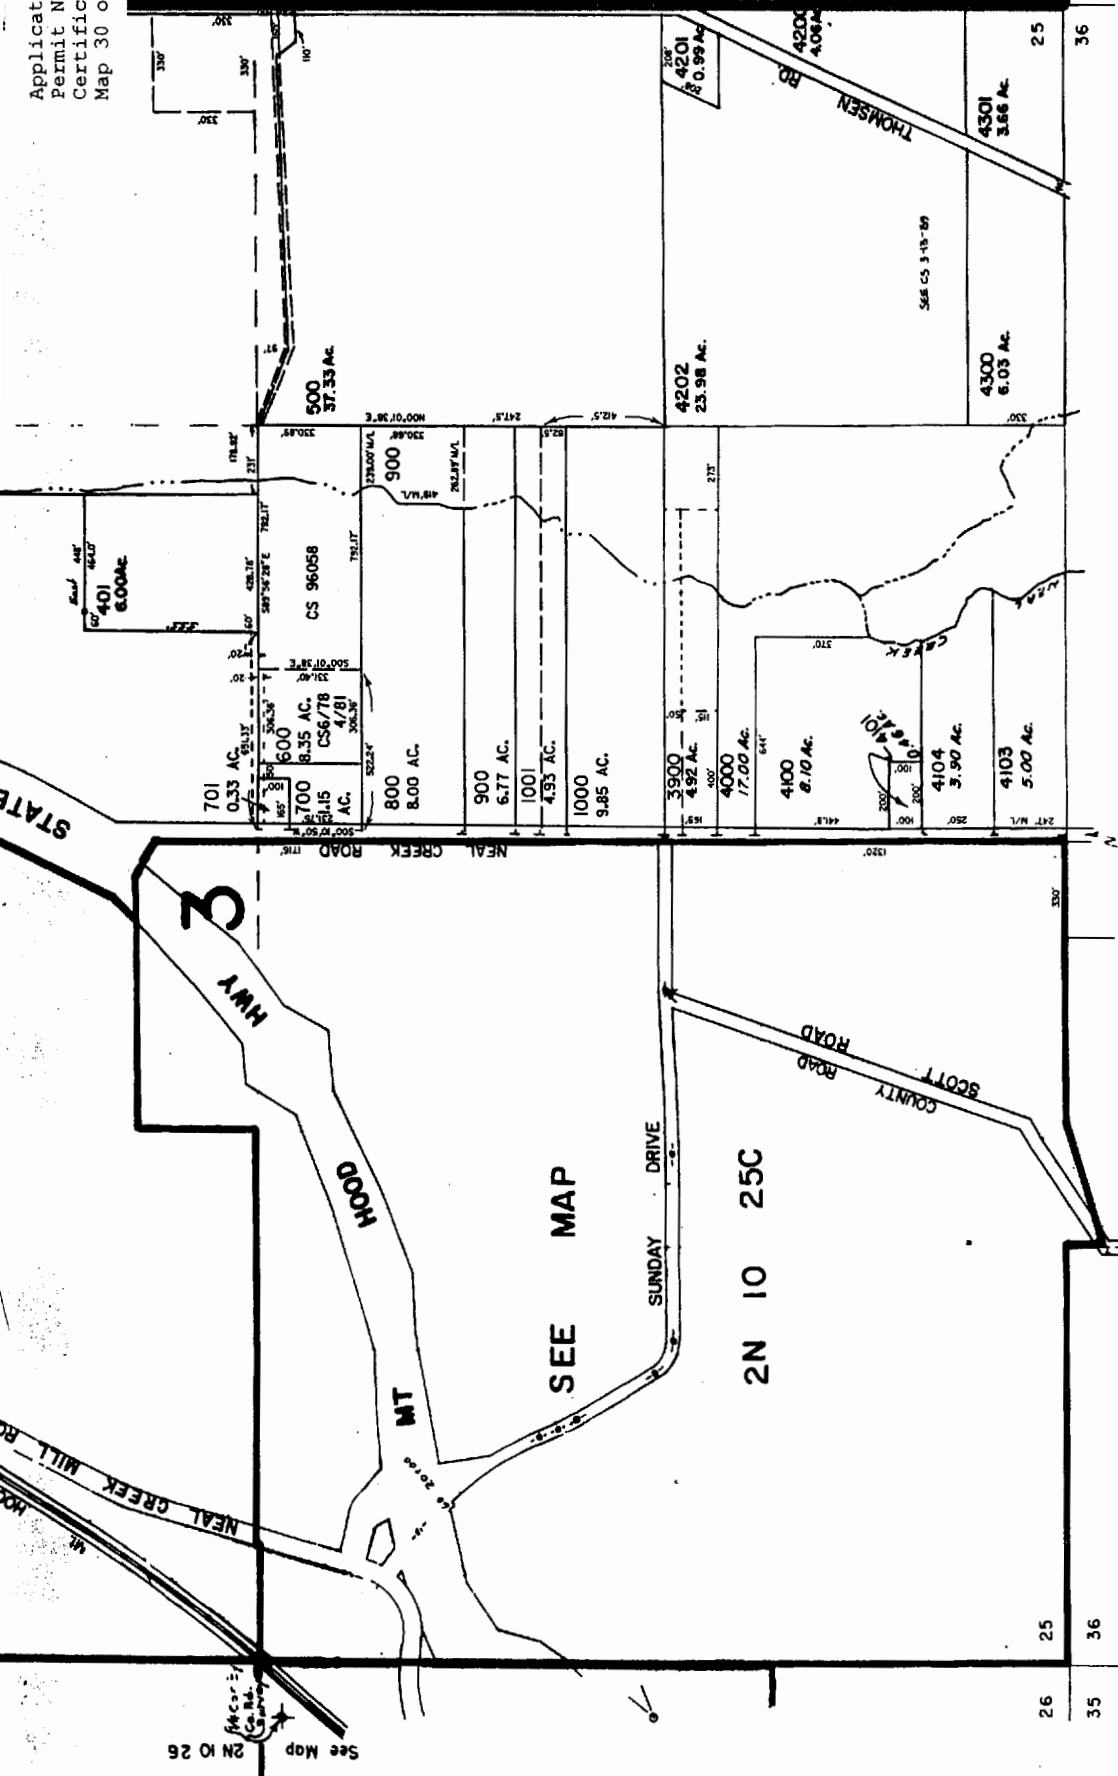

See Map 2N 10 36

SEE MAP  
 2N 10 25C

Application No. 39634  
Permit No. 29617  
Certificate No. 80929  
Map 31 of 72

SW1/4 SEC. 25 T.2N. R.10E. W.M.  
HOOD RIVER COUNTY


1" = 200'

SEE MAP 2N 10 25B

MAP 2N 10 26D

RECEIVED  
JUN 0 3 2002  
WATER RESOURCES DEPT.  
SALEM OREGON

THIS MAP WAS PREPARED FOR  
ASSESSMENT PURPOSE ONLY

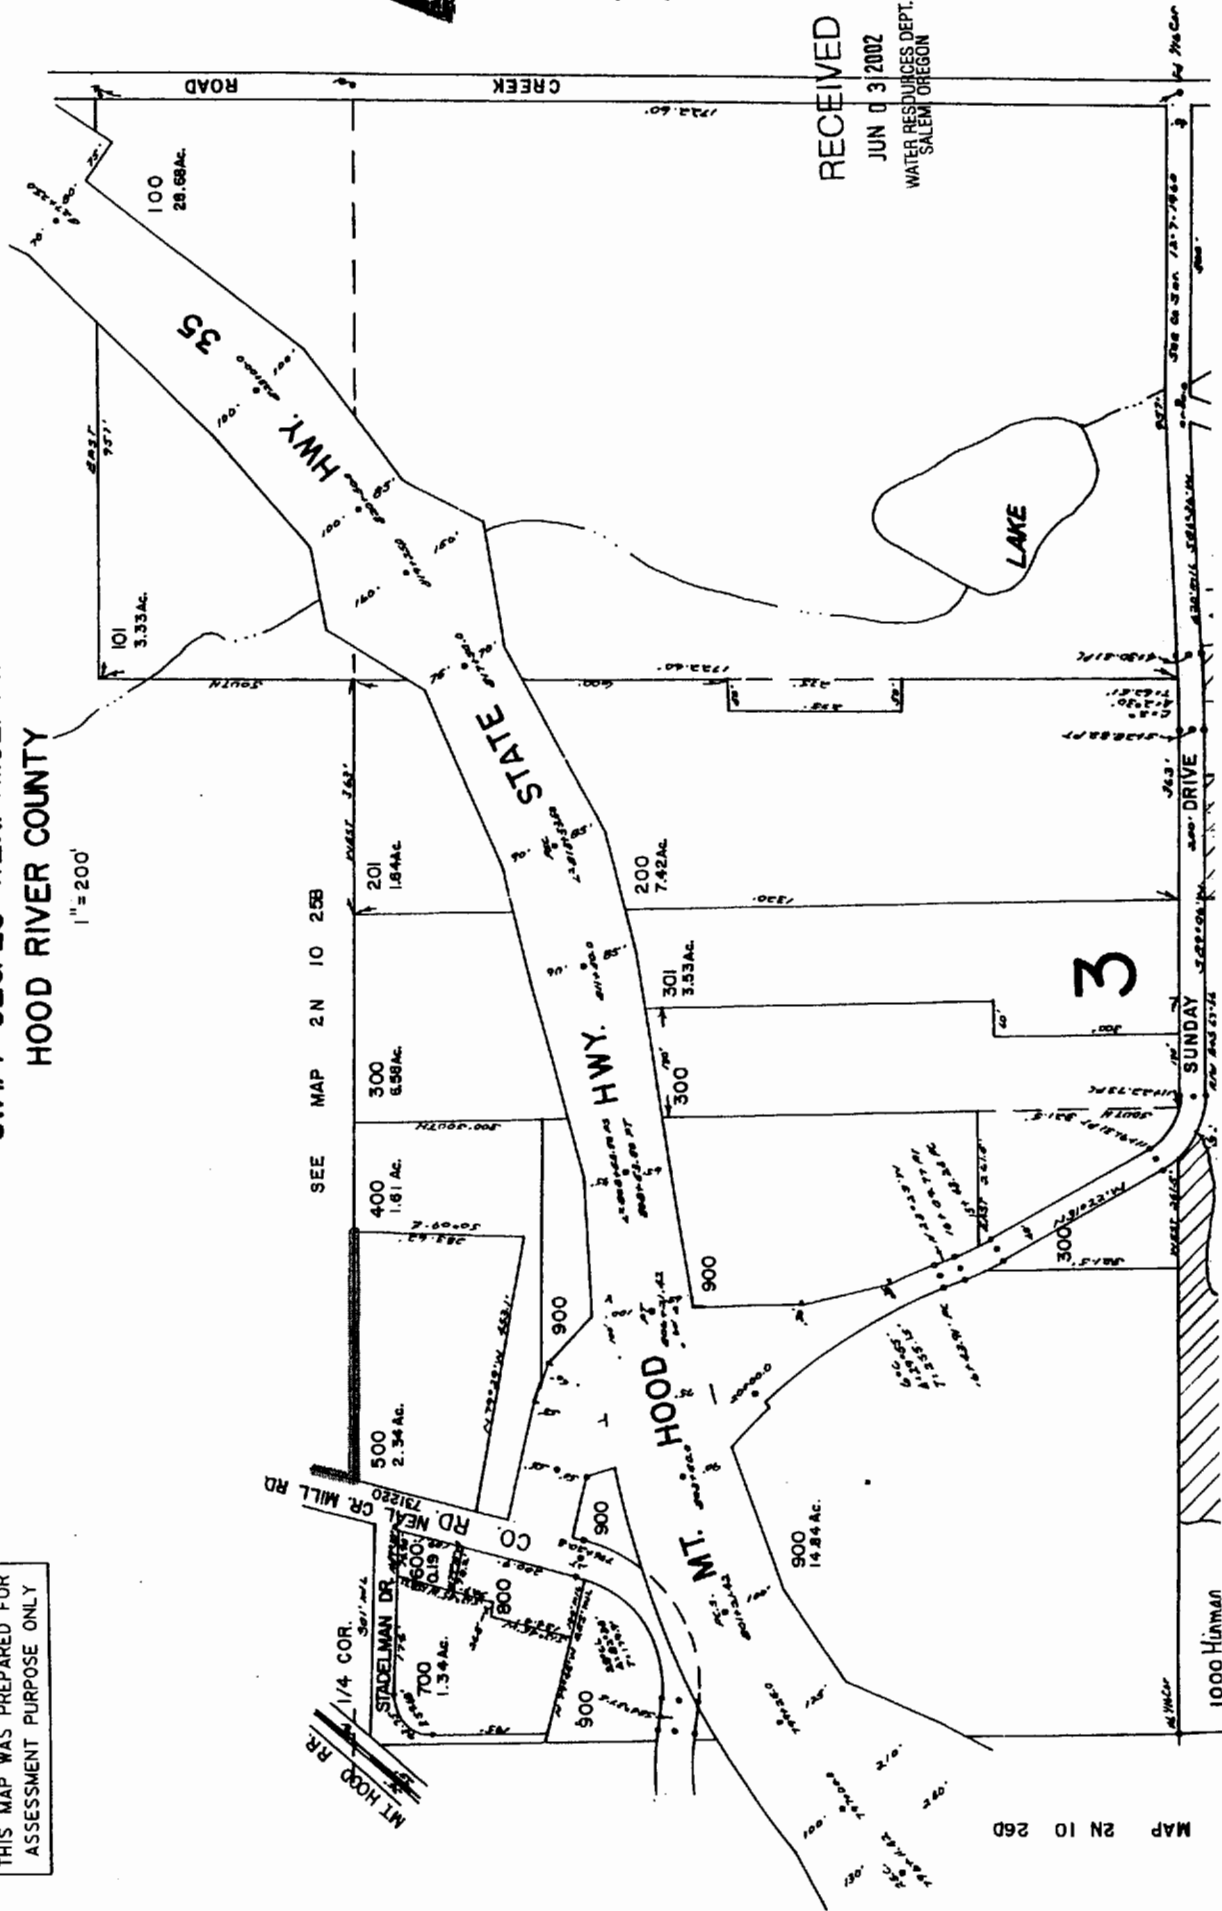

MT HOOD RD  
1/4 COR.  
STADELMAN DR  
CO. RD NEAL CR MILL RD

100  
28.68 AC

101  
3.33 AC

300  
6.58 AC

400  
1.81 AC

500  
2.34 AC

700  
1.34 AC

900

900  
14.84 AC

200  
1.84 AC

200  
7.42 AC

300  
3.53 AC

3

LAKE

1000 Hunman

ROAD  
CREEK

STATE HWY.  
35


MT. HOOD

SUNDAY DRIVE

1000 Hunman


1000 Hunman

Application No. 39634  
 Permit No. 29617  
 Certificate No. 80929  
 Map 32 of 72

SEE MAP 2N 10 26D

RECEIVED  
 JUN 03 2002  
 WATER RESOURCES DEPT.  
 SALEM, OREGON

Map Legend	
Map Symbols	
	Turnout Box
	Open Ditch
	Pipeline
	Property Line
Water Right Certificate	
	P - 26517
	P - 30825
	P - 32101
	P - 32685
East Fork Irrigation District Hood River, Oregon	
Section 2N-10-25C	
	0 100 200
Scale 1" = 200' cms	

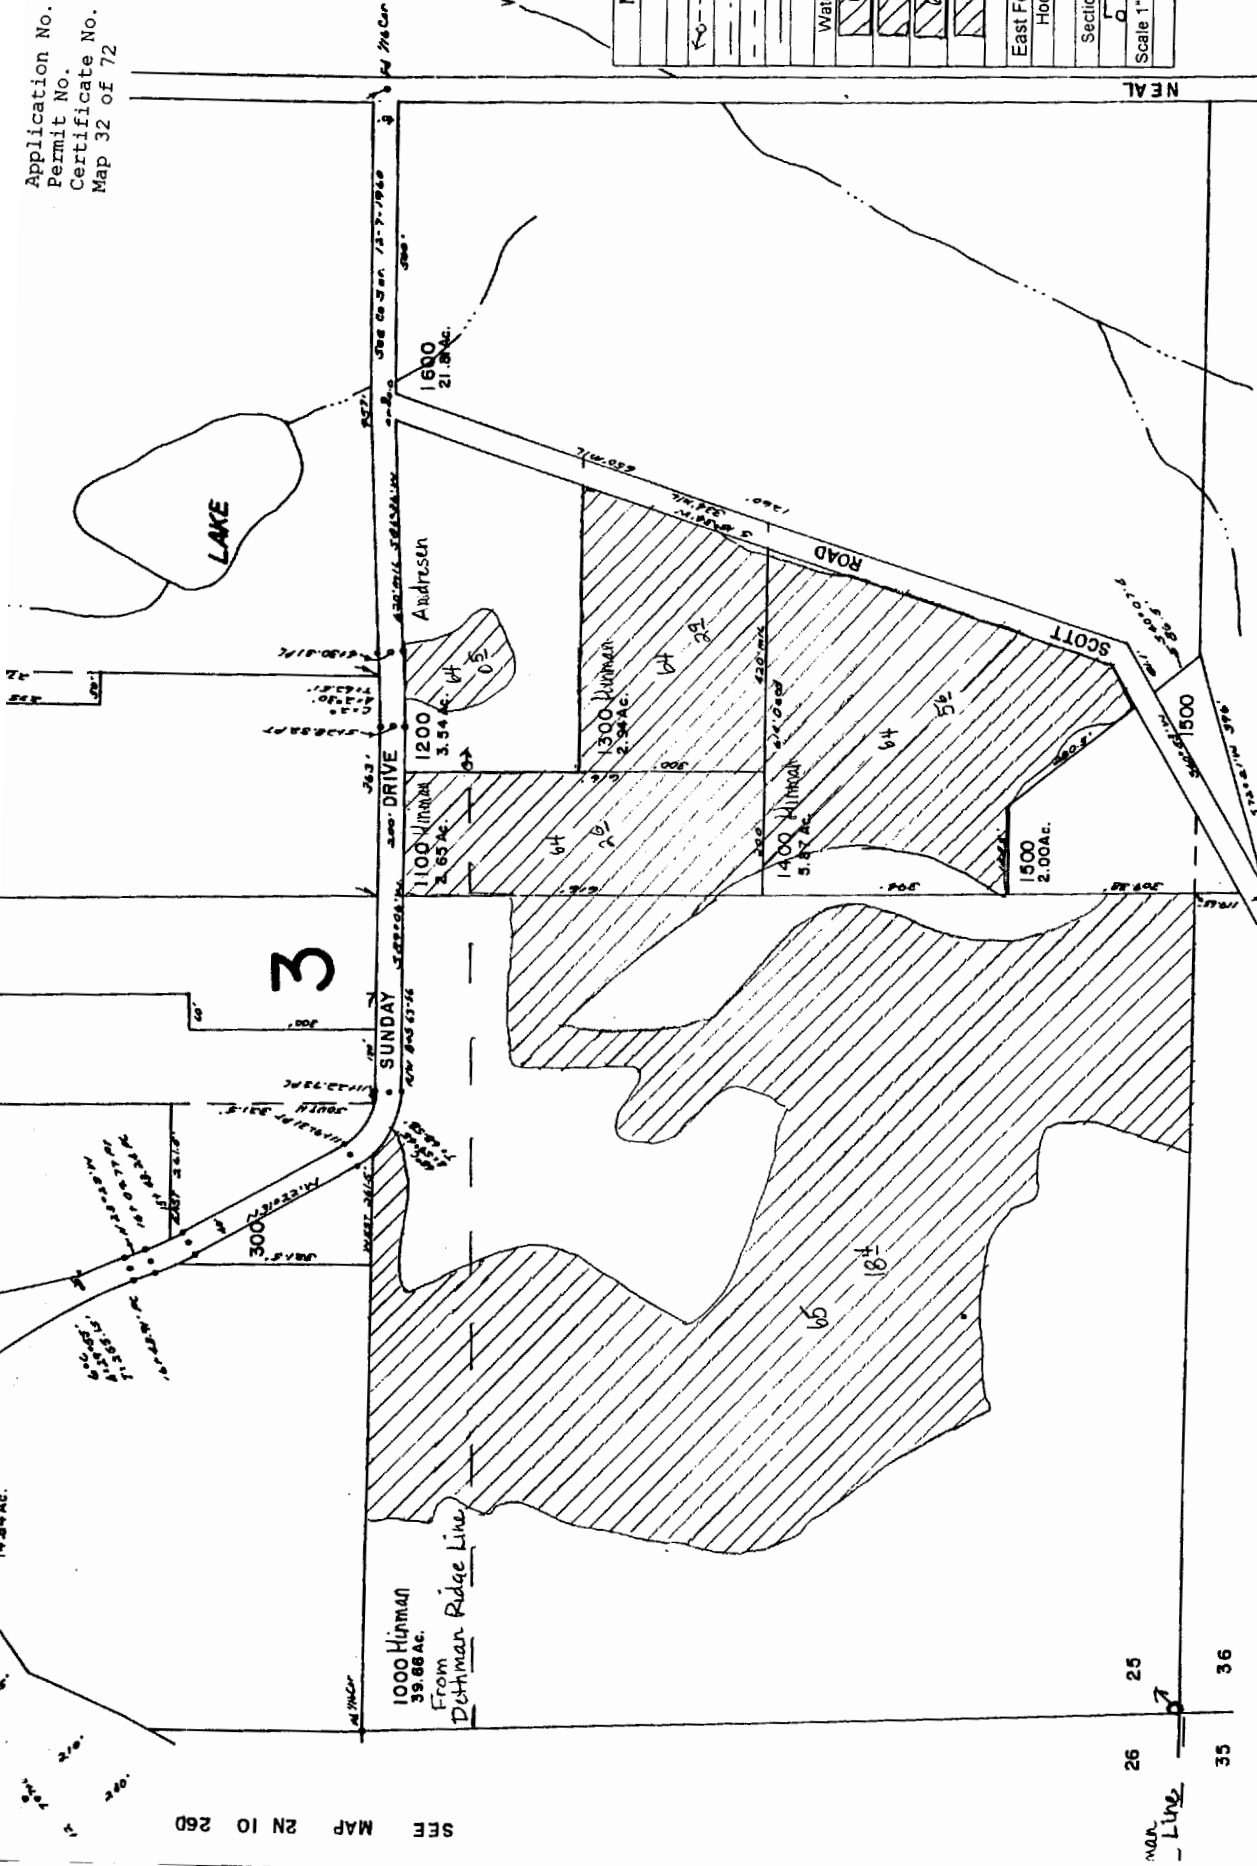

SEE MAP 2N 10 26D

SEE MAP 2N 10 36

2N 10 25C



Section 26 T2N R10E WM  
Hood River County


1" = 400'

Application No. 39634  
Permit No. 29617  
Certificate No. 80929  
Map 33 of 72

WATER RESOURCES DEPT.  
SALEM, OREGON

Cancelled  
500 thru  
3600

THIS MAP WAS PREPARED FOR  
ASSESSMENT PURPOSE ONLY

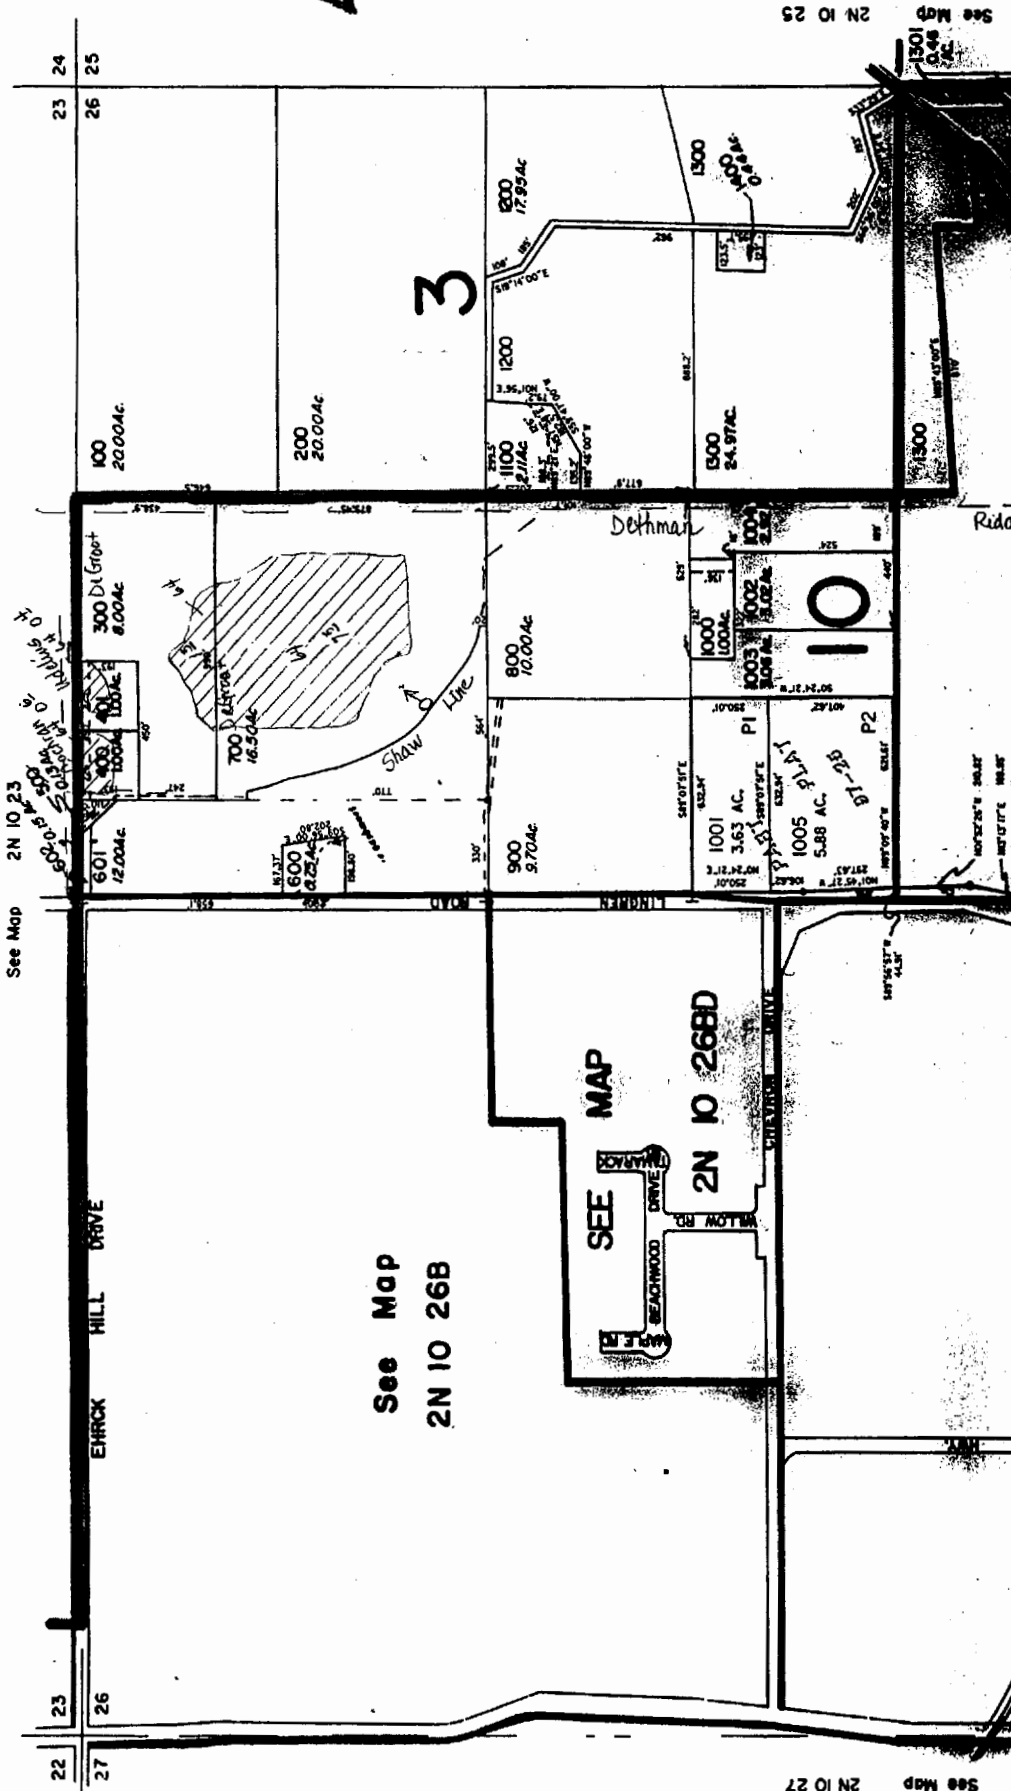

See Map  
2N 10 26B

SEE MAP

2N 10 26BD

See Map 2N 10 23


See Map 2N 10 27

See Map 2N 10 25

Application No. 39634  
 Permit No. 29617  
 Certificate No. 80929  
 Map 34 of 72

WILHELM, URSULIN

See Map 2N 10 27

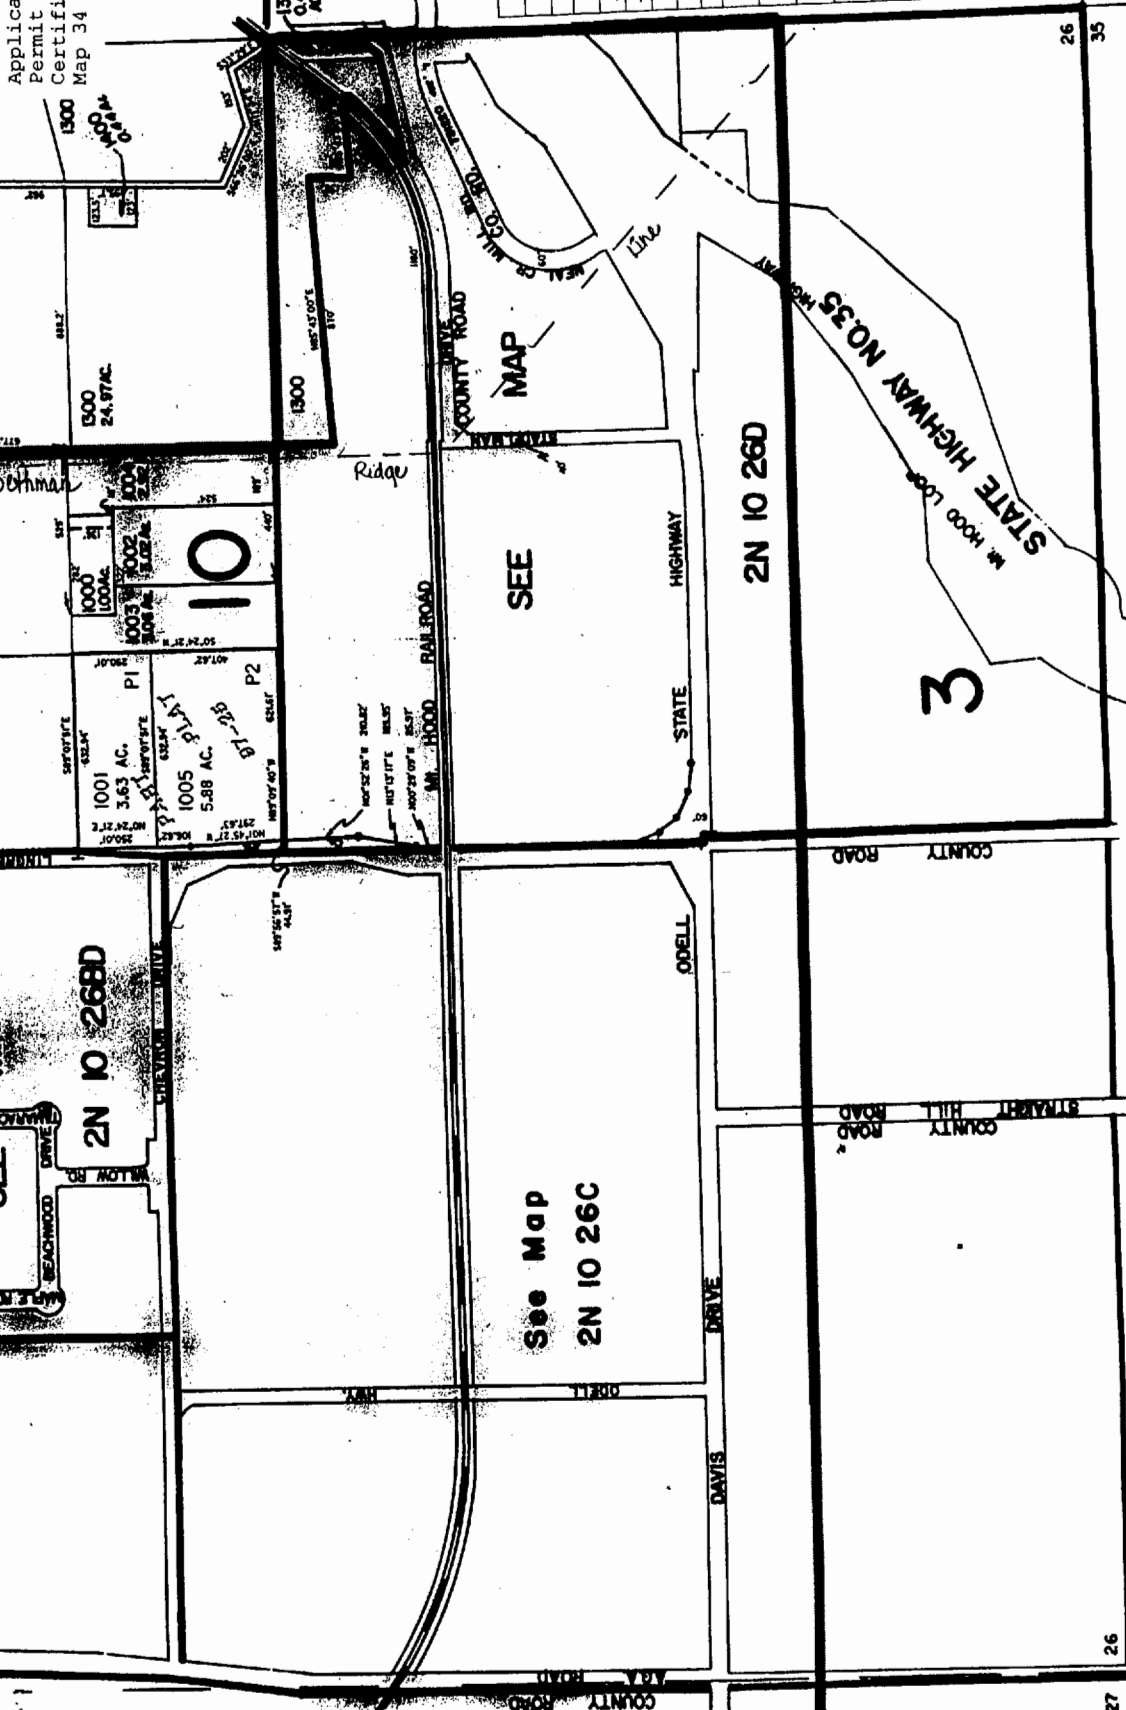

See Map 2N 10 27

Map Legend	
Map Symbols	
	Turnout Box
	Open Ditch
	Pipeline
	Property Line
Water Right Certificate	
	P - 26517
	P - 30825
	P - 32101
	P - 32685
East Fork Irrigation District Hood River, Oregon	
Section 2N-10-26	
	4.50
Scale 1" = 400 cms	

REVISED 12-11-97, JD

See Map 2N 10 35

See Map 2N 10 27

2N 10 26  
 & INDEX



Application No. 39634  
 Permit No. 29617  
 Certificate No. 80929  
 Map 36 of 72


Map Legend	
Map Symbols	
--- Turnout Box	
--- Open Ditch	
--- Pipeline	
--- Property Line	
Water Right Certificate	
	P - 26517
	P - 30825
	P - 32101
	P - 32685
East Fork Irrigation District Hood River, Oregon	
Section 2N-10-26BB	
Scale 1" = 100' cms	

RECEIVED  
 JUN 03 2002  
 WATER RESOURCES DEPT.  
 SALEM, OREGON

SEE MAP 2N 10 26B

SEE MAP 2N 10 26BC

2N 10 26

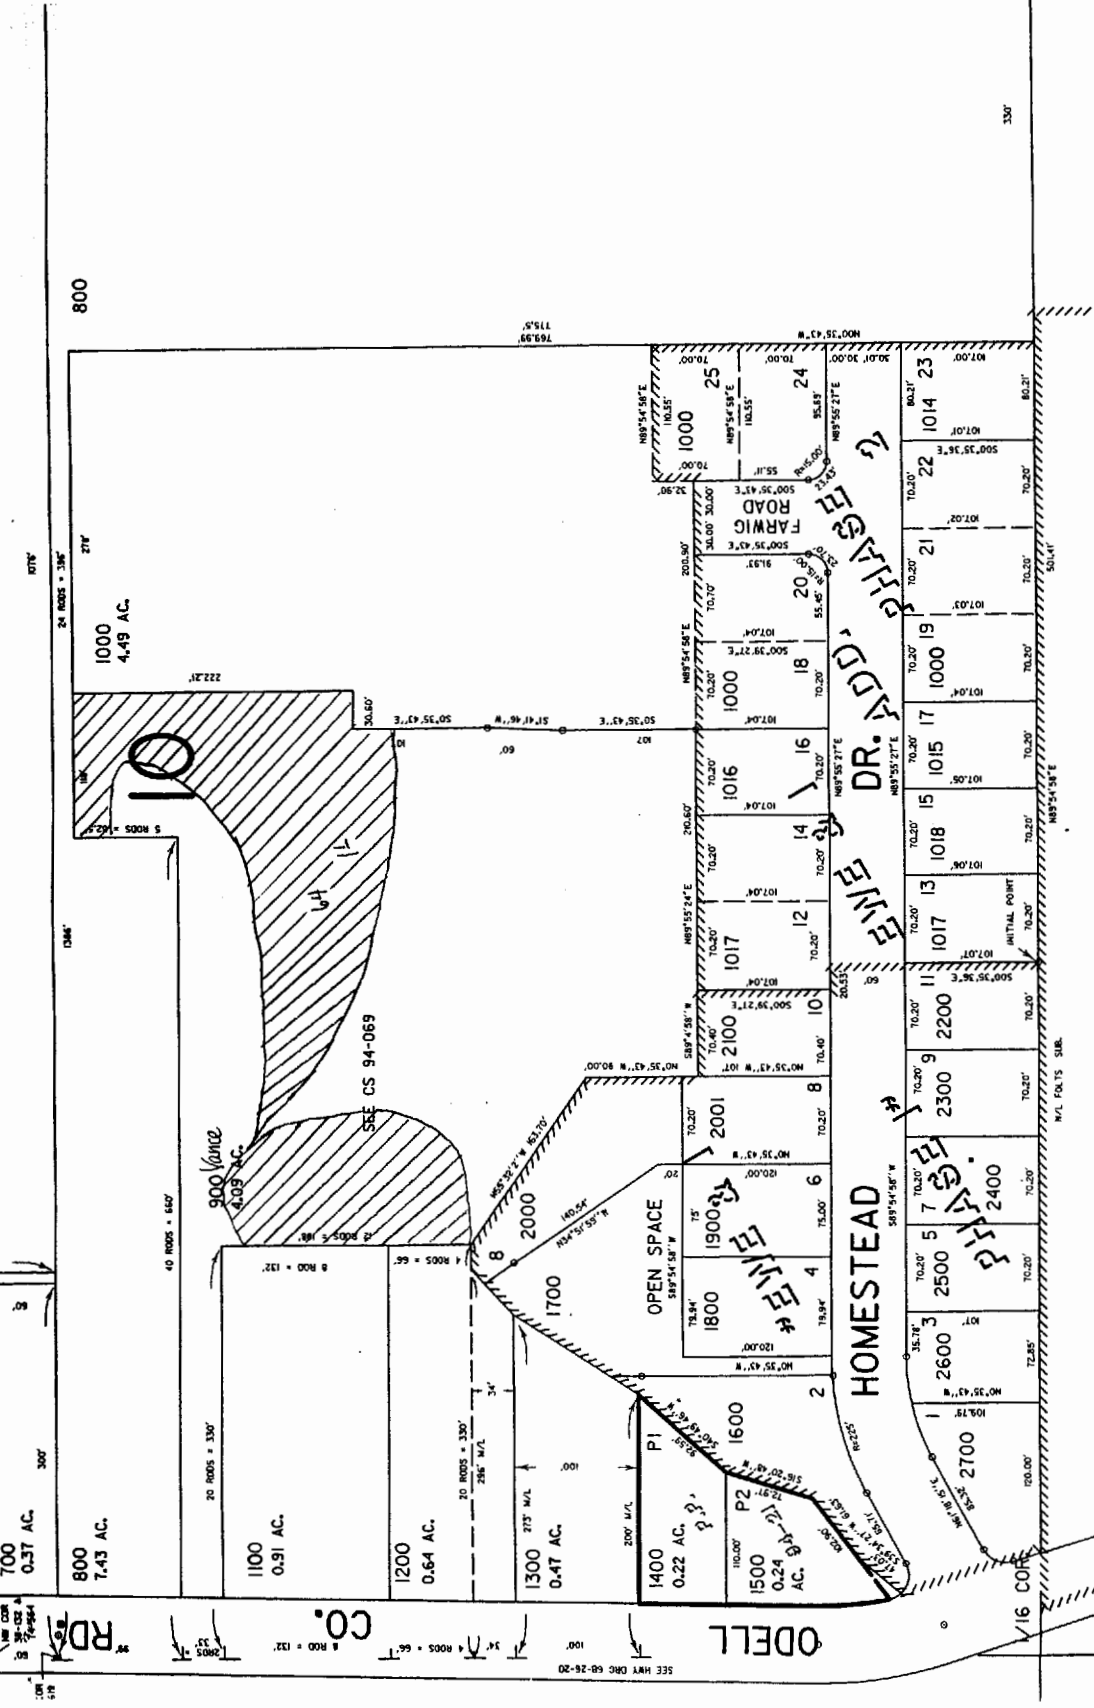

SEE MAP 2N 10 26B

SEE MAP 2N 10 26BC


2N 10 26

Application No. 39634  
 Permit No. 29617  
 Certificate No. 80929  
 Map 37 of 72

SE 1/4 SEC. 26 T.02N. R.10E. W.M.  
 HOOD RIVER COUNTY

1"=200'

THIS MAP WAS PREPARED FOR  
 ASSESSMENT PURPOSE ONLY

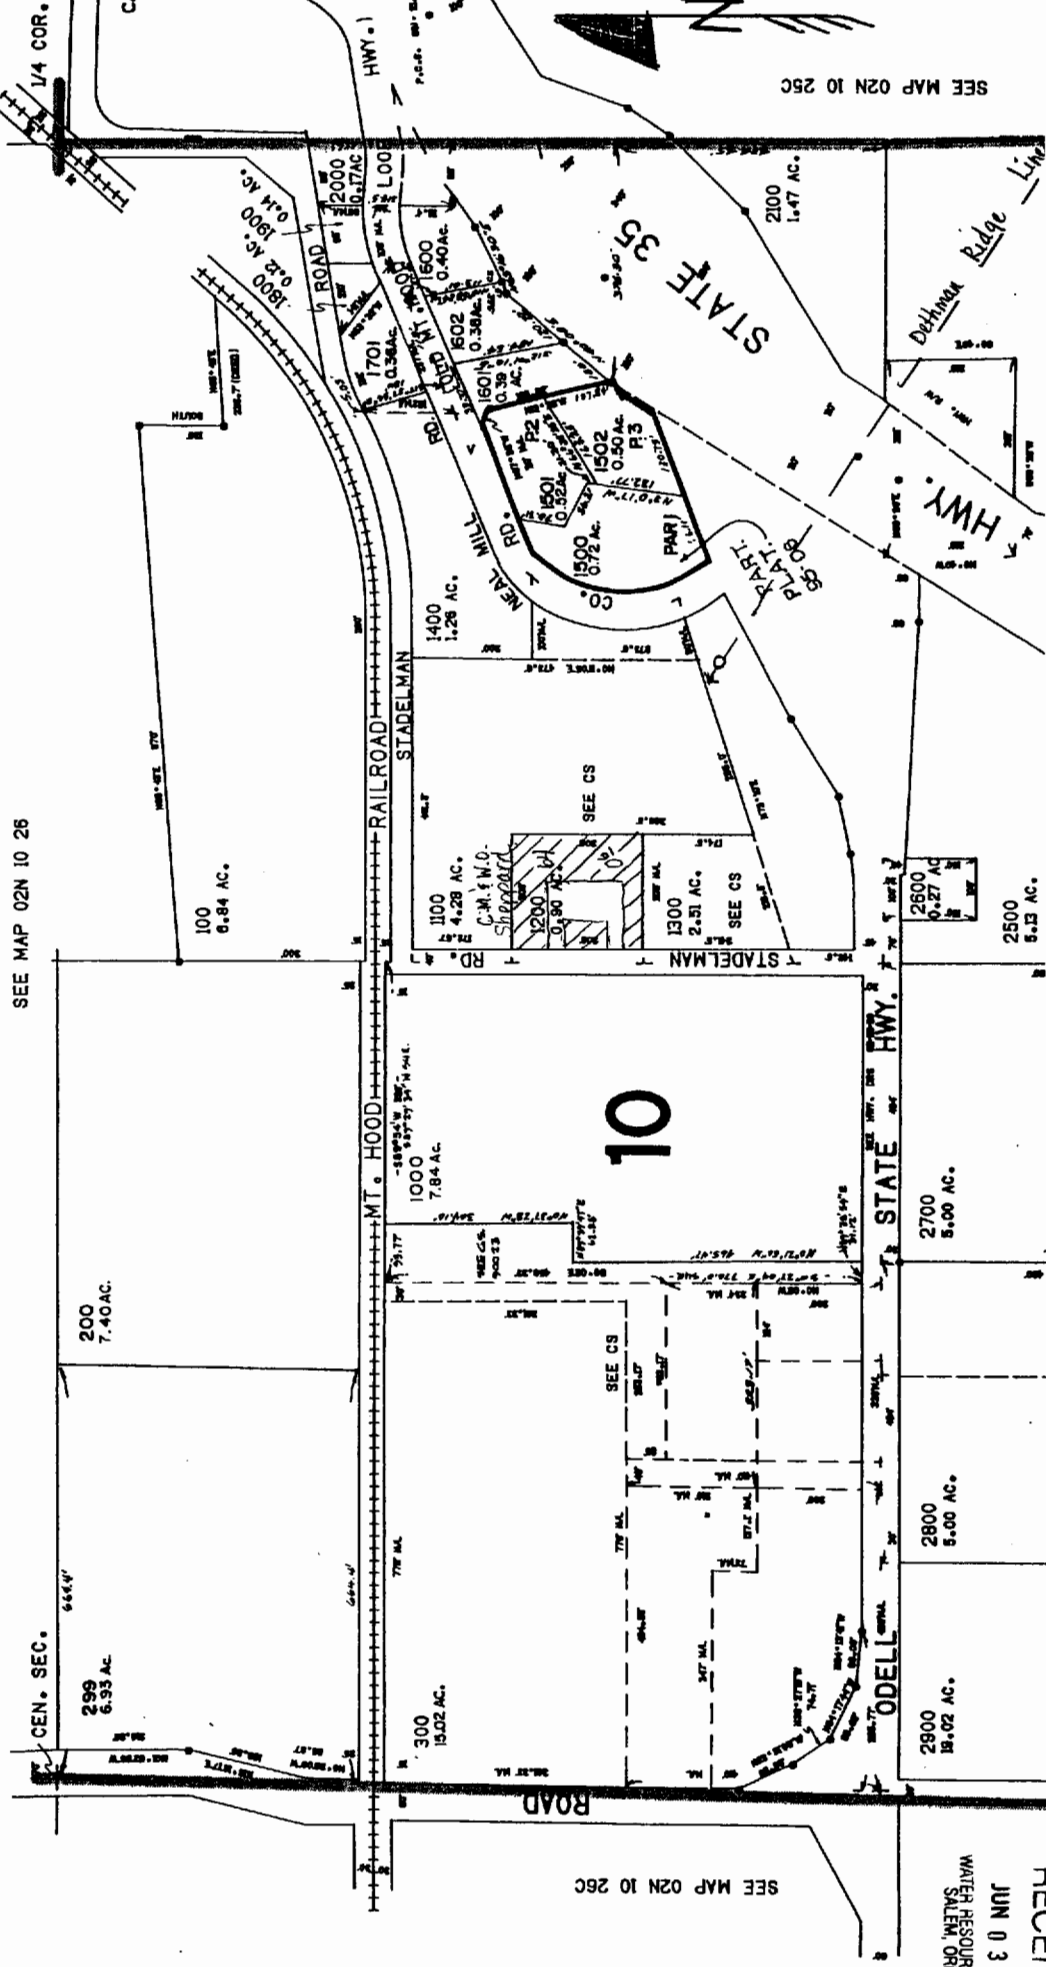


RECEIVED  
 JUN 03 2002  
 WATER RESOURCES DEPT.  
 SALEM, OREGON

Application No. 39634  
 Permit No. 29617  
 Certificate No. 80929  
 Map 38 of 72

SEE MAP 02N 10 25C

RECEIVED  
 JUN 03 2002  
 WATER RESOURCES DEPT.  
 SALEM, OREGON

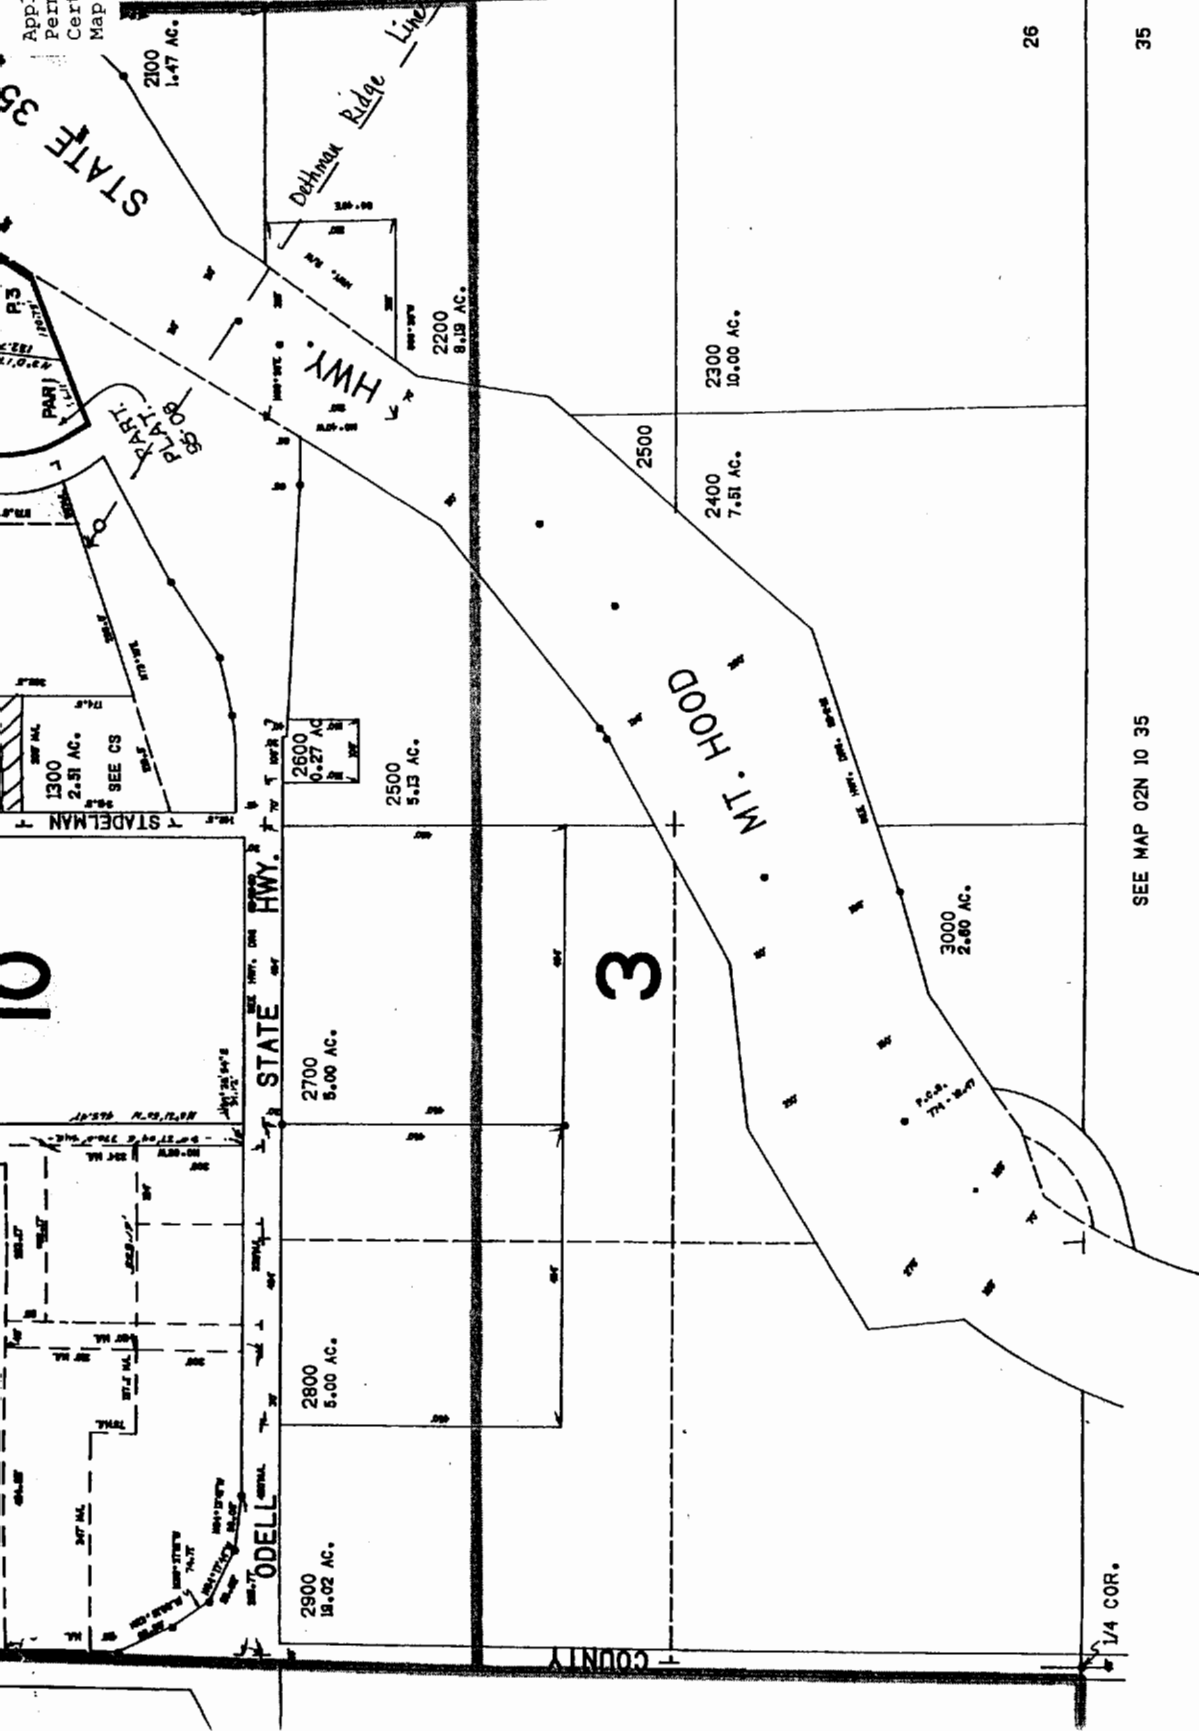

SEE MAP 02N 10 35

Map Legend	
Map Symbols	
←---→	Turnout Box
---	Open Ditch
---	Pipeline
---	Property Line
Water Right Certificate	
▨	P - 26517
▨	P - 30825
▨	P - 32101
▨	P - 32685
East Fork Irrigation District Hood River, Oregon	
Section 2N-10-26D	
100	100
Scale 1" = 200' cms	

02N 10 26D


THIS MAP WAS PREPARED FOR  
ASSESSMENT PURPOSE ONLY

SECTION 27 T.2N.R.10E. W.M.  
HOOD RIVER COUNTY

1" = 400'

JUN 03 2002  
WATER RESOURCES DEPT.  
SALEM, OREGON

Application No. 39634  
Permit No. 29617  
Certificate No. 80929  
Map 39 of 72

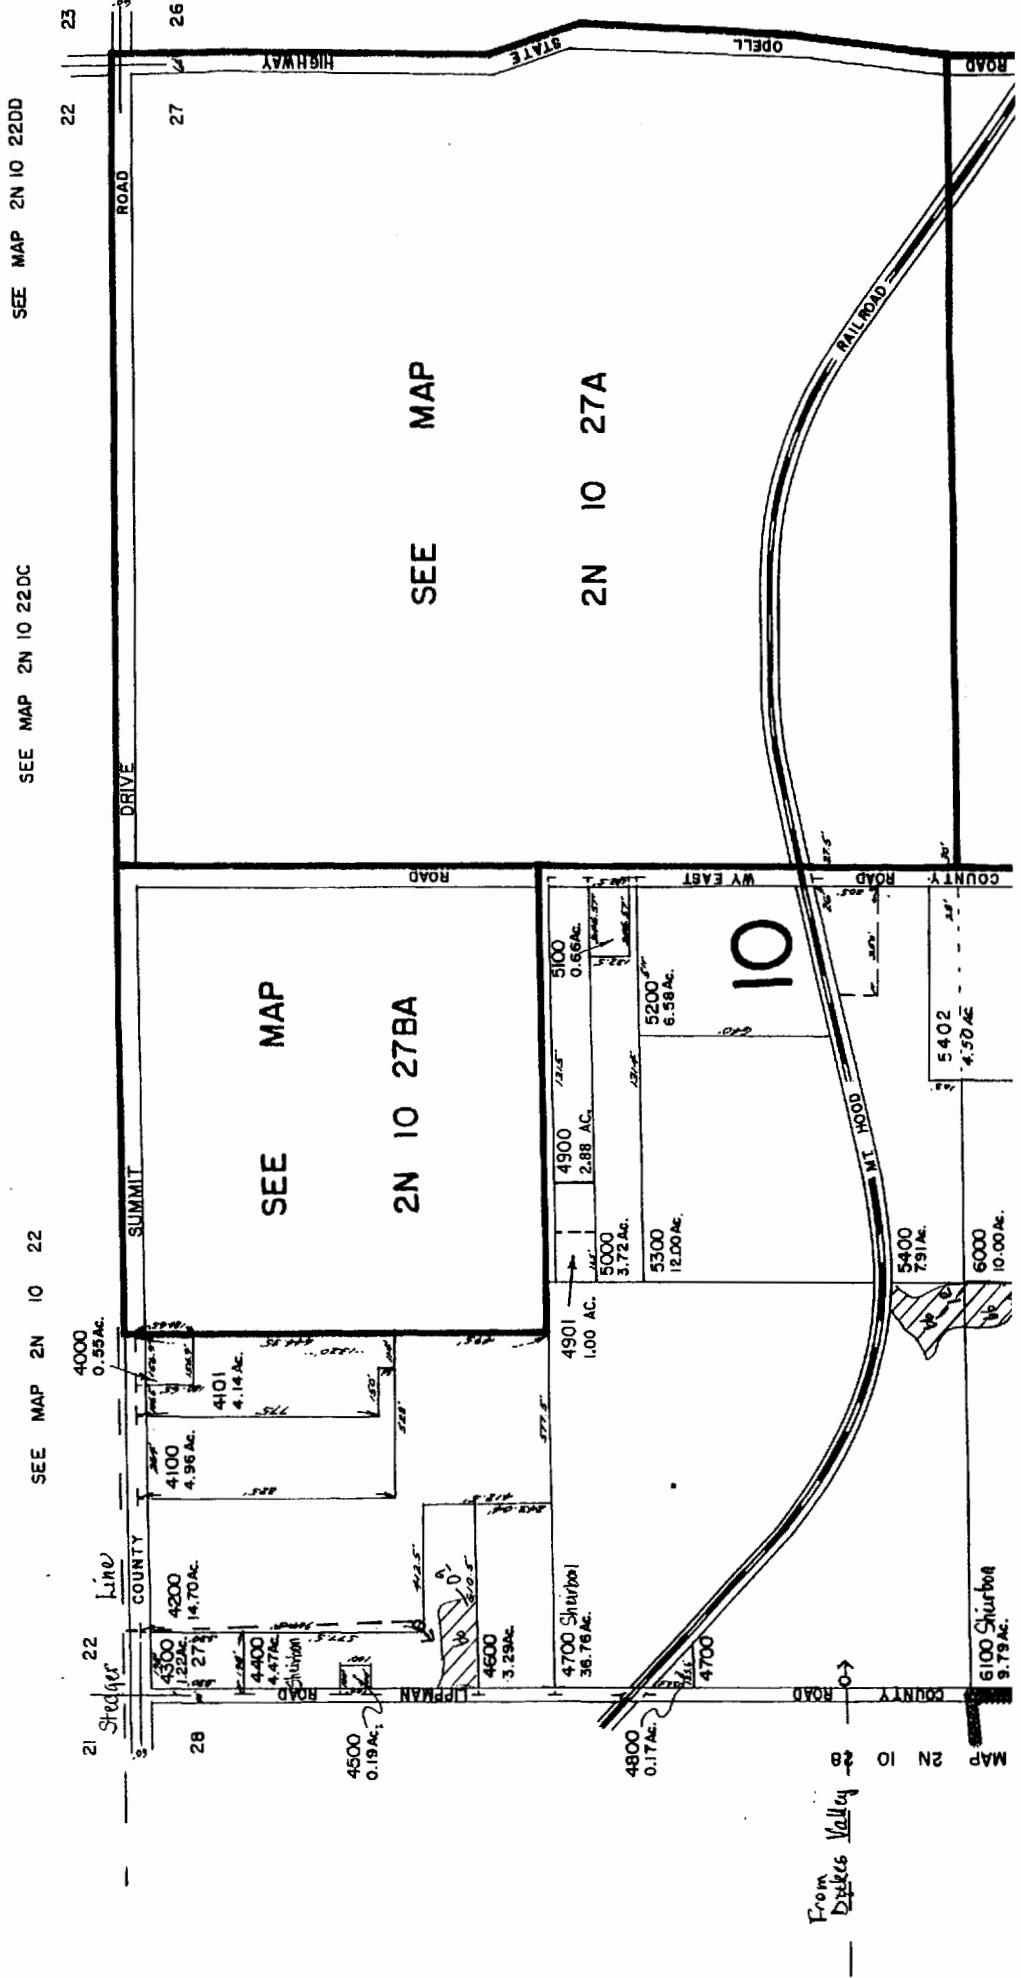

From  
Dixies Valley  
MAP 2N 10  
6100 Shurbo  
9.79 Ac.

Application No. 39634  
 Permit No. 29617  
 Certificate No. 80929  
 Map 40 of 72

SEE MAP 2N 10 26

RECEIVED


JUN 03 2002

WATER RESOURCES DIVISION  
 SALEM, OREGON

Map Legend	
Map Symbols	Turnout Box
Open Ditch	Pipelin
Property Lin	Water Right Certificate
Water Right Certificate	P - 2651
	P - 3082
	P - 3210
	P - 3268

East Fork Irrigation District Hood River, Oregon	
Section 2N-10-27	400
Scale 1" = 400	cms

35 2N 10 27  
 & INDEX  
 Revised 8/17/00, JD

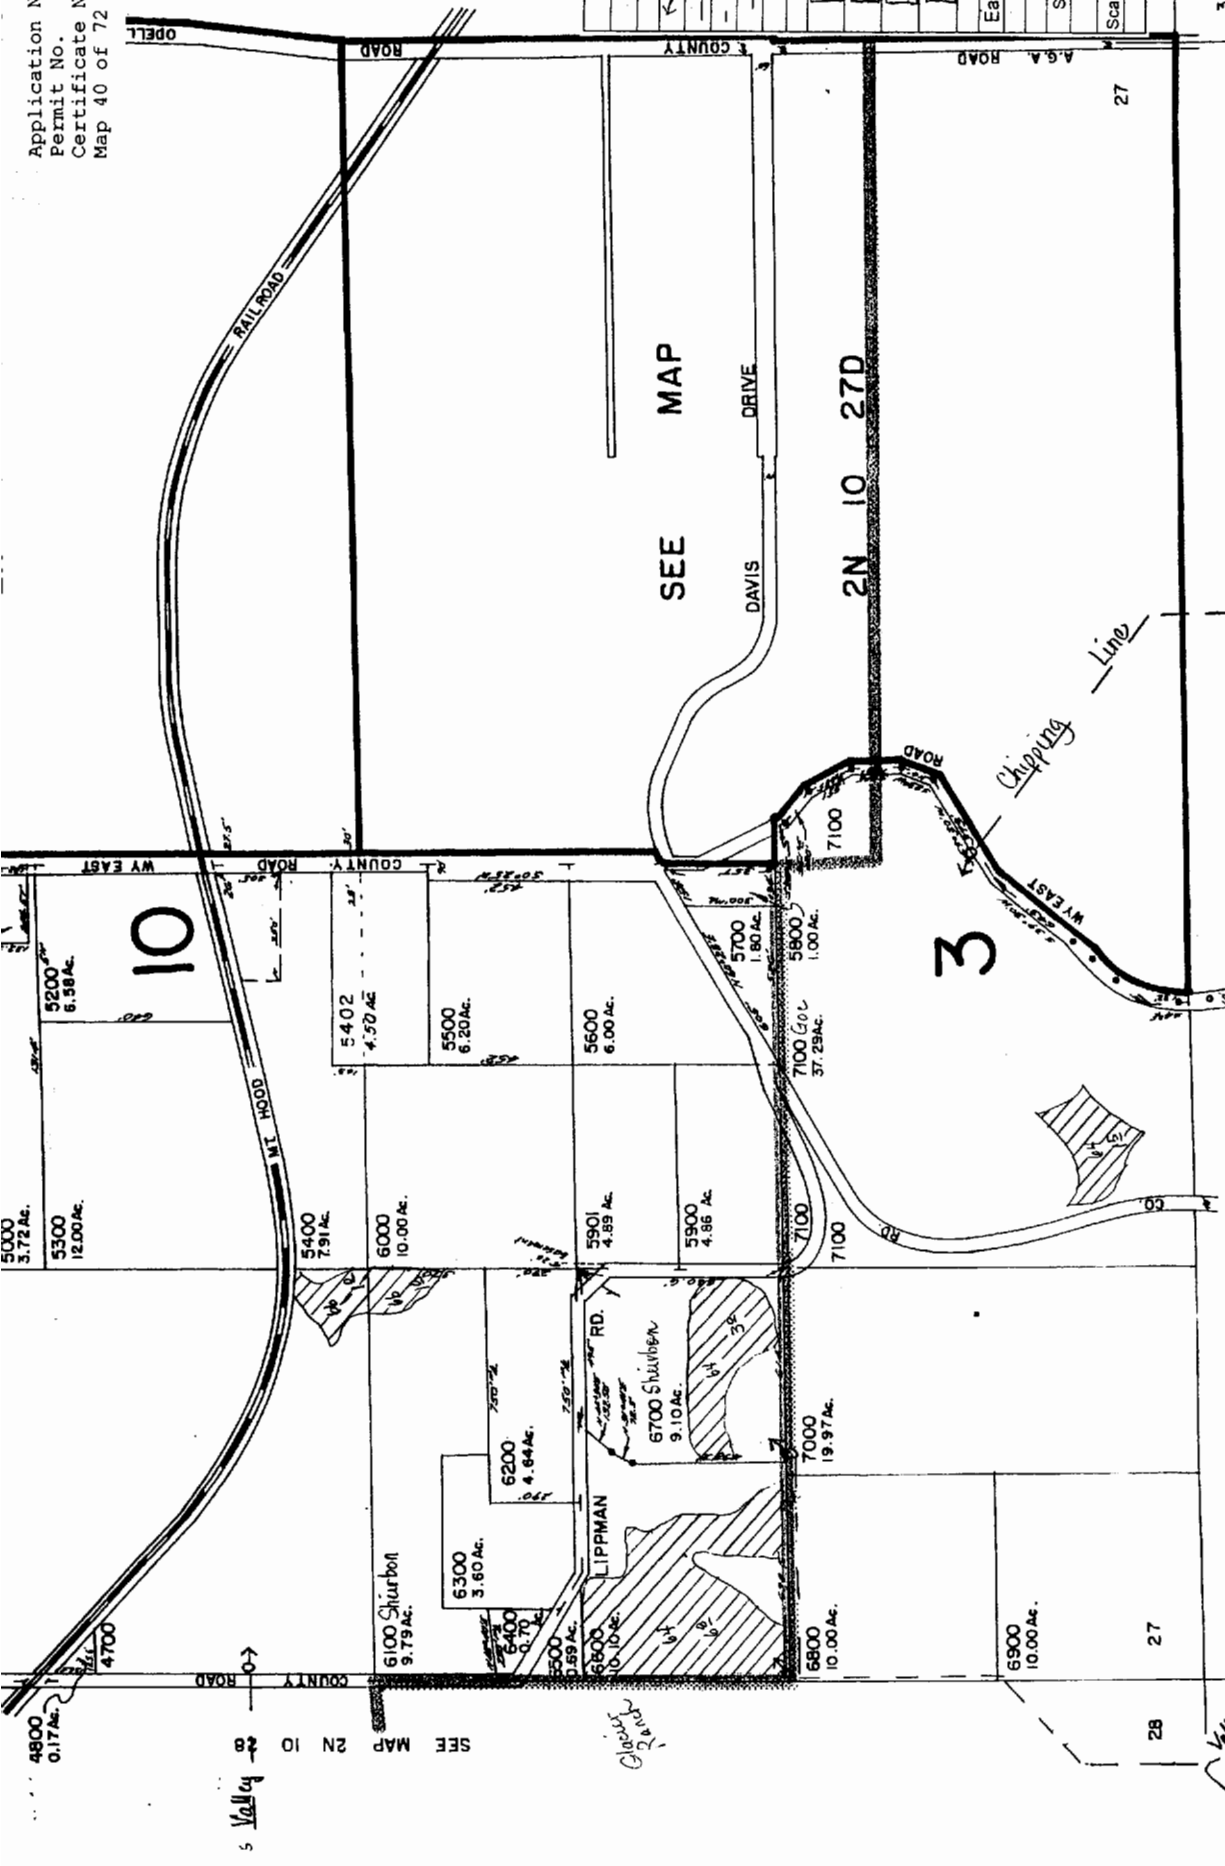

SEE MAP 2N 10 28

SEE MAP 2N 10 34

SEE MAP 2N 10 26

SEE MAP 2N 10 27

JUN 03 2002


WATER RESOURCES DEPT.  
SALEM, OREGON

SEE MAP 2N 10 26

Application No. 39634  
Permit No. 29617  
Certificate No. 80929  
800 Map 42 of 72

Map Legend	
Map Symbols	Property Lin
--- Turnout Bo	Water Right Certificate
--- Open Ditch	P - 2651
--- Pipeline	P - 3082
--- Property Lin	P - 3210
	P - 3268
East Fork Irrigation District Hood River, Oregon	
Section 2N-10-27D	
Scale 1" = 300 cms	

35  
2N 10 27D

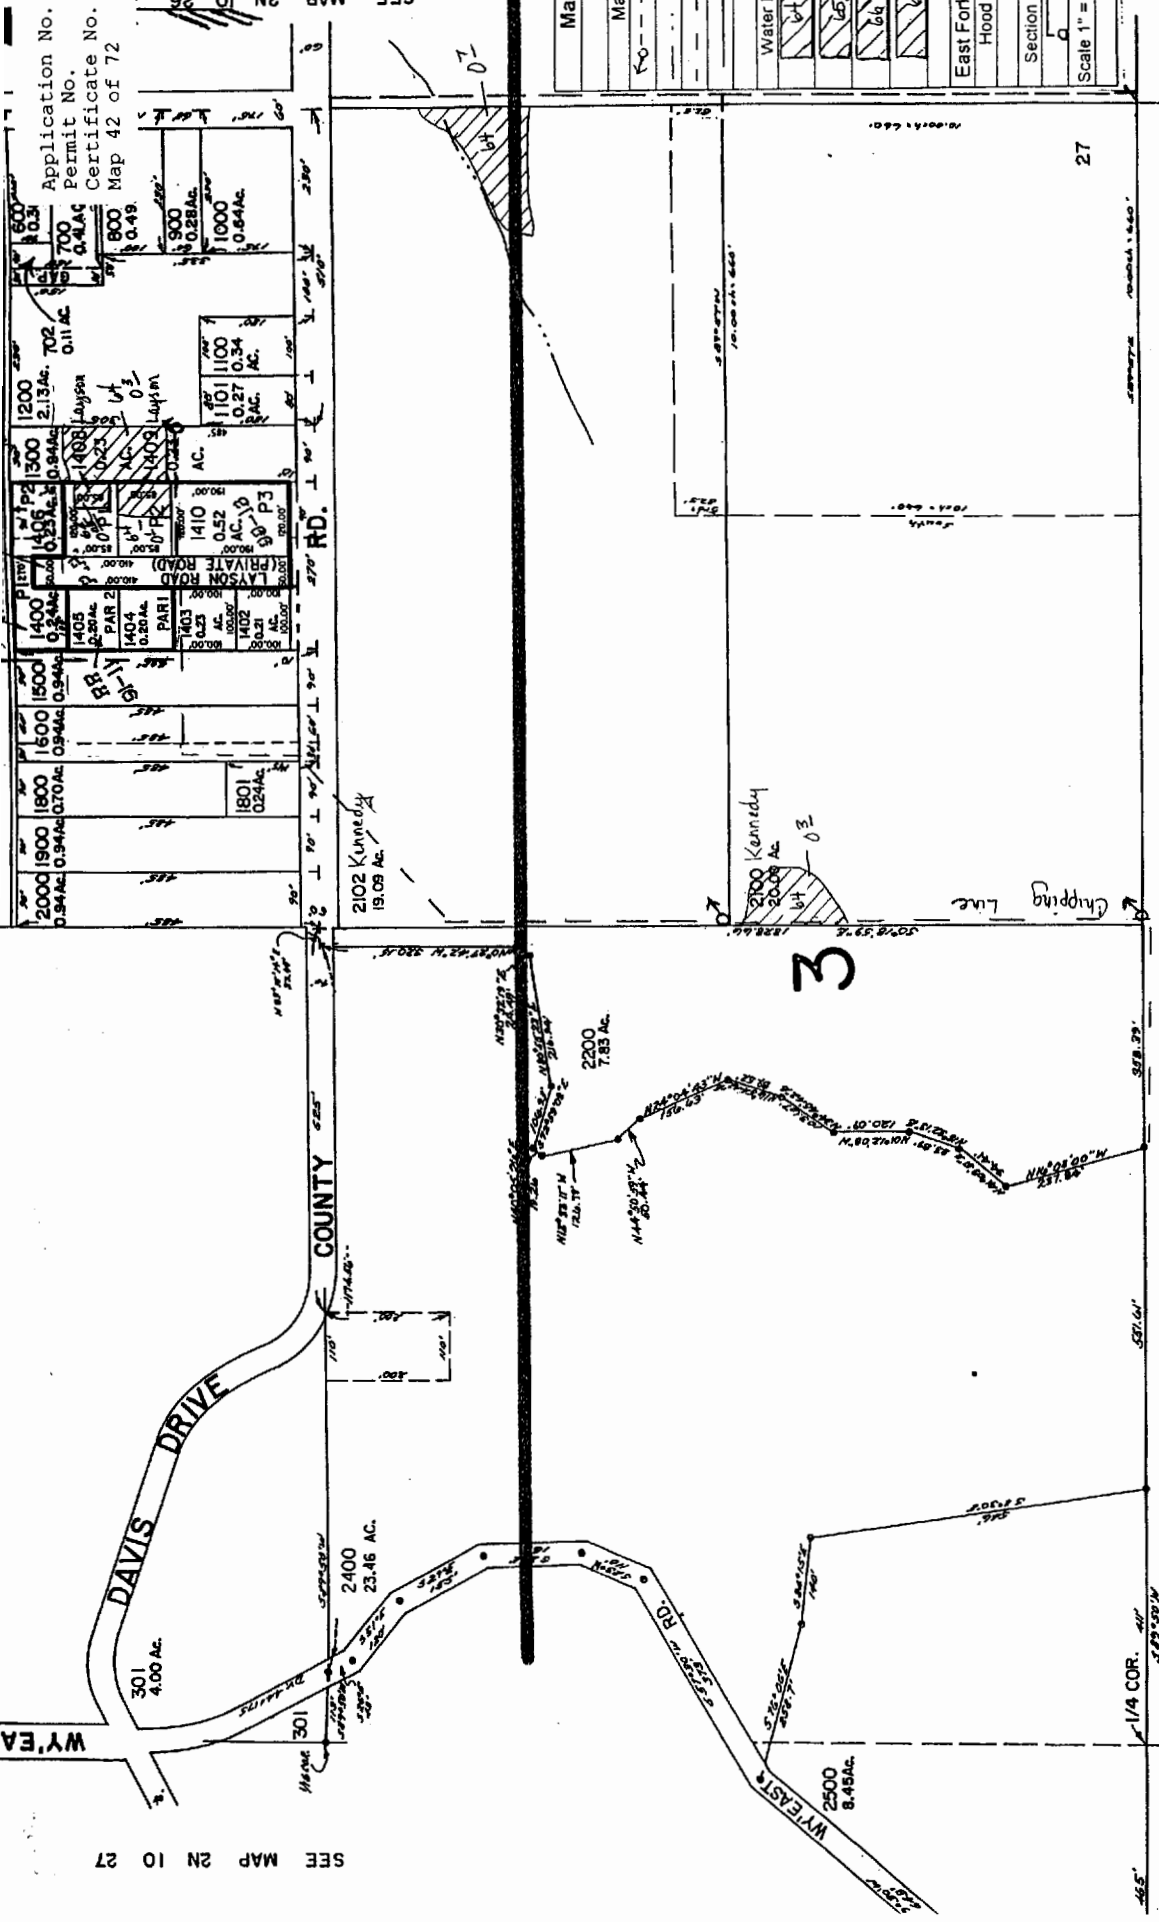

34

SEE MAP 2N 10 34

SEE MAP 2N 10 27

SECTION 33 T.02N. R.10E. W.M.  
HOOD RIVER COUNTY


1"=400'

THIS MAP WAS PREPARED FOR  
ASSESSMENT PURPOSE ONLY


Application No. 39634  
Permit No. 29617  
Certificate No. 80929  
Map 43 of 72

SEE MAP 02N 10 28

JUN 15 1994  
WATER RESOURCES DEPT.  
SALEM, OREGON

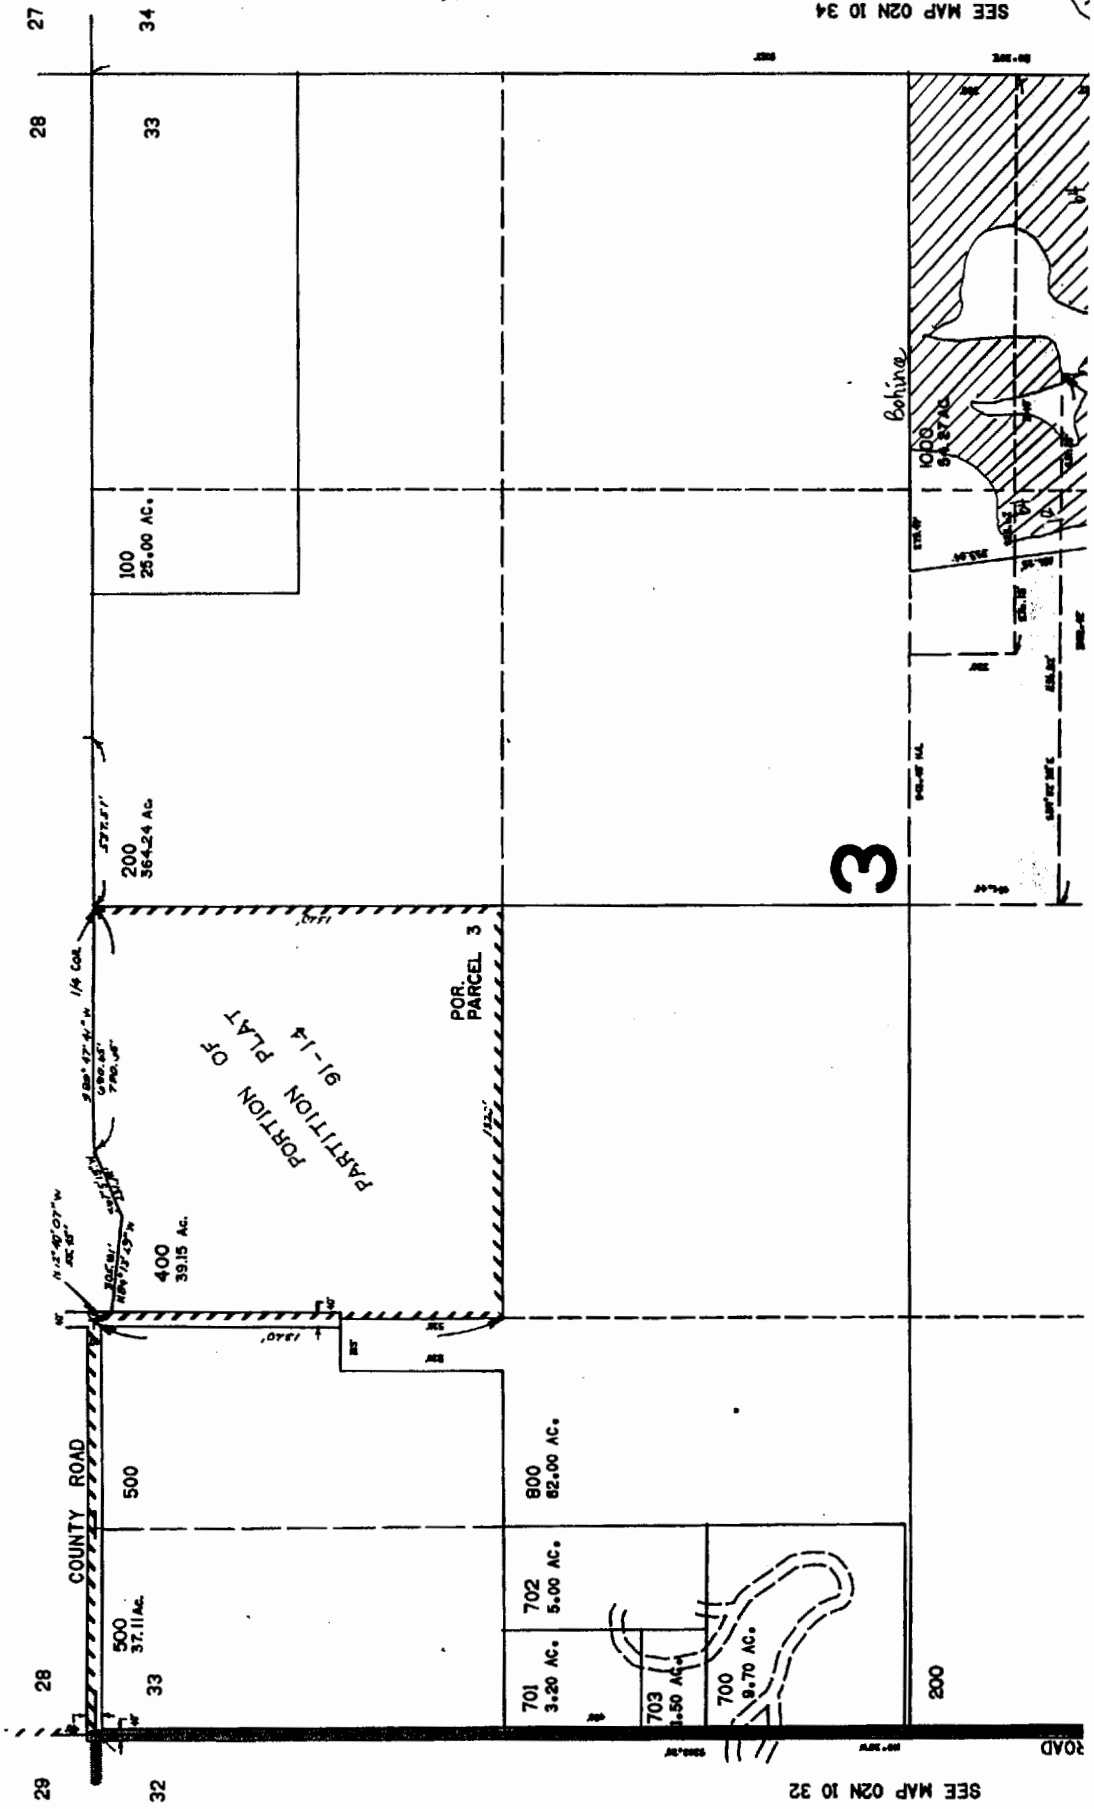

- CANCELLED
- 301
- 300
- 300
- 300
- 1002
- 600
- 401
- 1103
- 1104
- 1105
- 1100

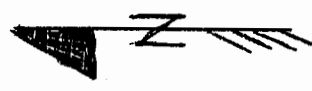

SEE MAP 02N 10 34


SEE MAP 02N 10 32

3

Application No. 39634  
 Permit No. 29617  
 Certificate No. 80929  
 Map 44 of 72

**RECEIVED**  
 JUN 03 2002  
 WATER RESOURCES DEPT.  
 SALEM, OREGON

SEE MAP 02N 10 34

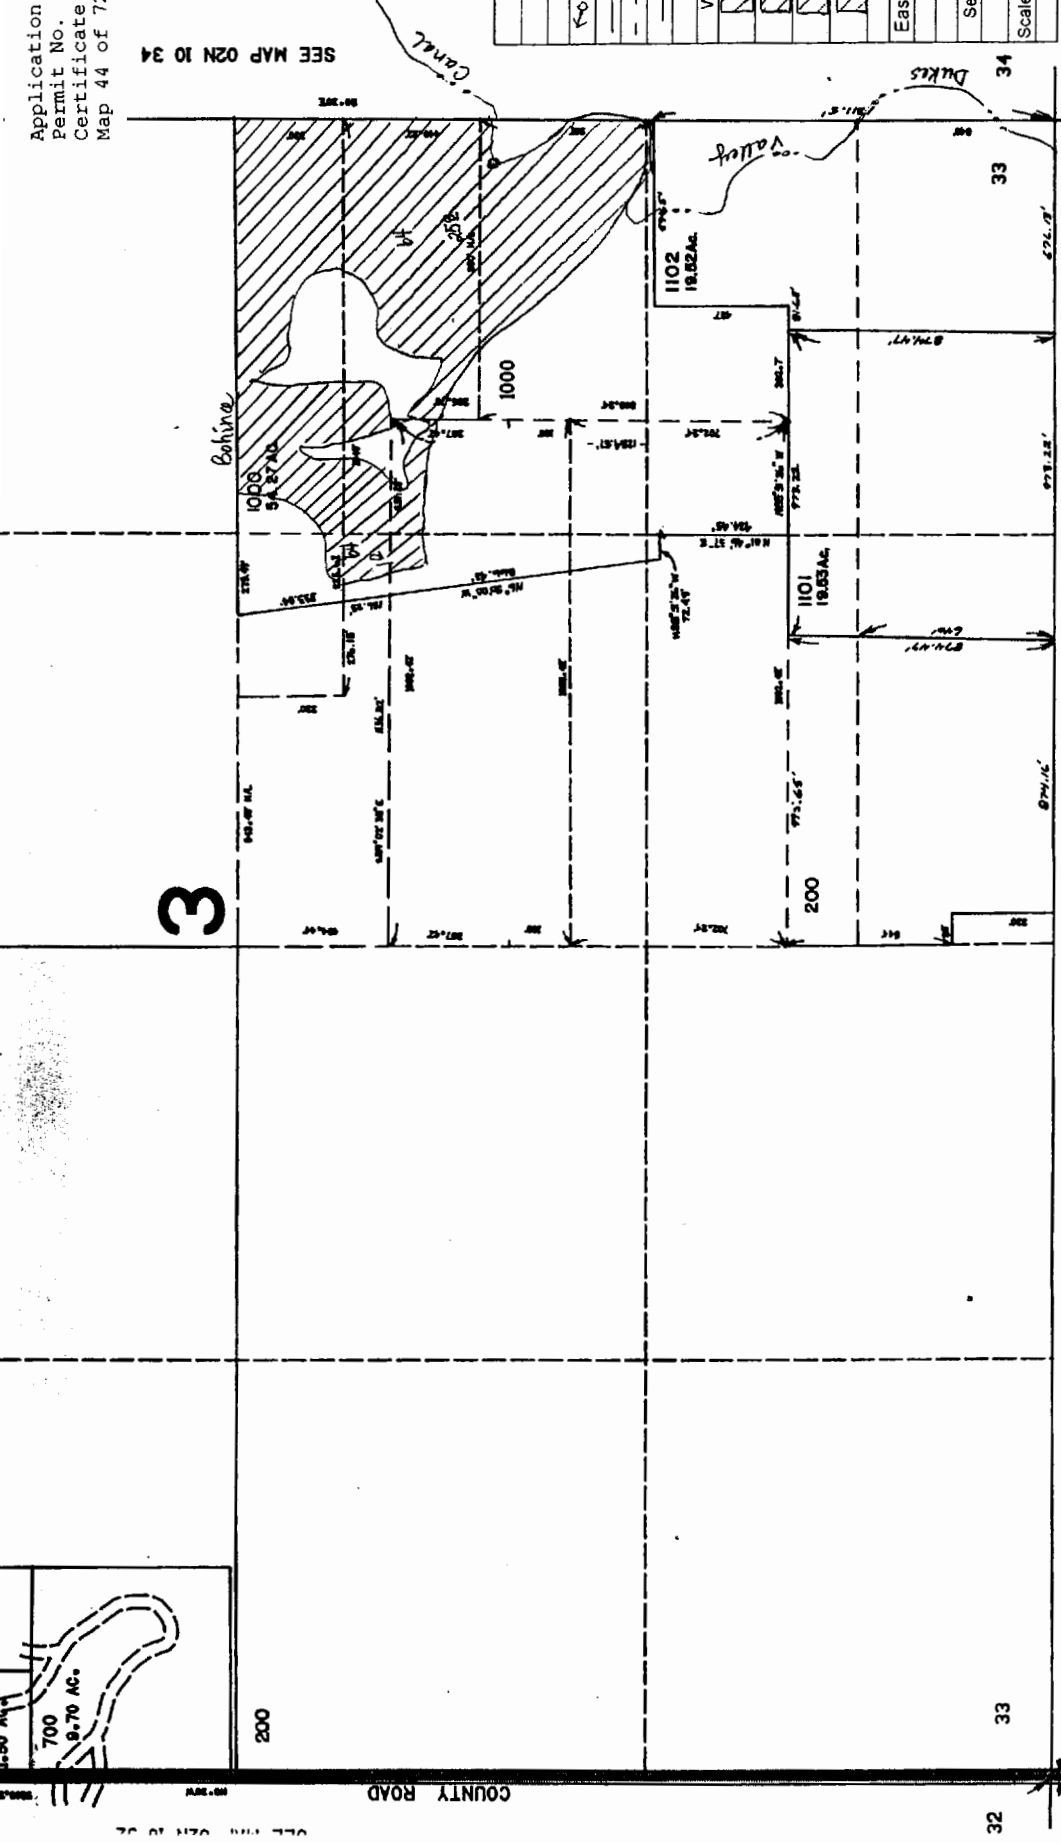

Map Legend	
Map Symbols	
	Turnout Box
	Open Ditch
	Pipeline
	Property Line
Water Right Certificate	
	P - 26517
	P - 30825
	P - 32101
	P - 32685
East Fork Irrigation District Hood River, Oregon	
Section 2N-10-33	
	Scale 1" = 400' cms

SEE MAP 01N 10 04

02N 10 33


Application No. 39634  
 Permit No. 29617  
 Certificate No. 80929  
 Map 45 of 72

Section 34 T2N R10E WM  
 Hood River County

1"=400'

JUN 03 2002

WATER RESOURCES DEPT.  
 SALEM, OREGON

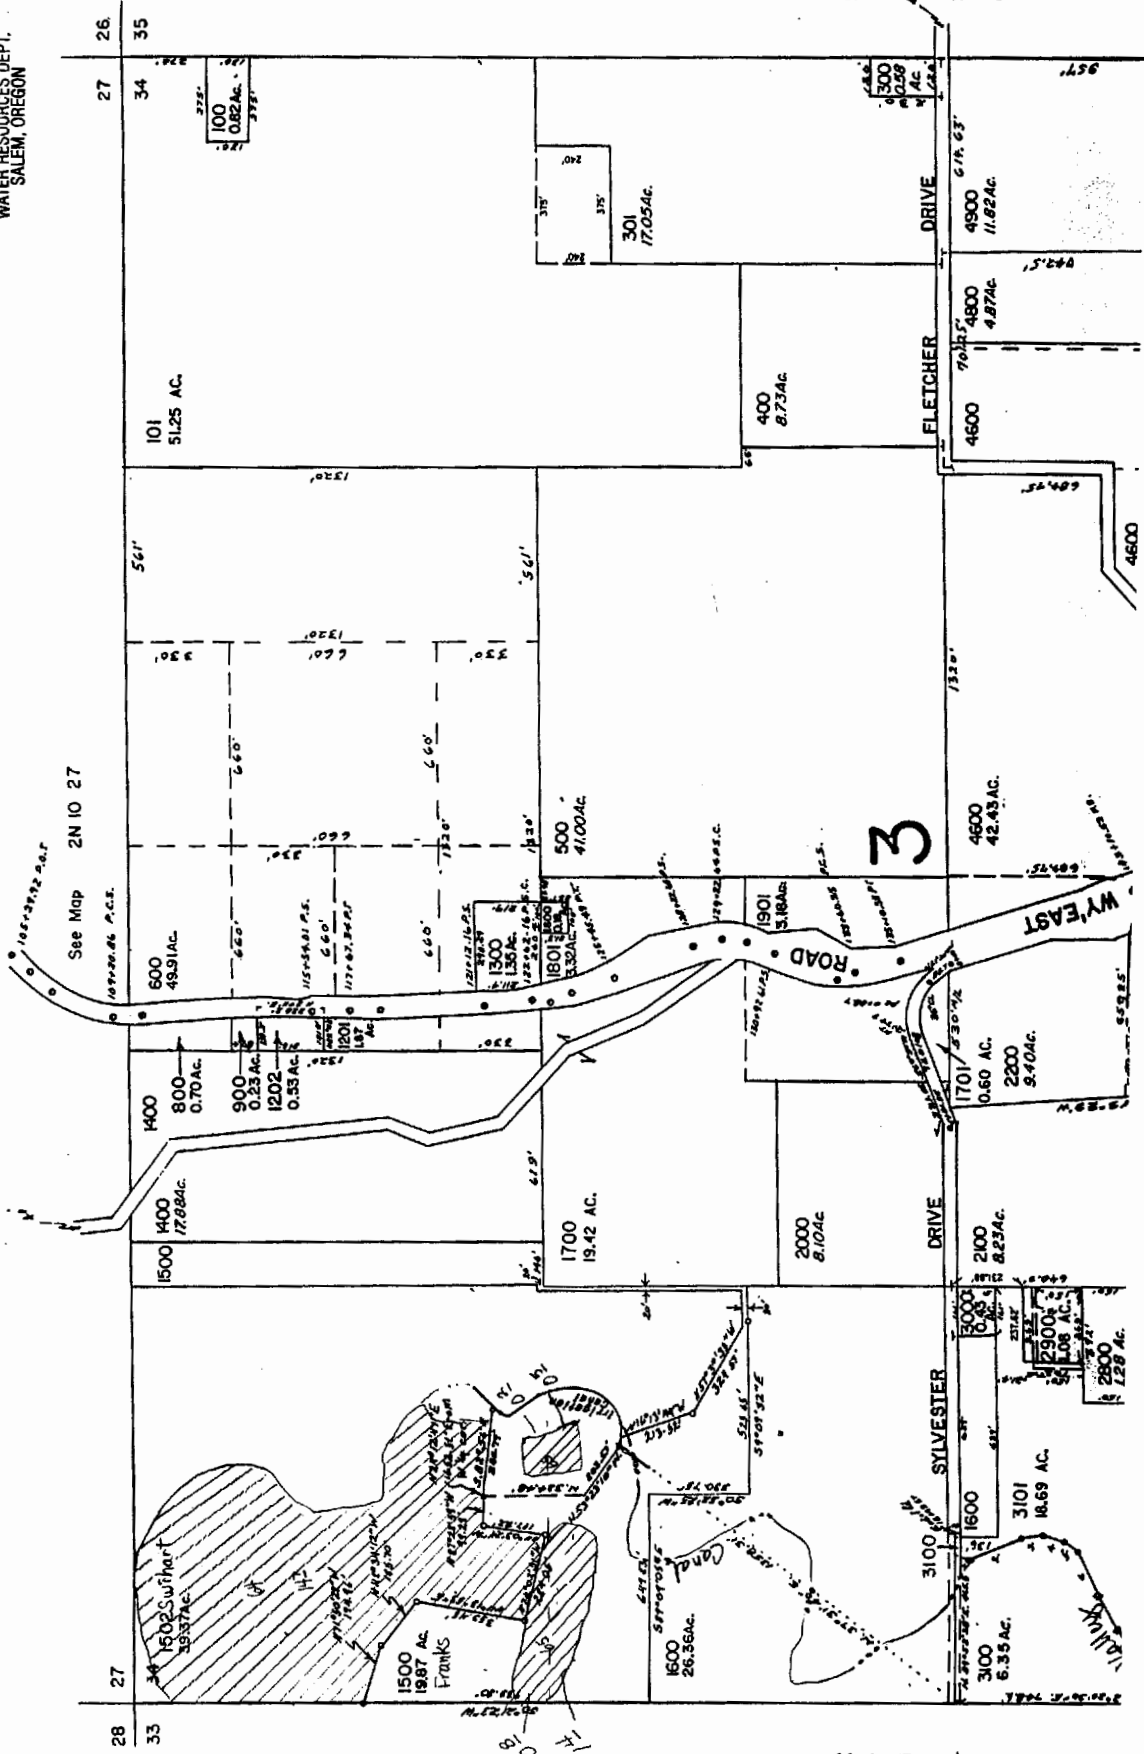

PREPARED FOR  
 THIS PURPOSE ONLY

T. L. 3100  
 1500 1987 AC FRANKS  
 1600 26.36 AC  
 1700 19.42 AC  
 1901 3.18 AC  
 2000 8.10 AC  
See Map 2N 10 33

See Map 2N 10 35


CANCELL  
 290  
 310  
 360  
 300  
 300  
 100  
 300  
 150  
 230  
 190  
 700  
 110  
 120  
 20

Application No. 39634  
 Permit No. 29617  
 Certificate No. 80929  
 Map 46 of 72

See Map 2N 10 33

RECEIVED  
 JUN 03 2002  
 WATER RESOURCES DEPT.  
 SALEM, OREGON

Map Legend	
Map Symbols	
Turnout Box	—
Open Ditch	---
Pipeline	---
Property Line	---
Water Right Certificate	
64	P - 26517
65	P - 30825
66	P - 32101
67	P - 32685
East Fork Irrigation District Hood River, Oregon	
Section 2N-10-34	
0	400
100	400
Scale 1" = 400 cms	

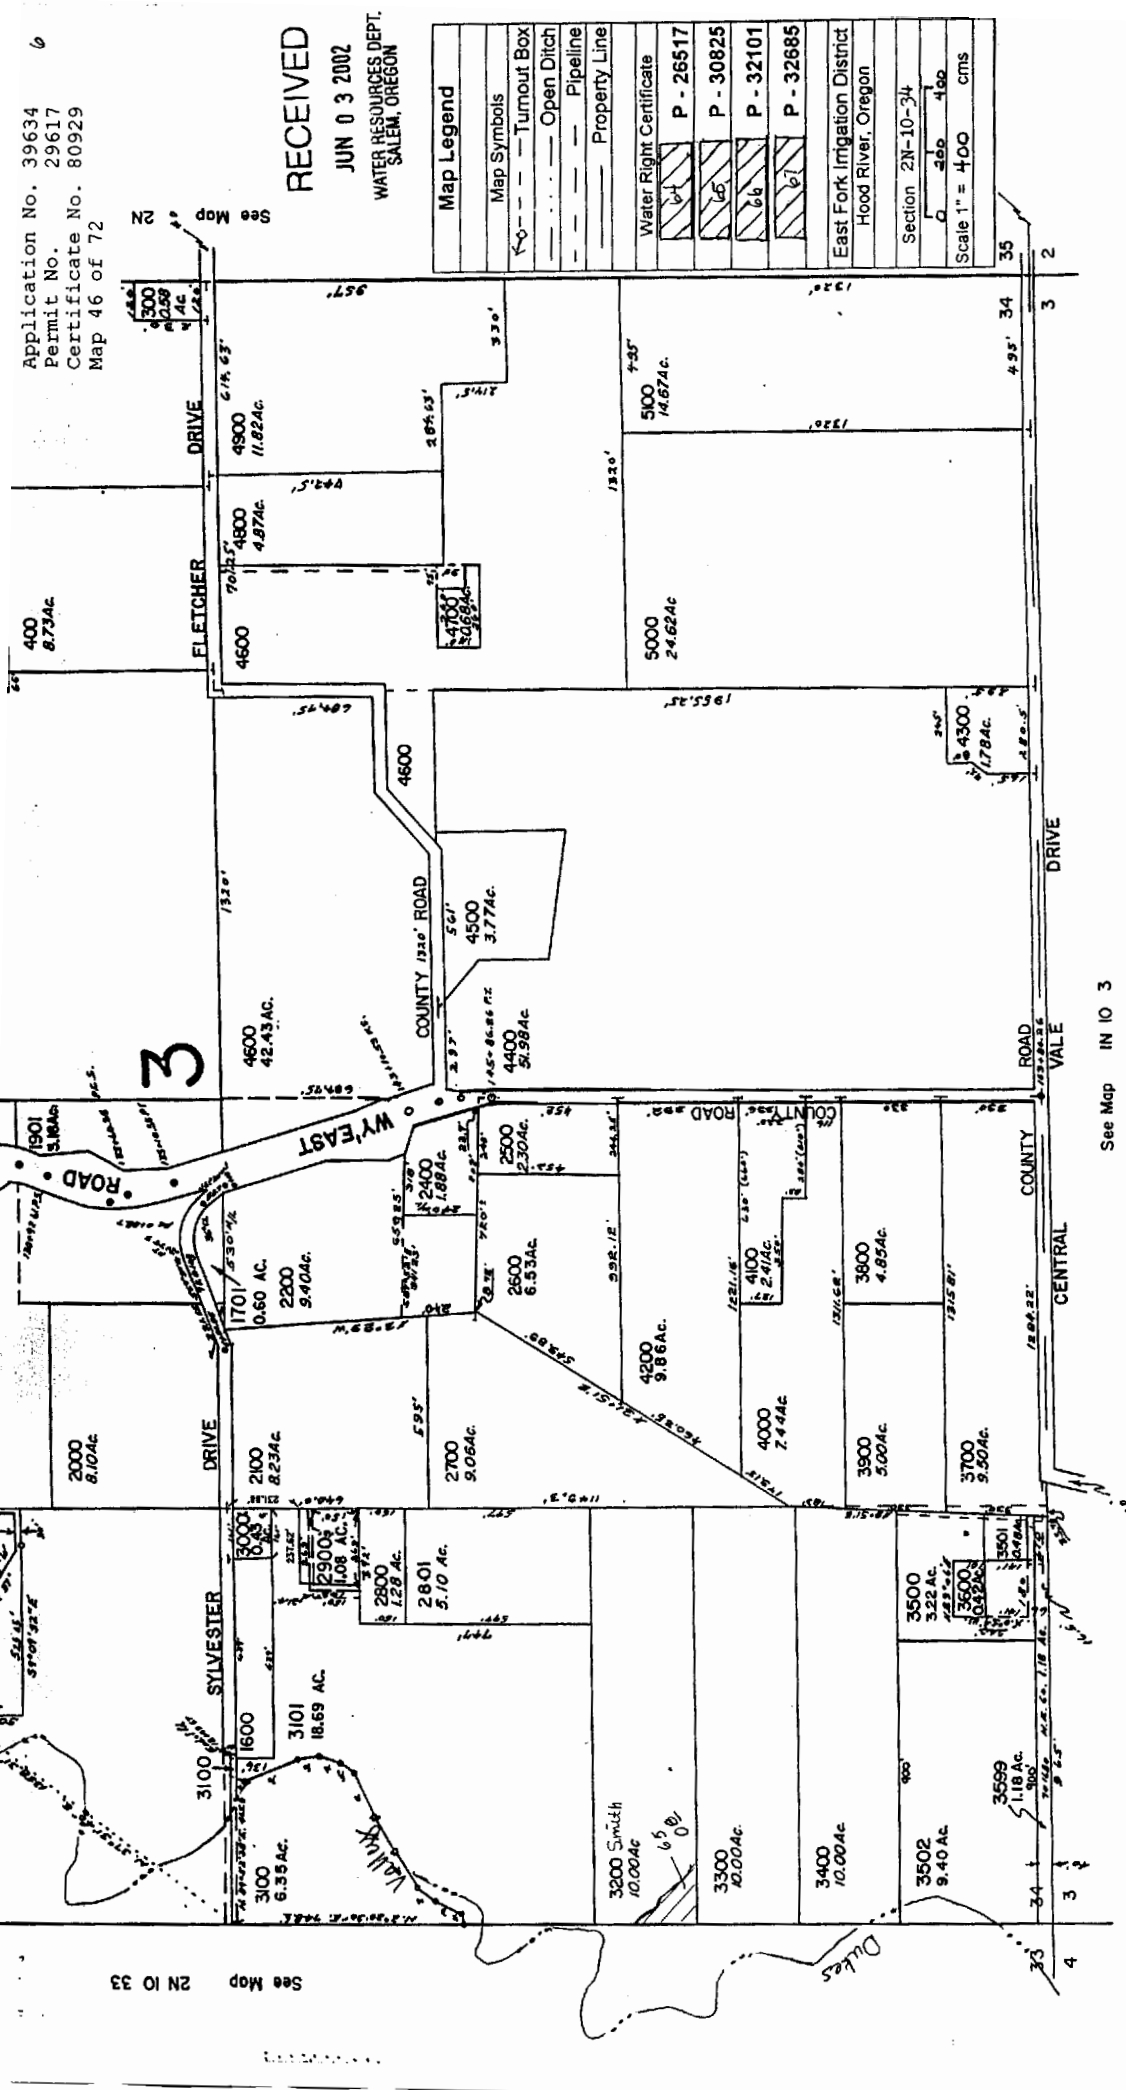

See Map IN 10 3

2N 10 34


REVISED 3-2-99, JD



Application No. 39634  
 Permit No. 29617  
 Certificate No. 80929  
 Map 48 of 72

RECEIVED  
 JUN 13 2002  
 WATER RESOURCES DEPT.  
 SALEM, OREGON

Map Legend	
Map Symbols	
	Turnout Box
	Open Ditch
	Pipeline
	Property Line
Water Right Certificate	
	P - 26517
	P - 30825
	P - 32101
	P - 32685
East Fork Irrigation District Hood River, Oregon	
Section 2N-10-35	
	456
	456
Scale 1" = 400 cms	

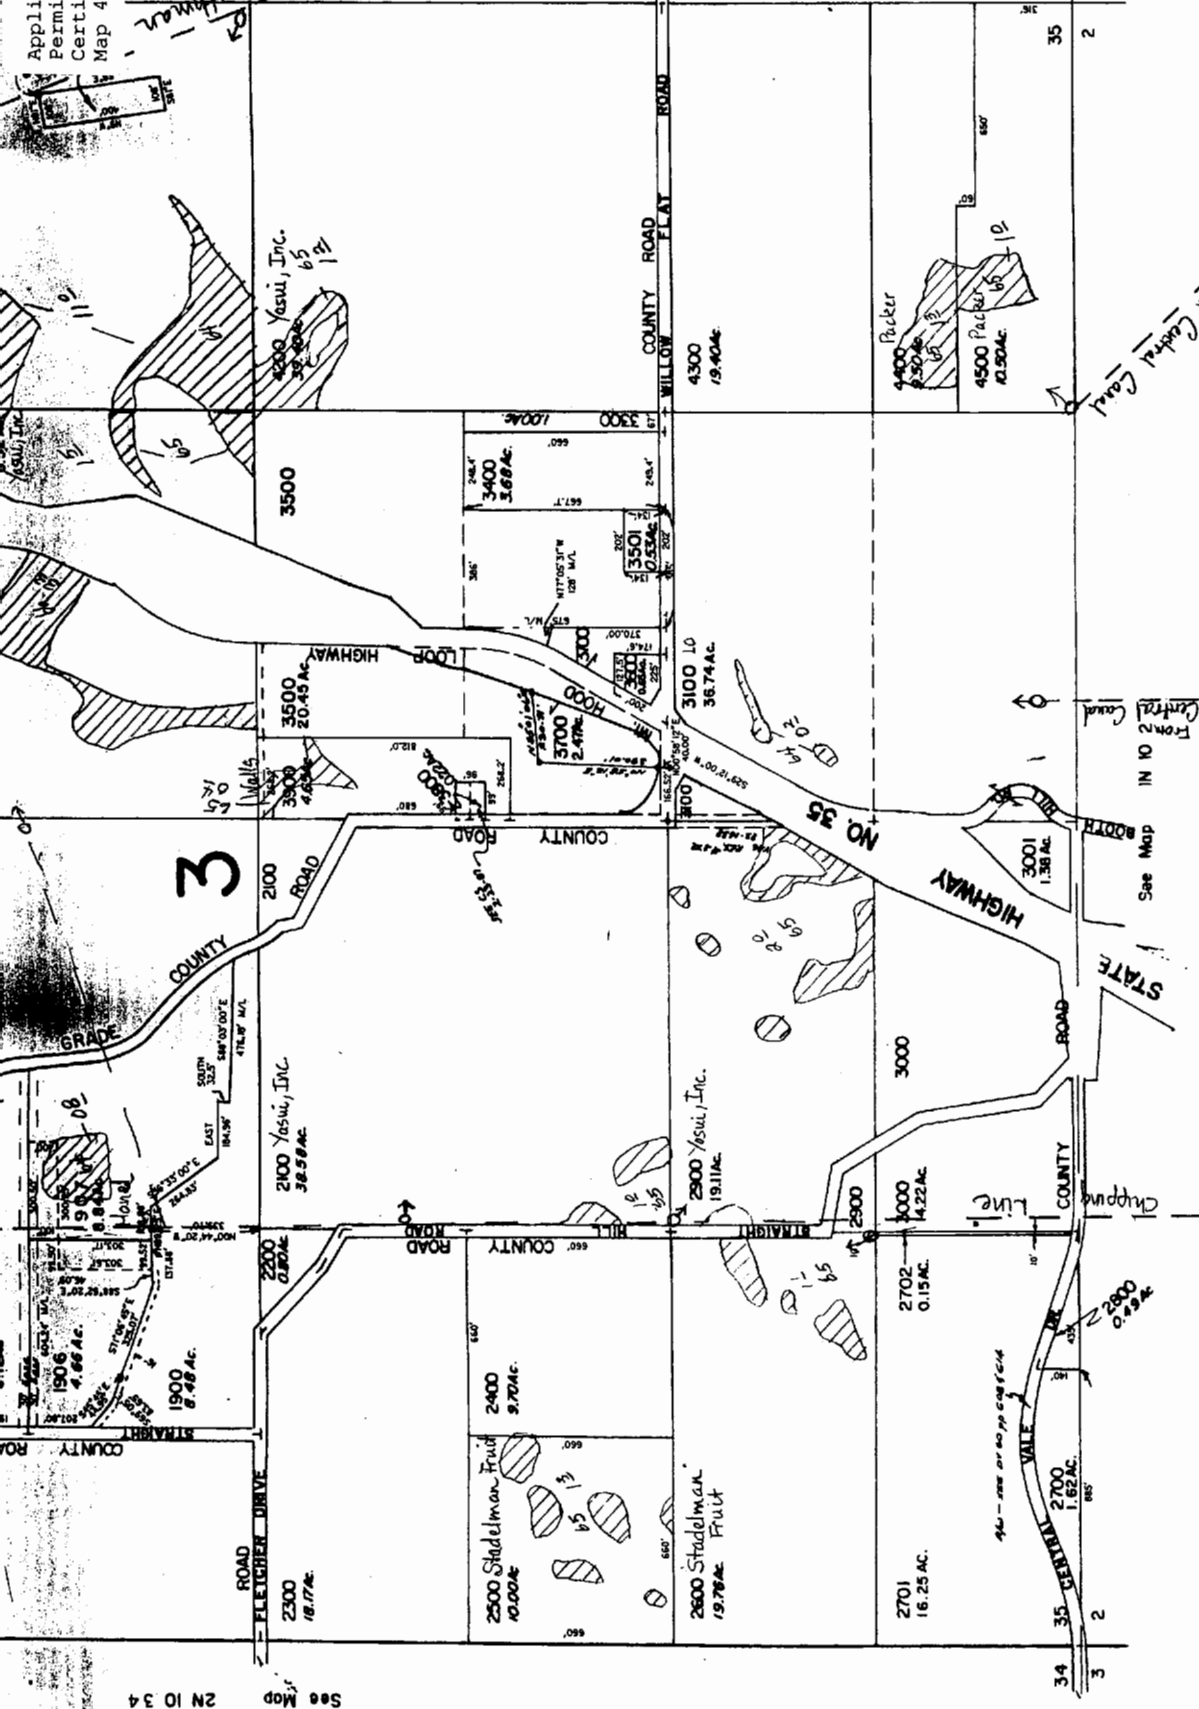

2N 10 35

REVISED 5-10-99, JD

See Map 2N 10 34

See Map IN 10 2  
 From Central Canal






Application No. 39634  
 Permit No. 29617  
 Certificate No. 80929  
 Map 50 of 72

RECEIVED  
 JUN 03 2002  
 WATER RESOURCES DEPT.  
 SALEM, OREGON

Map Legend	
Map Symbols	
	Turnout Box
	Open Ditch
	Pipeline
	Property Line
Water Right Certificate	
	P - 26517
	P - 30825
	P - 32101
	P - 32685
East Fork Irrigation District Hood River, Oregon	
Section 2N-10-36	
	0 100 200 300 400
Scale 1" = 400 cms	

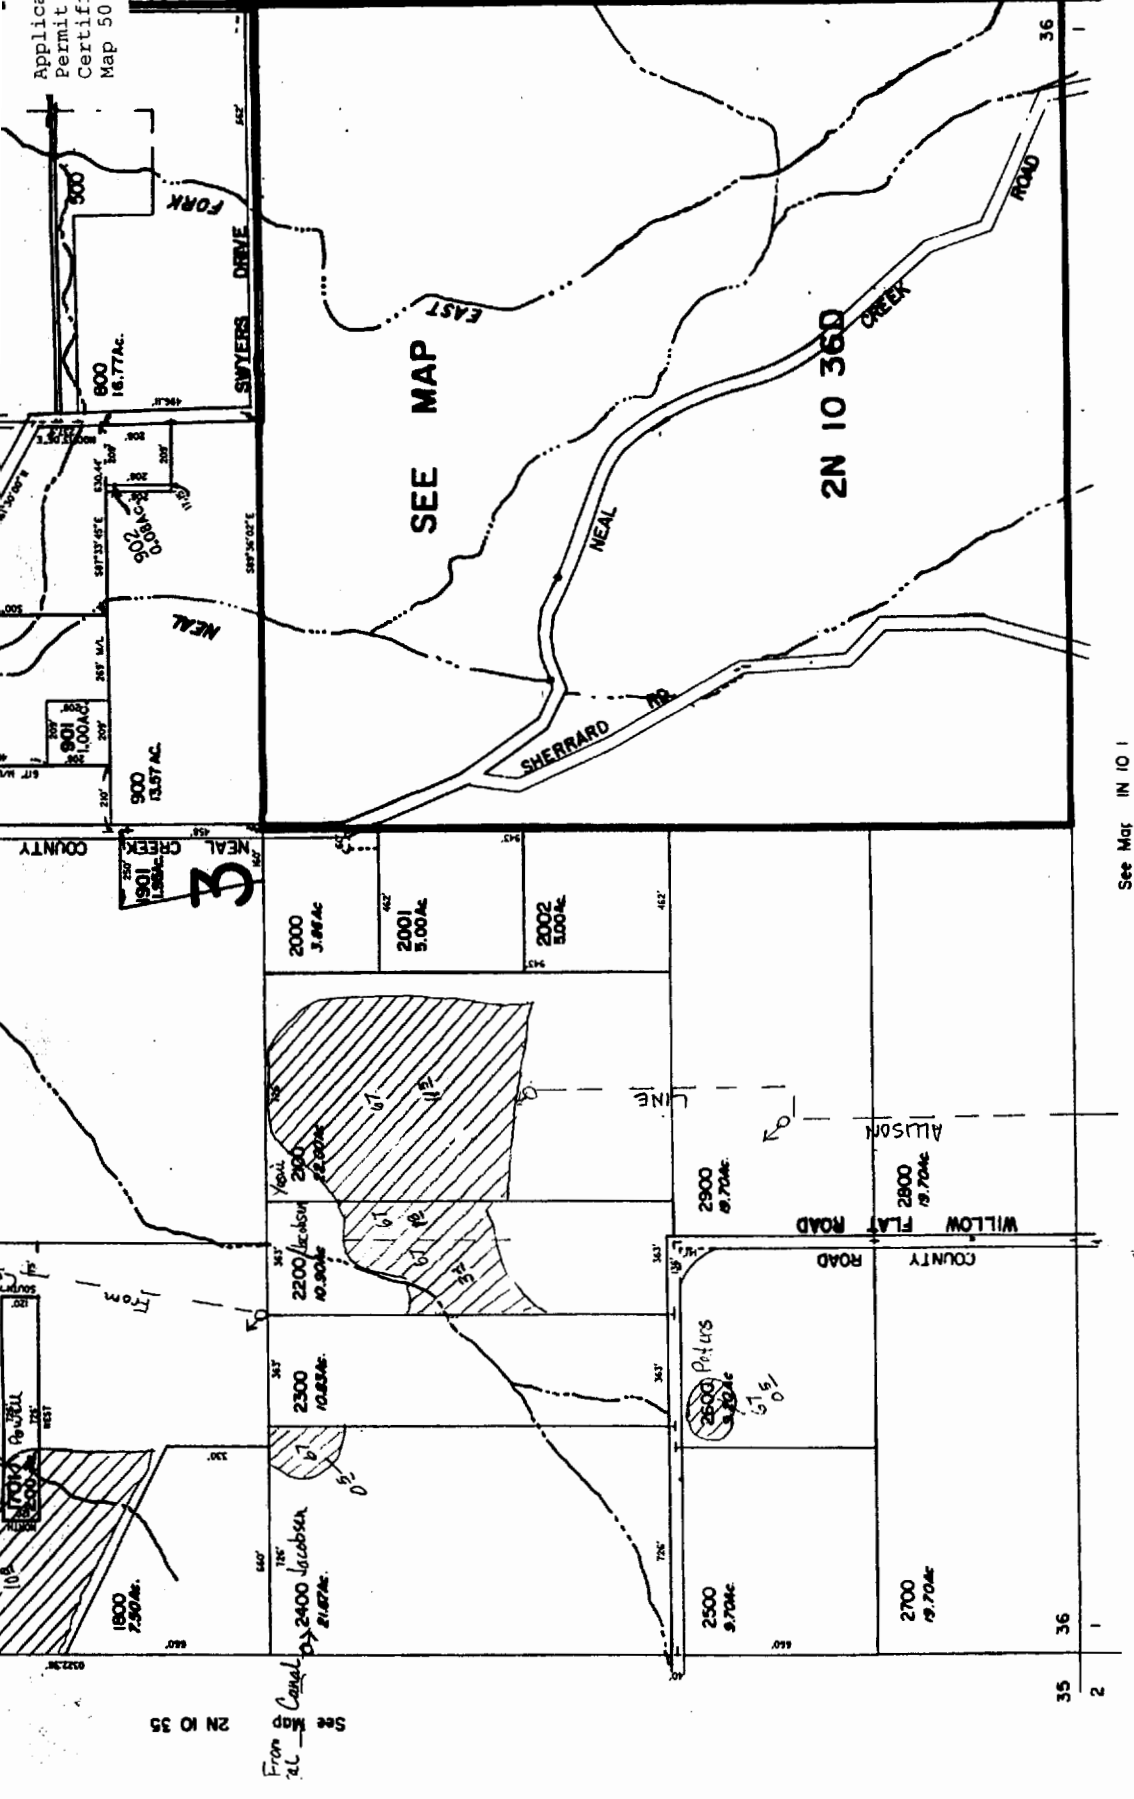

2N 10 36  
 REVISED 10-4-96, LC

See Map IN 10 1

See Map 2N 10 35

From Canal  
 2400 Jacobsen  
 21.67 ac.

2500  
 9.70 ac

2900  
 19.70 ac

2800  
 19.70 ac

2200  

2300  
 10.85 ac

 7.50 ac

2000  
 3.86 ac

2001  
 5.00 ac

2002  
 5.00 ac







NE1/4SE1/4 SEC. 36 T.2N. R.10E. W.M.  
HOOD RIVER COUNTY


THIS MAP WAS PREPARED FOR  
ASSESSMENT PURPOSE ONLY

Application No. 39634  
Permit No. 29617  
Certificate No. 80929  
Map 51 of 72

JUN 0 3 2002  
WATER RESOURCES DEPT.  
SALEM, OREGON

1" = 100'

SEE MAP 2N 10 36

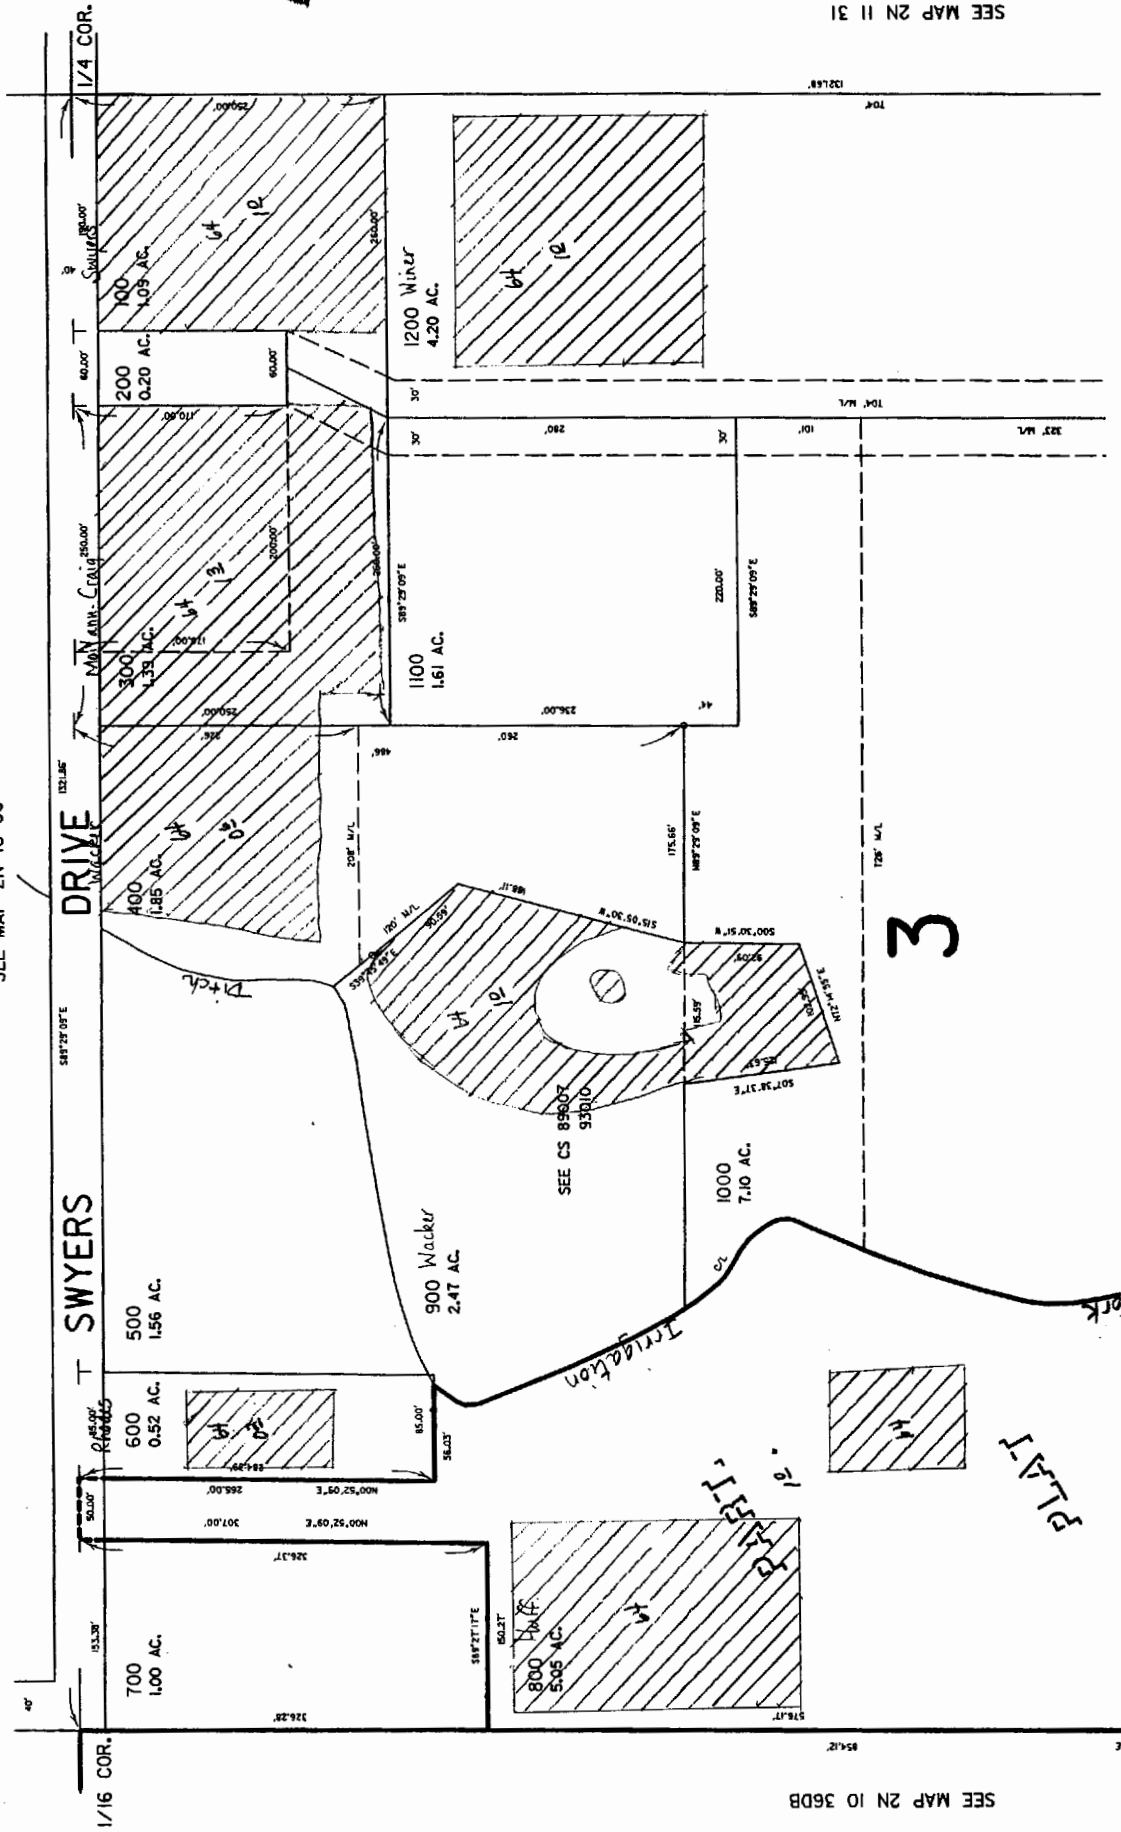

SEE MAP 2N 10 36DB

SEE MAP 2N 11 31

3

PLAT 1




DRIVE


SWYERS

Irrigation

pk

1/4 COR.

1/16 COR.

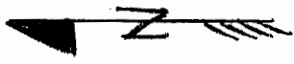


Application No. 39634  
 Permit No. 29617  
 Certificate No. 80929  
 Map 52 of 72

**RECEIVED**  
 JUN 13 2002  
 WATER RESOURCES DEPT.  
 SALEM, OREGON

SEE MAP 2N 10 31

Map Legend	
	Turnout Box
	Open Ditch
	Pipeline
	Property Line
Water Right Certificate	
	P - 26517
	P - 30825
	P - 32101
	P - 32685
East Fork Irrigation District Hood River, Oregon	
Section 2N-10-36DA	
Scale 1" = 100' cms	

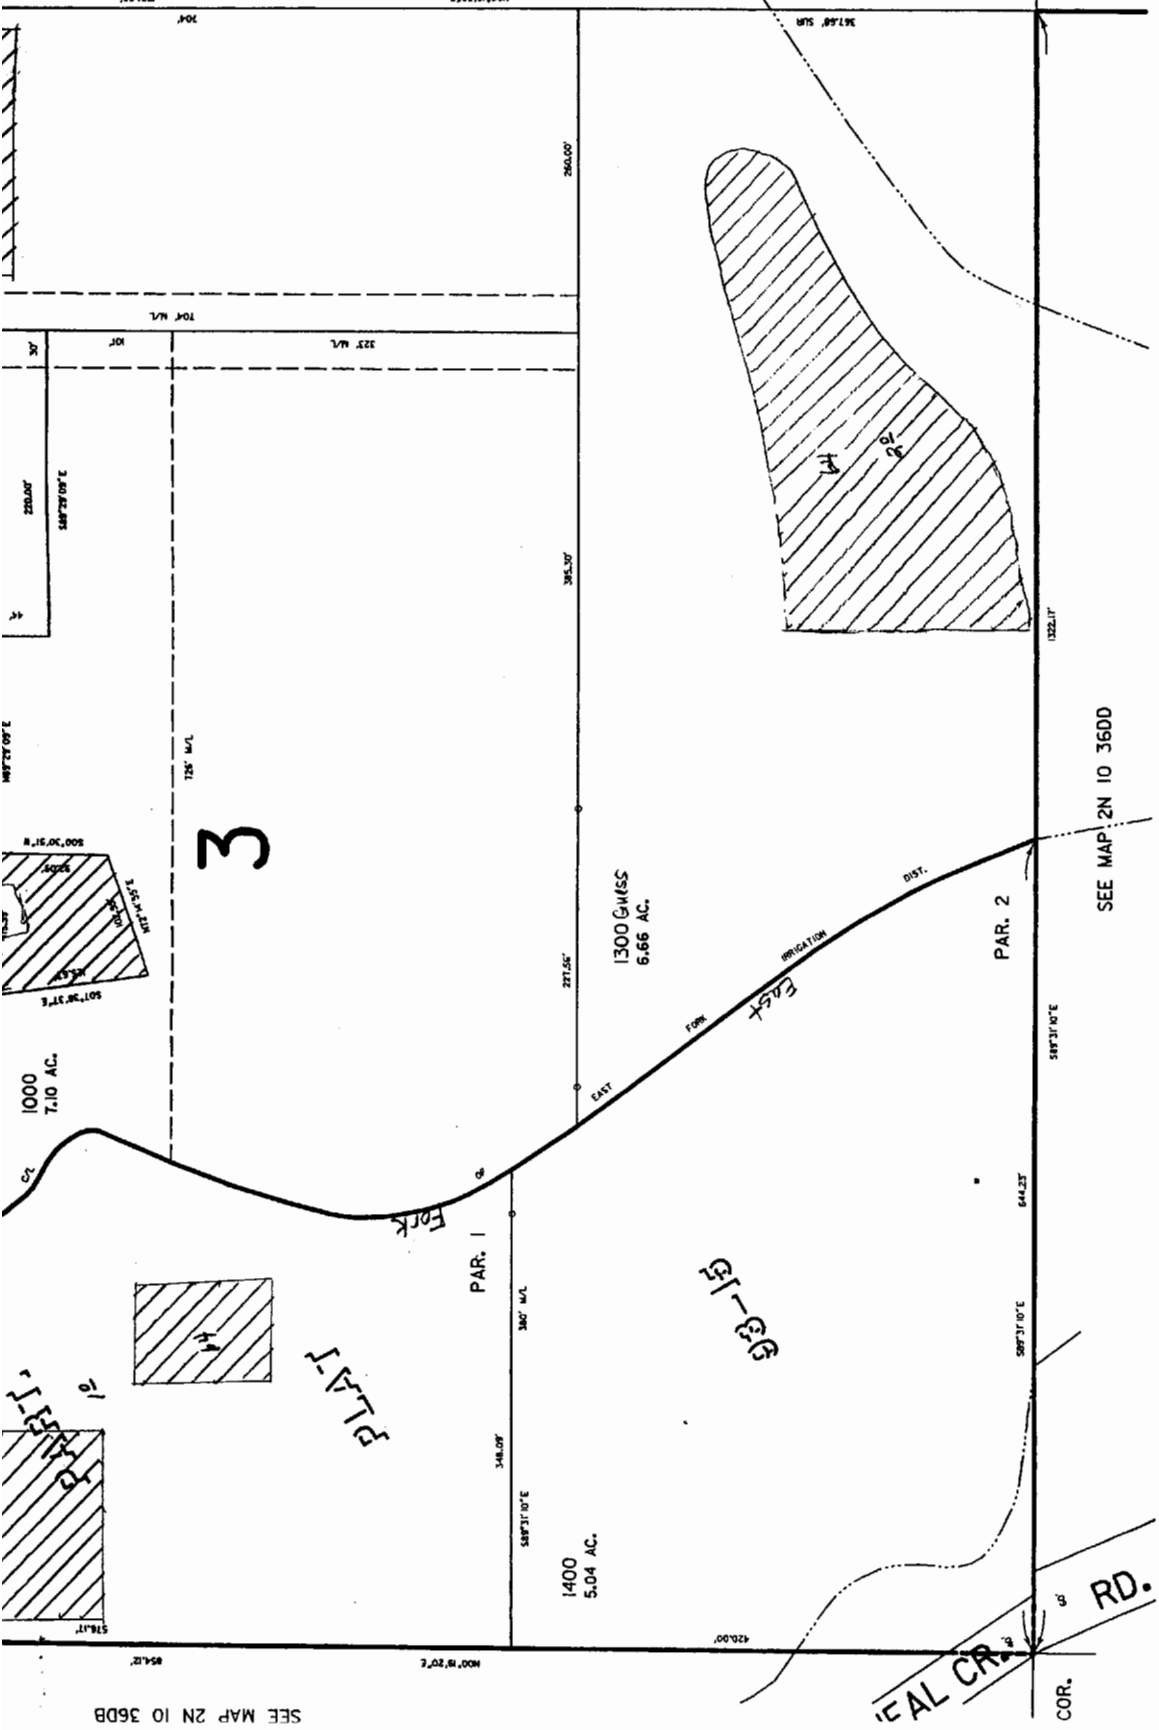

**3**

**13-36-2N**

SEE MAP 2N 10 36DD

SEE MAP 2N 10 36DB

2N 10 36DA


Revised 7/24/00, JD

1/16 COR.



Application No. 39634  
 Permit No. 29617  
 Certificate No. 80929  
 Map 54 of 72

WATER RESOURCES DEPT.  
 SALEM, OREGON

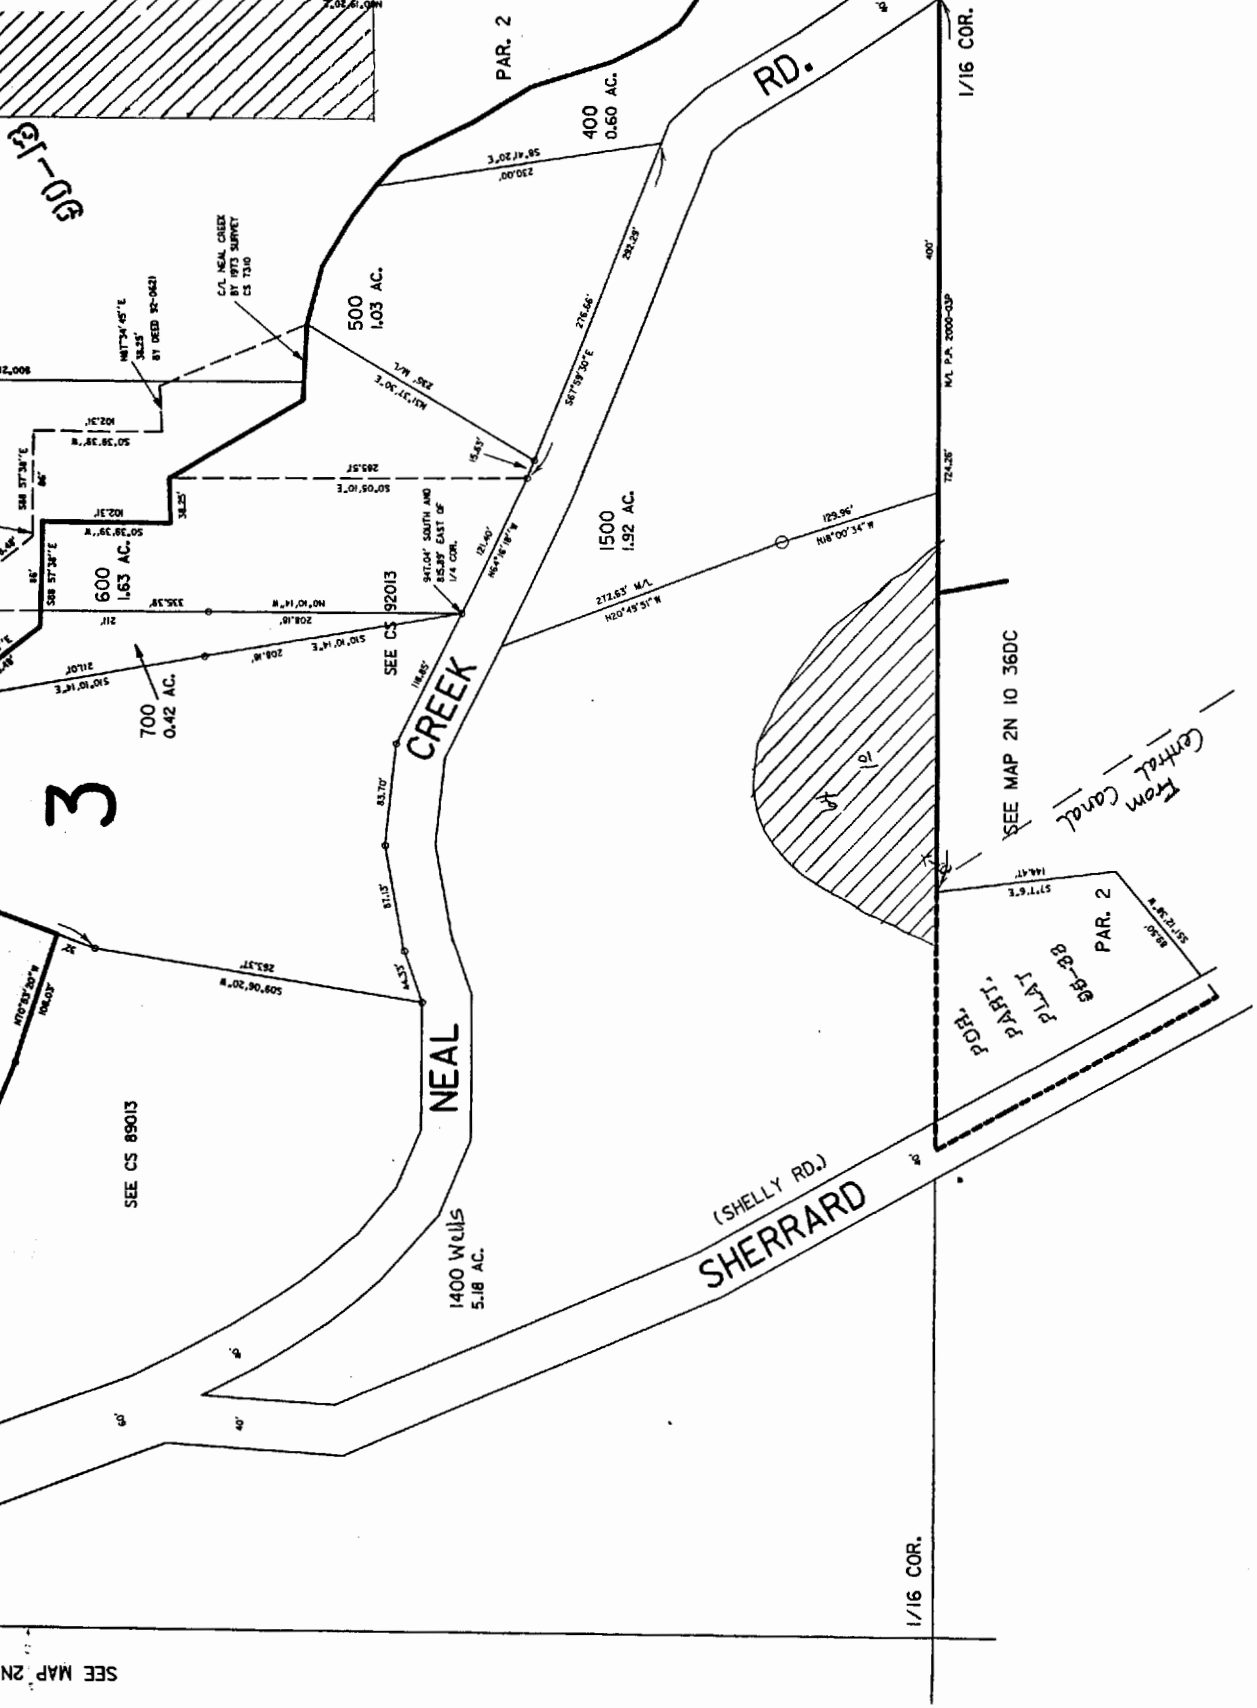

<b>Map Legend</b>
<b>Map Symbols</b>
--- Turnout Box
--- Open Ditch
--- Pipeline
--- Property Line
<b>Water Right Certificate</b>
W-1 P - 26517
W-2 P - 30825
W-3 P - 32101
W-4 P - 32685
<b>East Fork Irrigation District</b> Hood River, Oregon
Section 2N-10-36DB
Scale 1" = 100 cms

2N 10

Revised 9/

SEE MAP 2N

SEE MAP 2N 10 36DC

Central Canal  
From Canal

PLAT PART  
56-38  
PAR. 2

(SHELLY RD.)  
SHERRARD

NEAL CREEK

PAR. 2

3

30-13-03


Application No. 39634  
 Permit No. 29617  
 Certificate No. 80929  
 Map 55 of 72

SECTION 6 T.2N. R.IIE. W.M.  
 HOOD RIVER COUNTY

1" = 400'

THIS MAP WAS PREPARED FOR  
 ASSESSMENT PURPOSE ONLY

WATER RESOURCES DEPT.  
 SALEM, OREGON

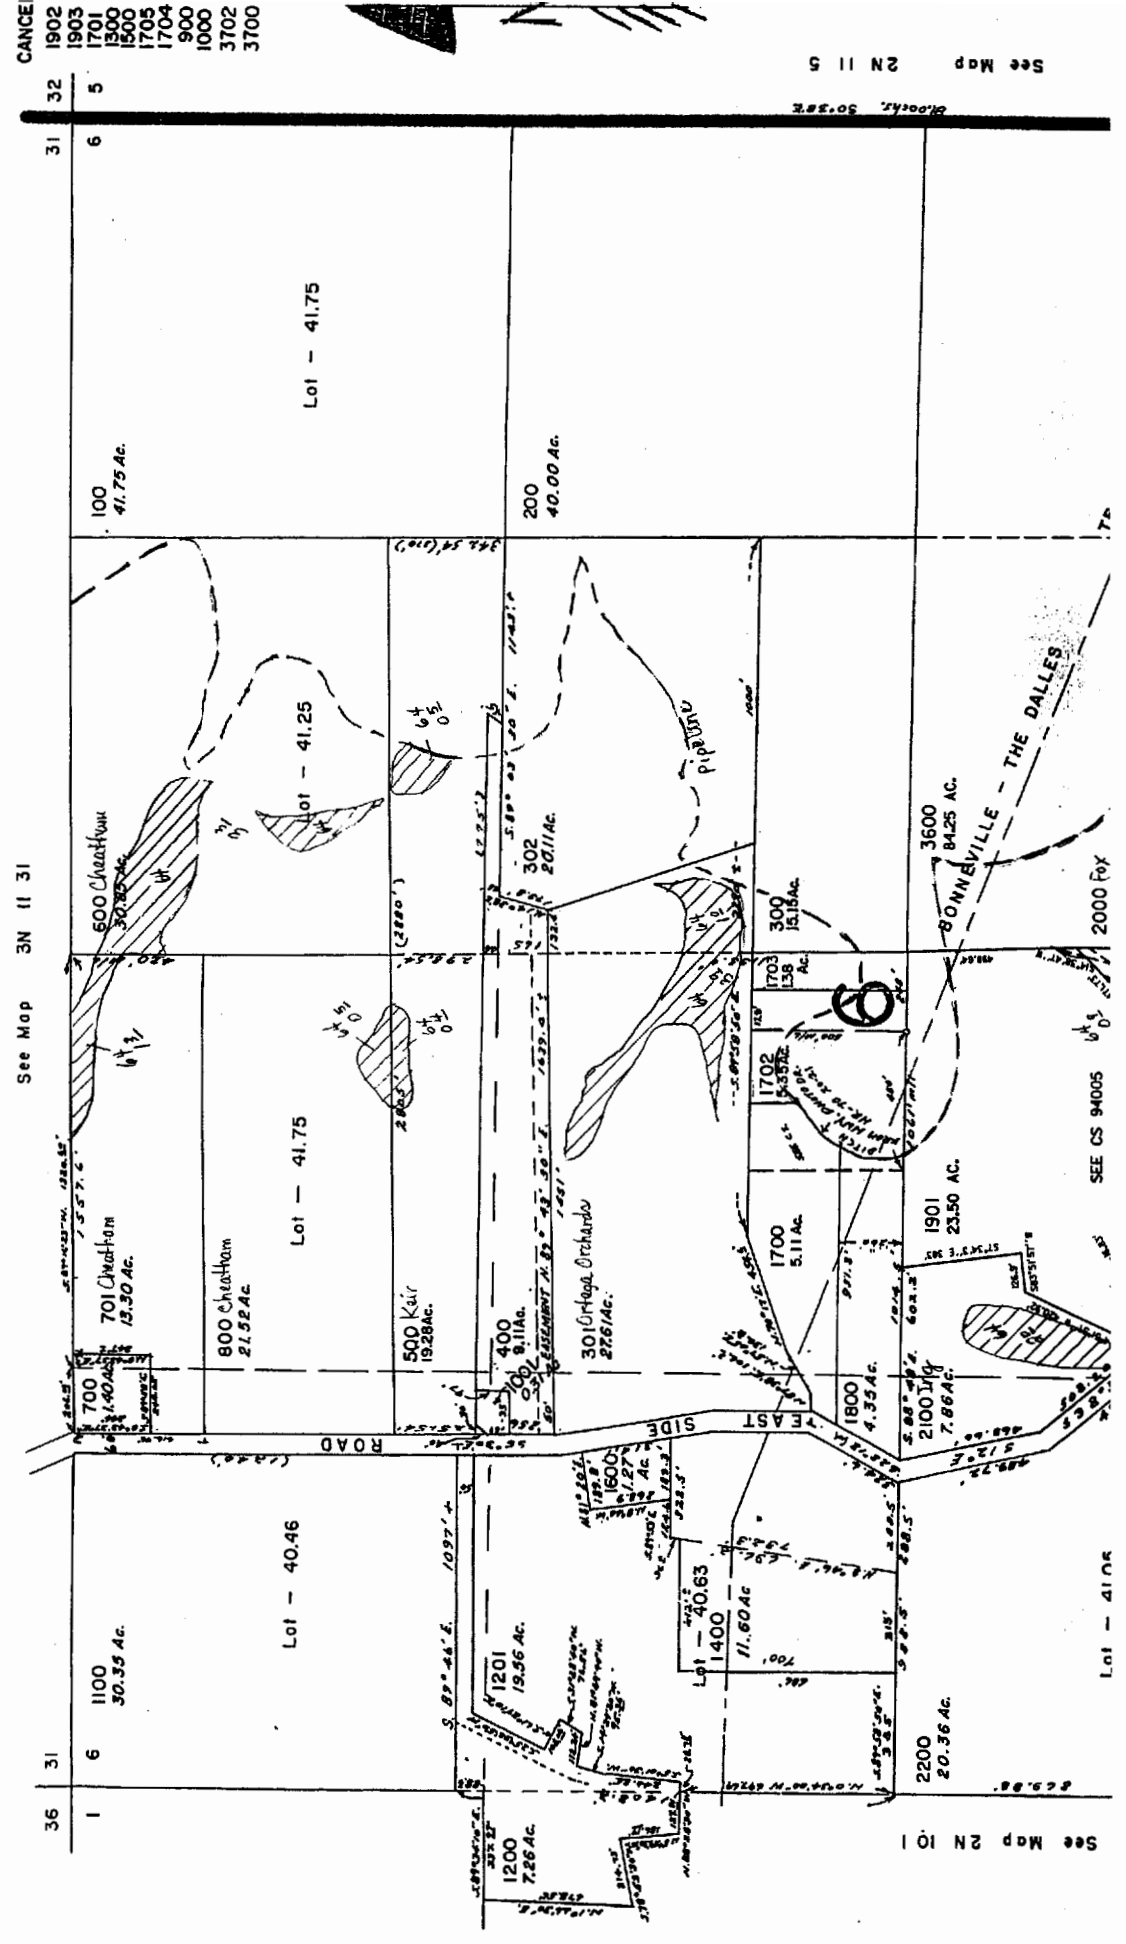

See Map 2N 11 5

See Map 3N 11 31

See Map 2N 10 1

SEE CS 94005

Lot - 4105

74

1902  
1903  
1701  
1500  
1705  
1704  
900  
1000  
3702  
3700

31 32

36 31

700  
140  
701  
13.30 Ac.

1 6 1100  
30.35 Ac.

100  
41.75 Ac.

6 5

Lot - 40.46

Lot - 41.75

Lot - 41.25

Lot - 41.75

500 Kair  
19.28 Ac.

800 Cheatham  
21.52 Ac.


200  
40.00 Ac.

302  
20.11 Ac.

400  
8.11 Ac.

301 Ortega Orchard  
27.61 Ac.

1702  
15.35 Ac.

1703  
13.8 Ac.

300  
15.18 Ac.

1800  
4.35 Ac.

2100  
7.86 Ac.

1901  
23.50 Ac.

3600  
84.25 Ac.

2000 Fox

















Application No. 39634  
 Permit No. 29617  
 Certificate No. 80929  
 Map 56 of 72

RECEIVED  
 JUN 03 2002  
 WATER RESOURCES DEPT.  
 SALEM, OREGON

See Map 2N 11  
 See Map 2N 11

Map Legend	
Map Symbols	Property Line
--- Turnout Box	Water Right Certificate
--- Open Ditch	P - 26517
--- Pipeline	P - 30822
	P - 3210
	P - 3268
	East Fork Irrigation District Hood River, Oregon
	Section 2N-11-06
	Scale 1" = 400' cms

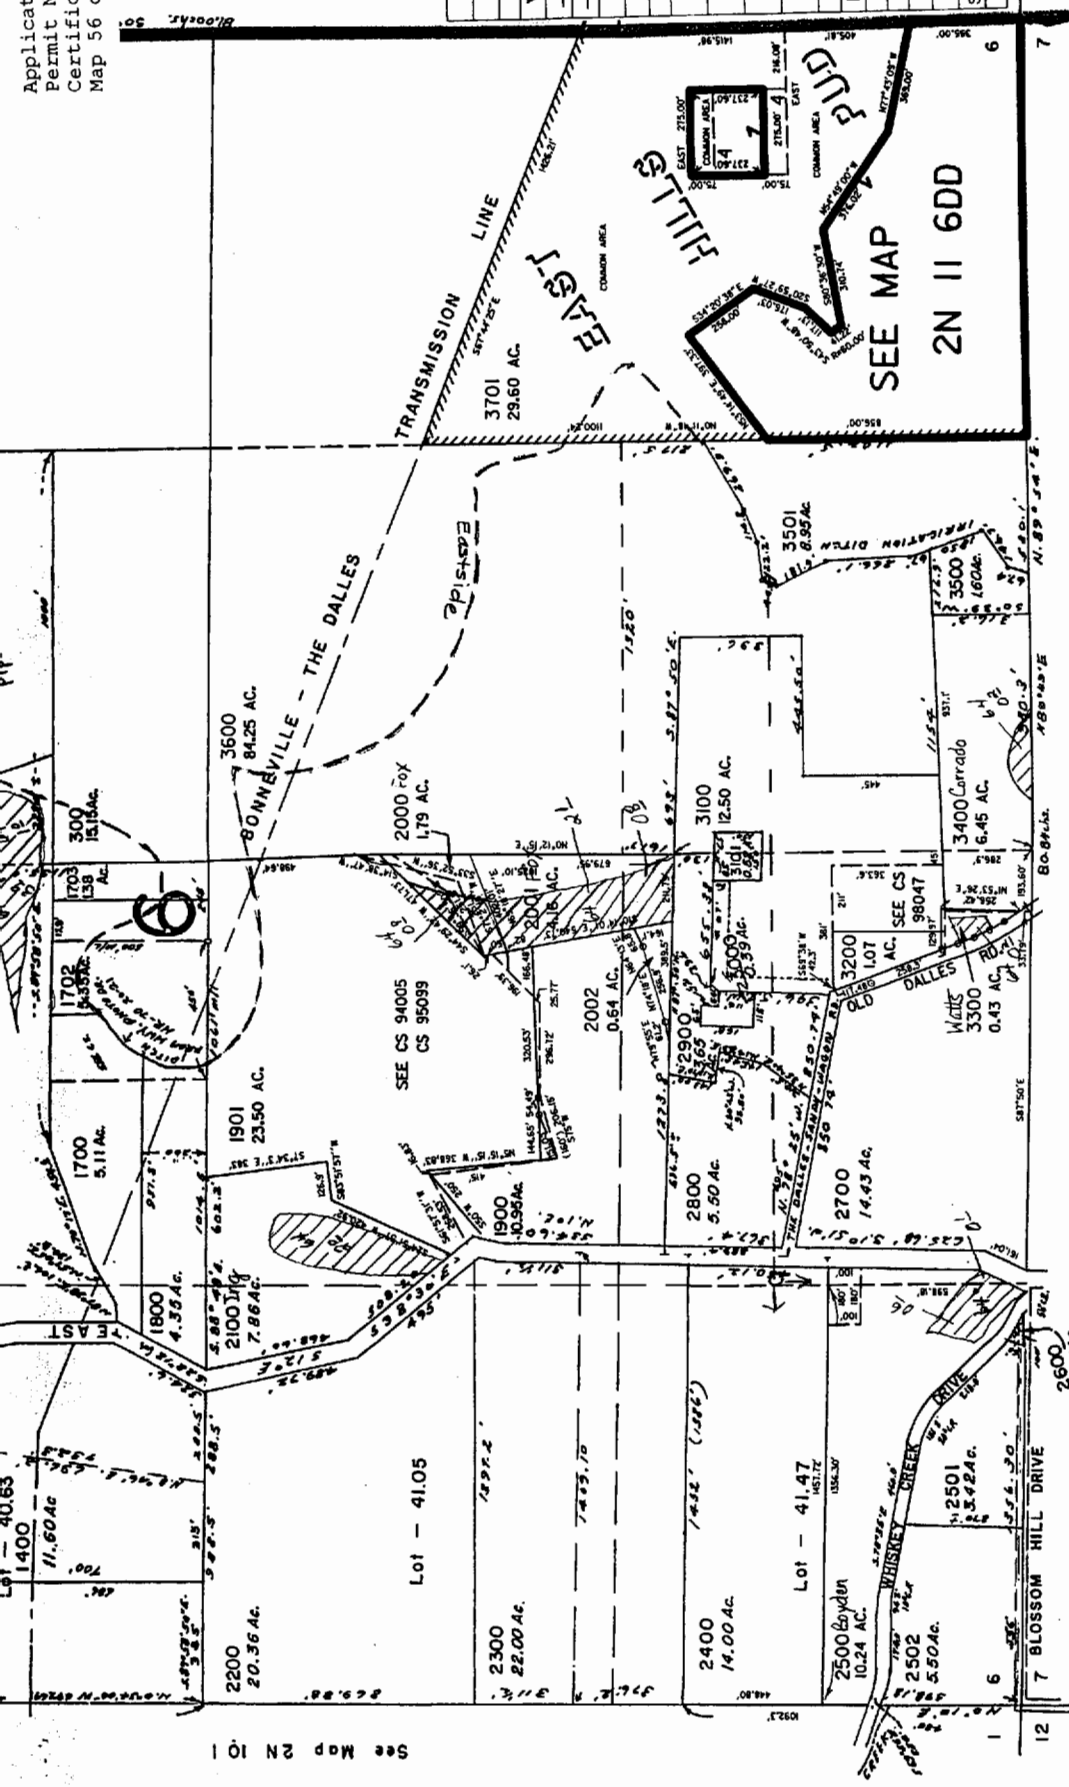

Revised 5/11/99, JD

See Map 2N 11 7

2N 11 6




Application No. 39634  
 Permit No. 29617  
 Certificate No. 80929  
 Map 57 of 72

SPILLER, WILLIAMS

**Section 7 T2N R11E WM**  
**Hood River County**

1" = 400'

THIS MAP WAS PREPARED FOR  
 ASSESSMENT PURPOSE ONLY

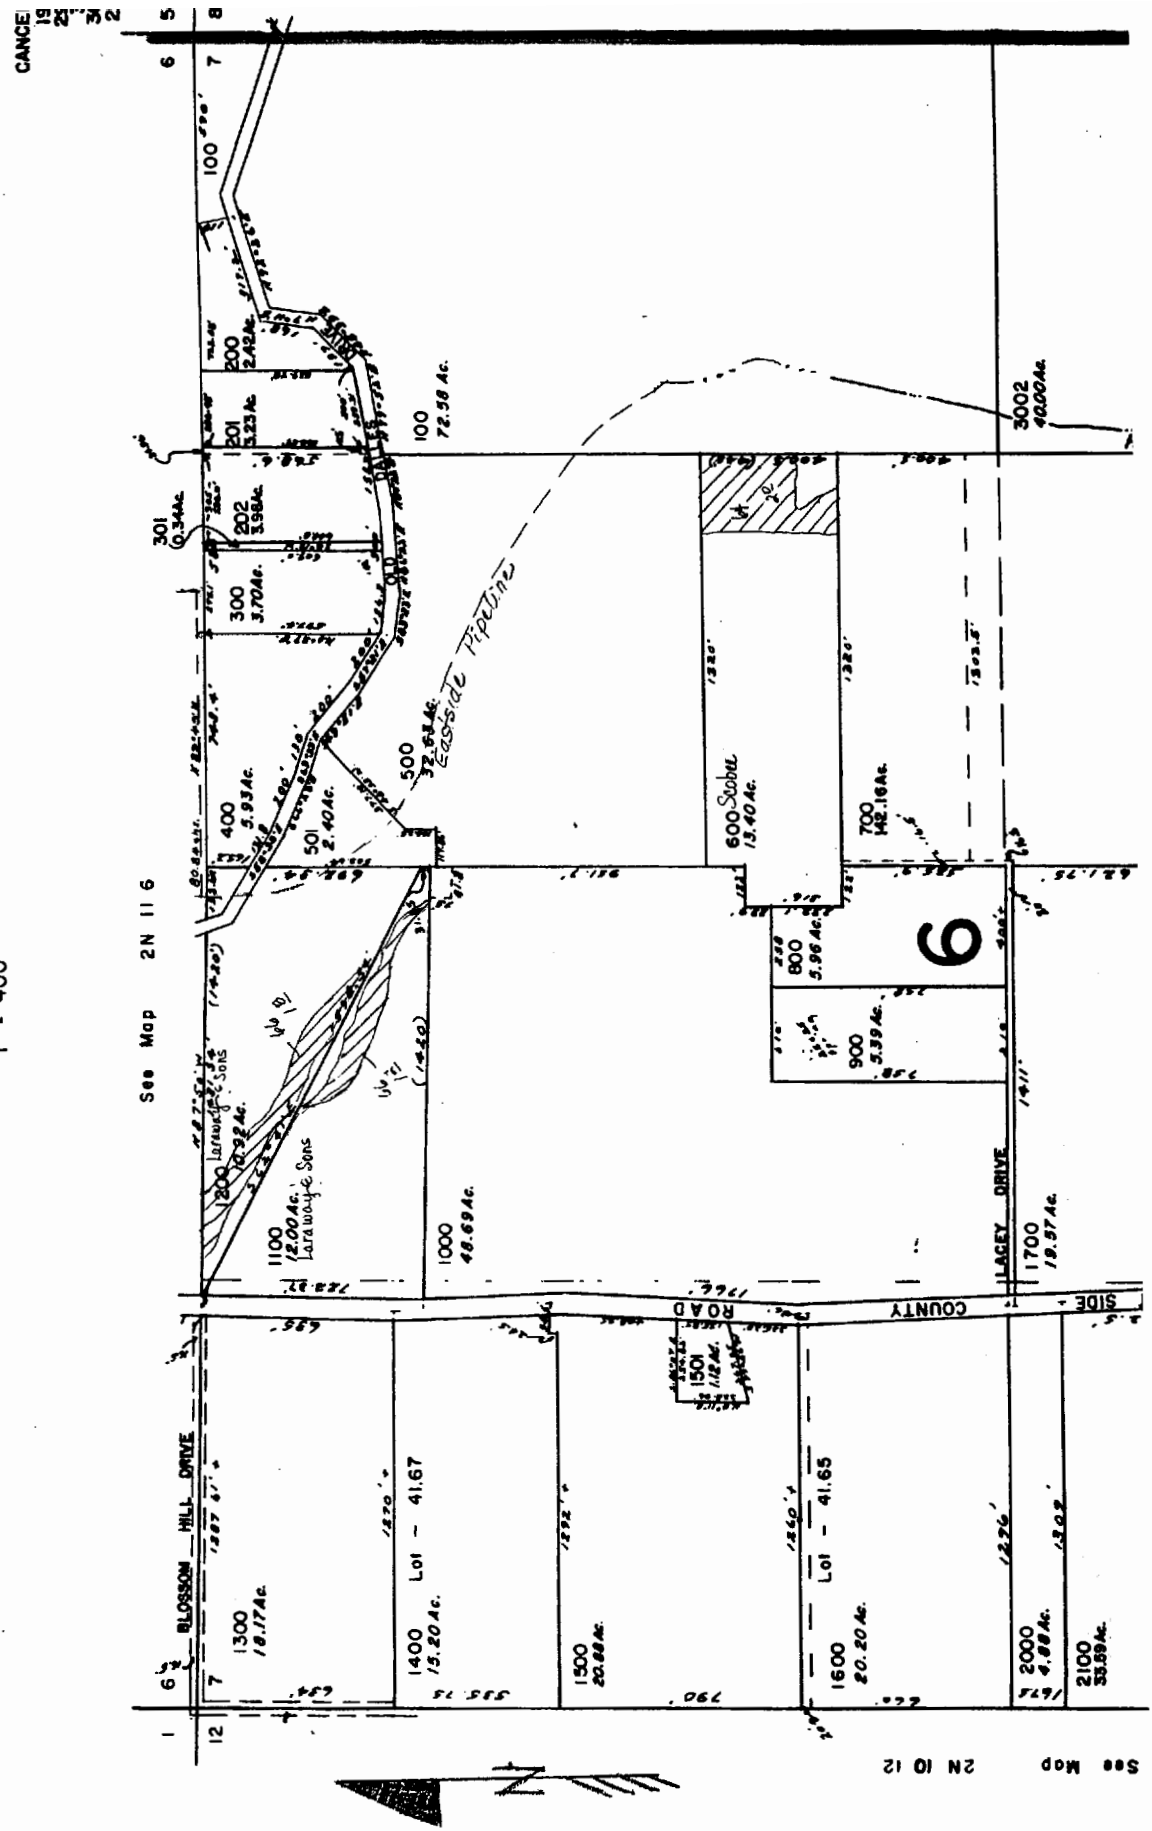

CANCE

19  
21  
22

6  
5

7  
8

100  
200  
Application No. 39634  
 Permit No. 29617  
 Certificate No. 80929  
 Map 58 of 72

WATER RESOURCES DEPT.  
 SALEM, OREGON

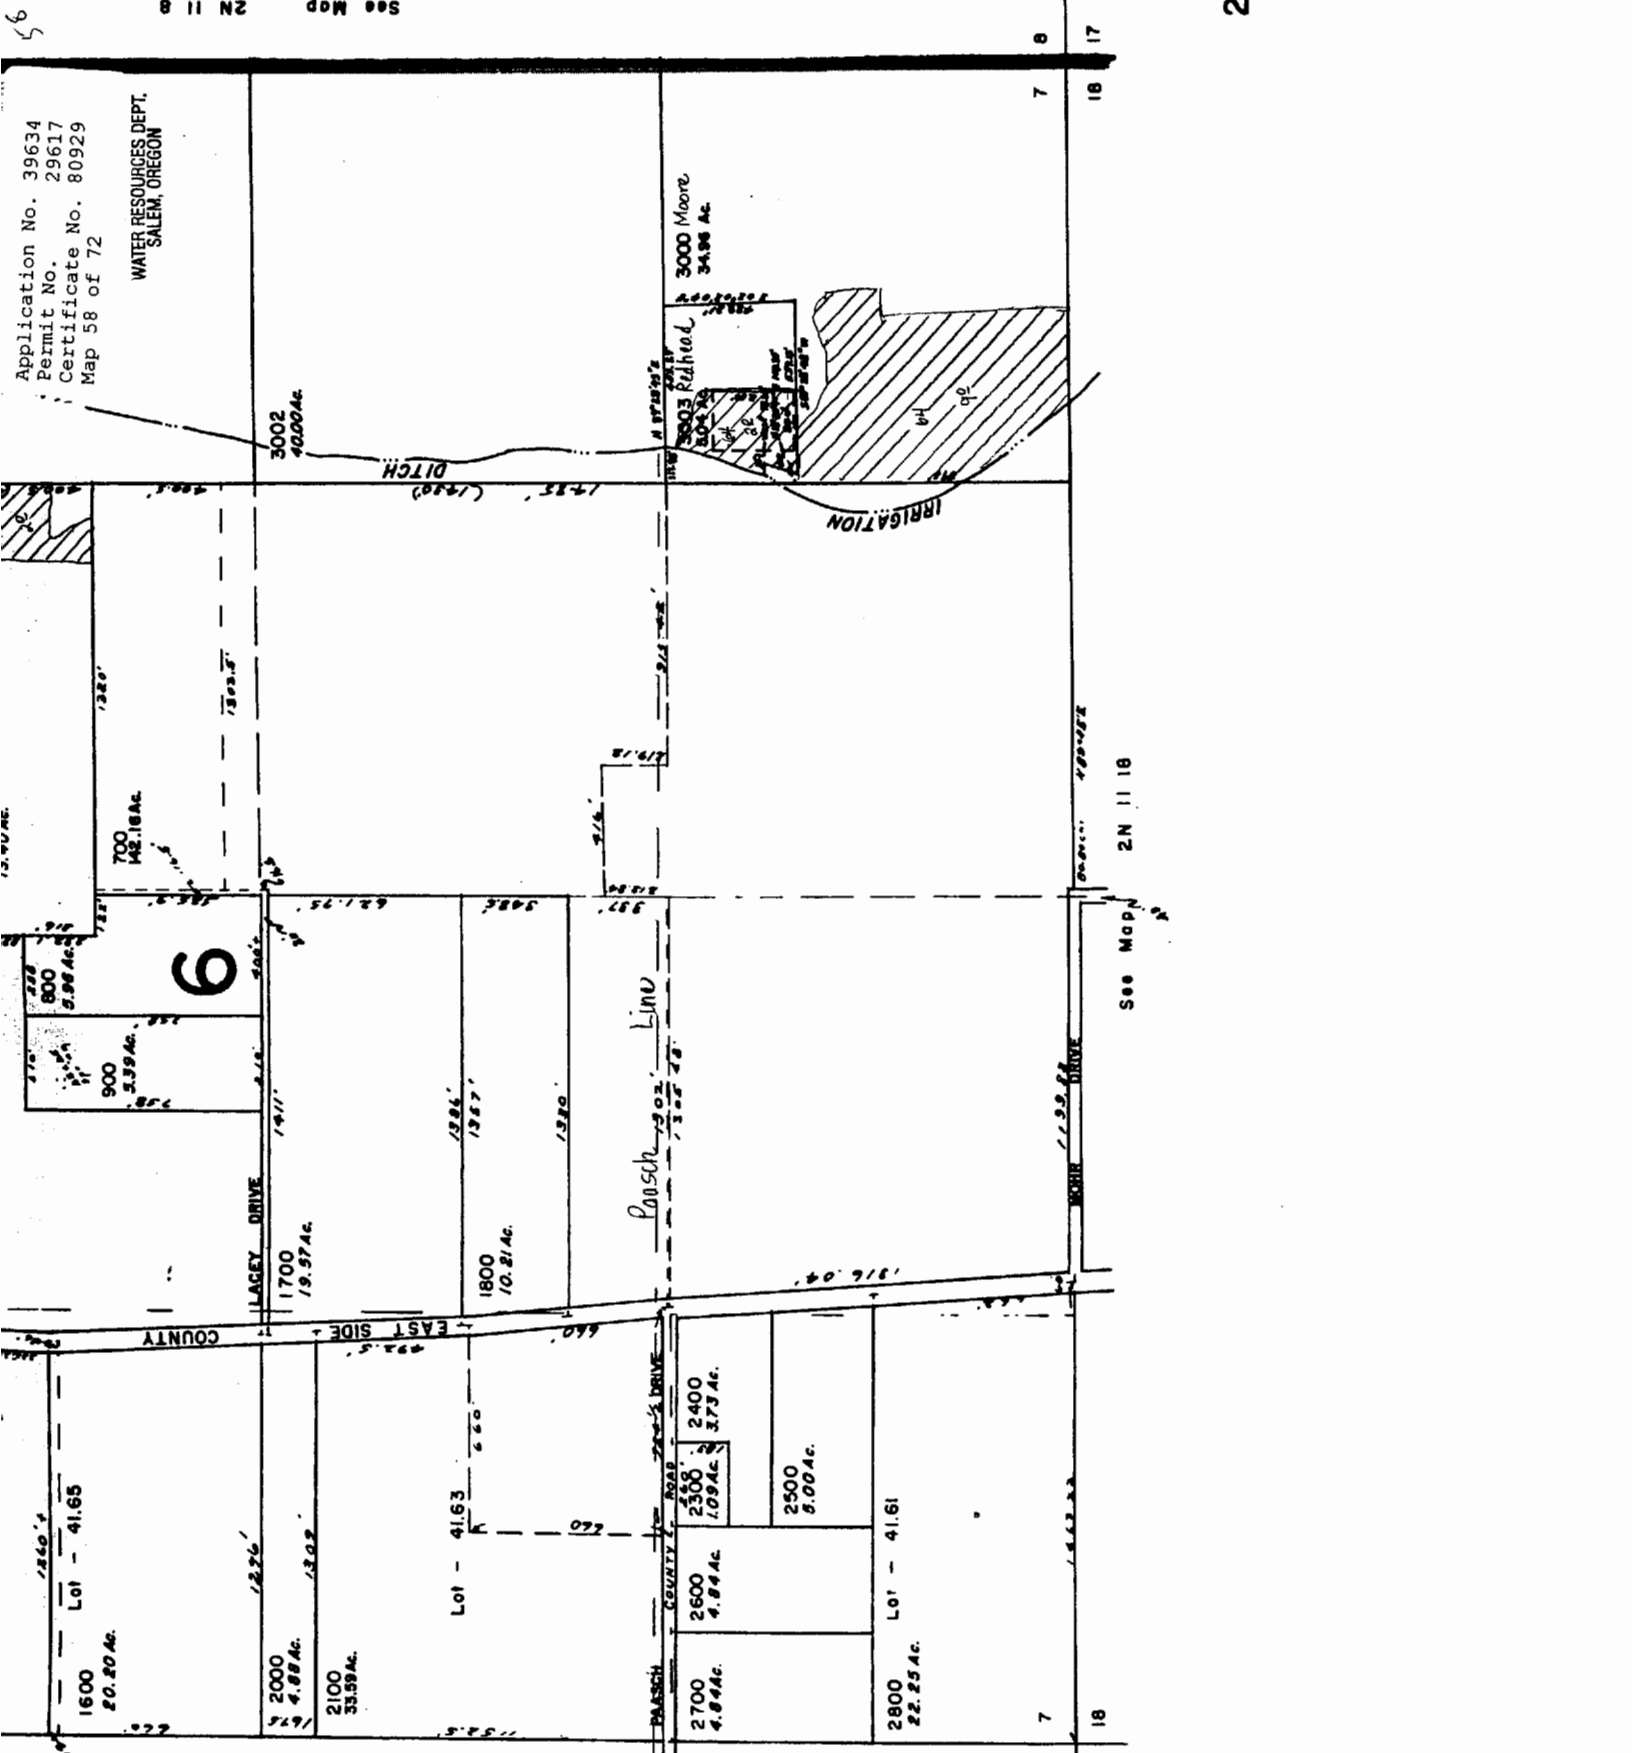

See Map 2N 10 12

Map Legend	
Map Symbols	
←--- Turnout Box	
--- Open Ditch	
--- Pipeline	
--- Property Line	
Water Right Certificate	
64	P - 26517
65	P - 30825
66	P - 32101
67	P - 32685
East Fork Irrigation District Hood River, Oregon	
Section 2N-11-07	
0	350 400
Scale 1" = 400 cms	

See Map 2N 11 18

7 8 17 18

13 18












Application No. 39634  
 Permit No. 29617  
 Certificate No. 80929  
 Map 64 of 72

JUN 03 2012  
 WATER RESOURCE DEPT.  
 SALEM, OREGON

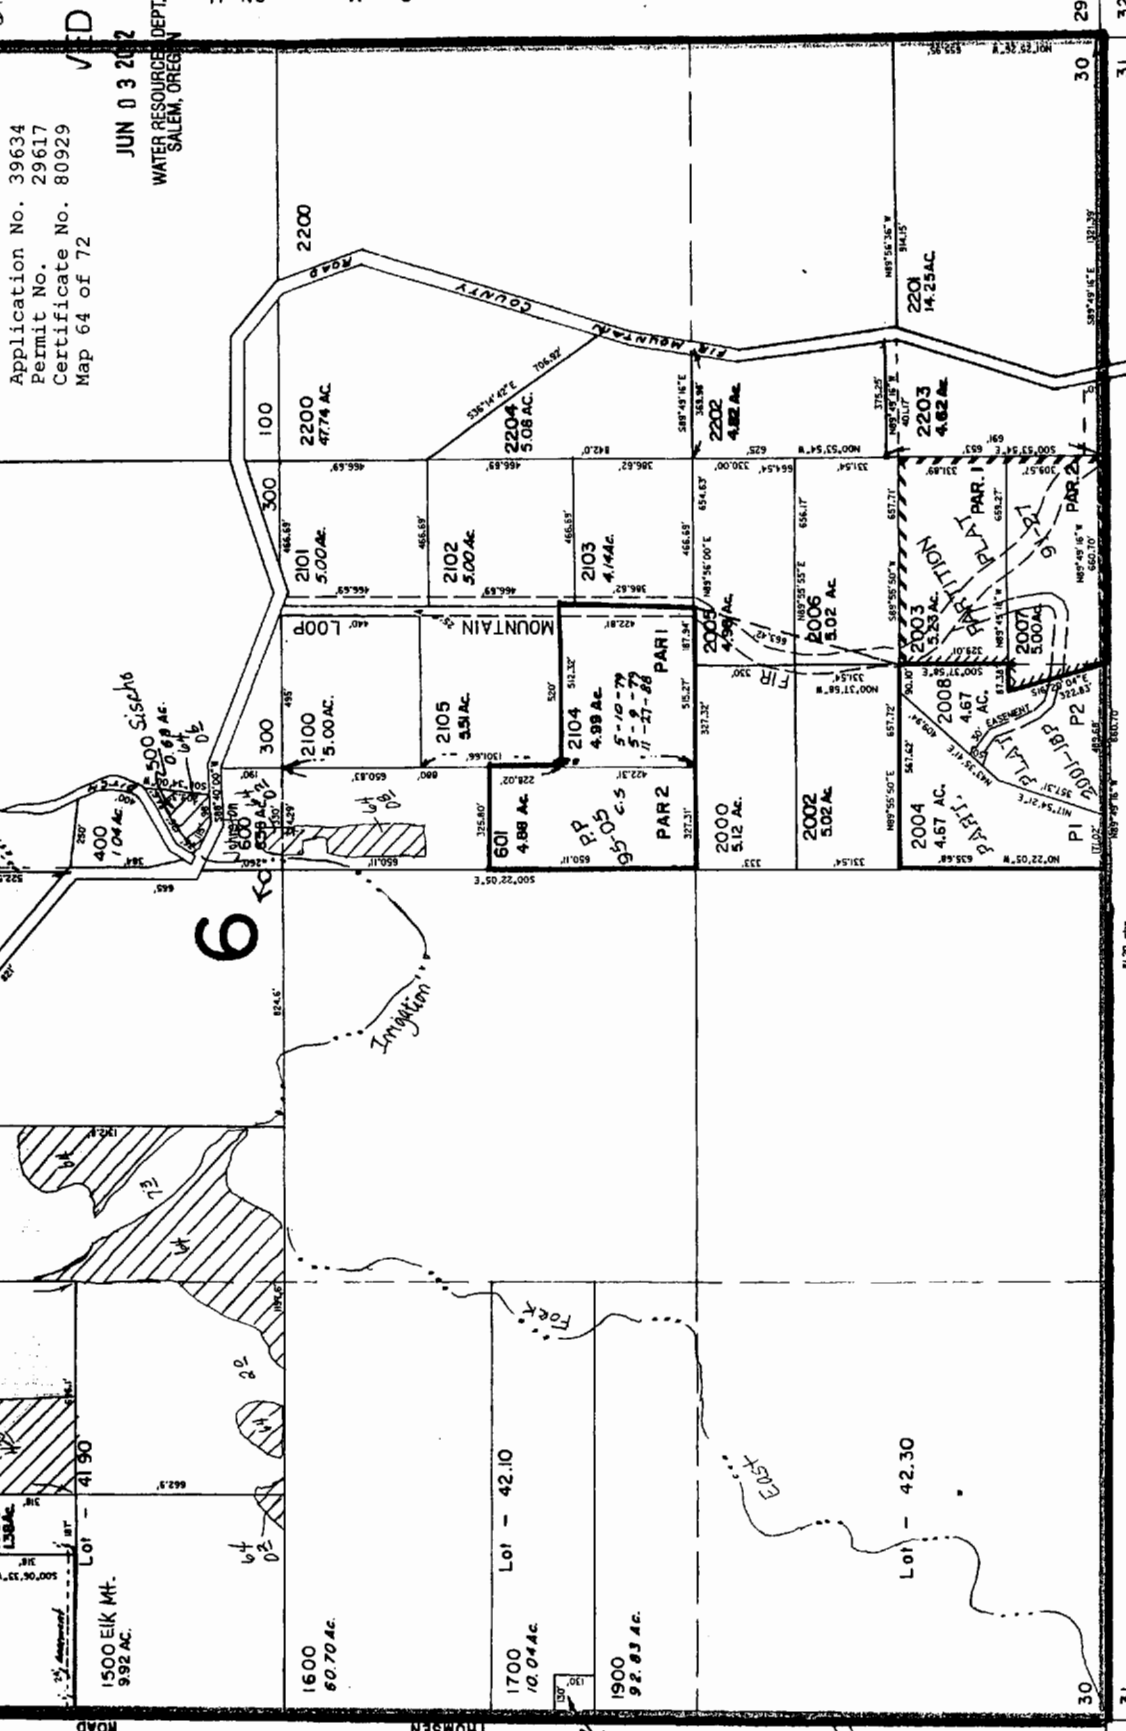

Application No. 39634  
 Permit No. 29617  
 Certificate No. 80929  
 Map 64 of 72

6

1500 EIK MT.  
 9.92 AC.

1600  
 60.70 AC.

1700  
 10.04 AC.

1900  
 92.83 AC.

2000  
 5.12 AC.

2002  
 5.02 AC.

2004  
 4.67 AC.

2006  
 5.02 AC.

2003  
 5.29 AC.

2001  
 14.25 AC.

2100  
 5.00 AC.

2102  
 5.00 AC.

2103  
 4.14 AC.

2104  
 4.88 AC.

2105  
 5.51 AC.

2200  
 47.74 AC.

2202  
 4.82 AC.

2203  
 4.62 AC.

2204  
 5.08 AC.

Application No. 39634  
 Permit No. 29617  
 Certificate No. 80929  
 Map 65 of 72

**NE 1/4 Sec. 36 T.3N. R.10E. W.M.**  
**HOOD RIVER COUNTY**

1"=200'

THIS MAP WAS PREPARED FOR  
 ASSESSMENT PURPOSE ONLY

Cancel


See Map 3N 10 25DD

See Map 3N 10 25DC

1/4 Cor

See Map 3N 10 36AB

See Map 3N 10 36BA

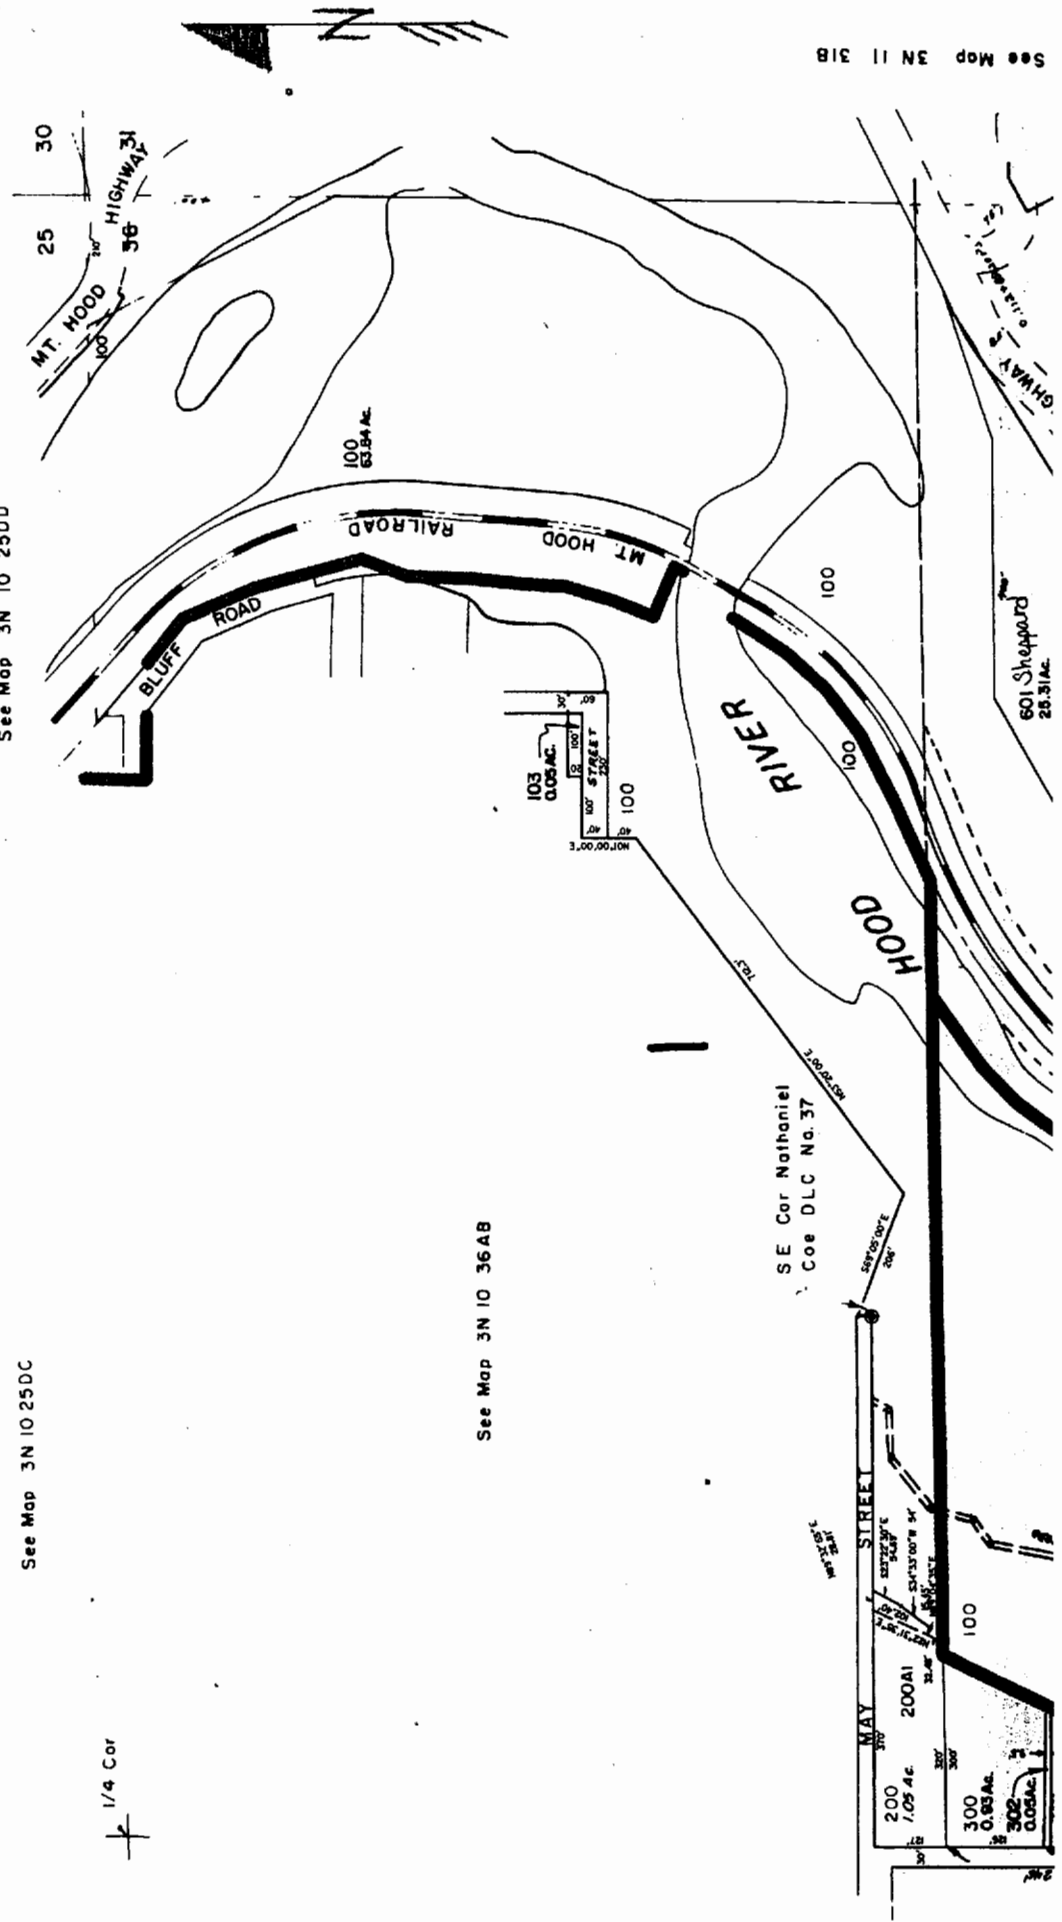


See Map 3N 11 31B

Application No. 39634  
 Permit No. 29617  
 Certificate No. 80929  
 Map 66 of 72

See Map 3N 11 31B

SE Cor Nathaniel  
 Coe DLC No. 37

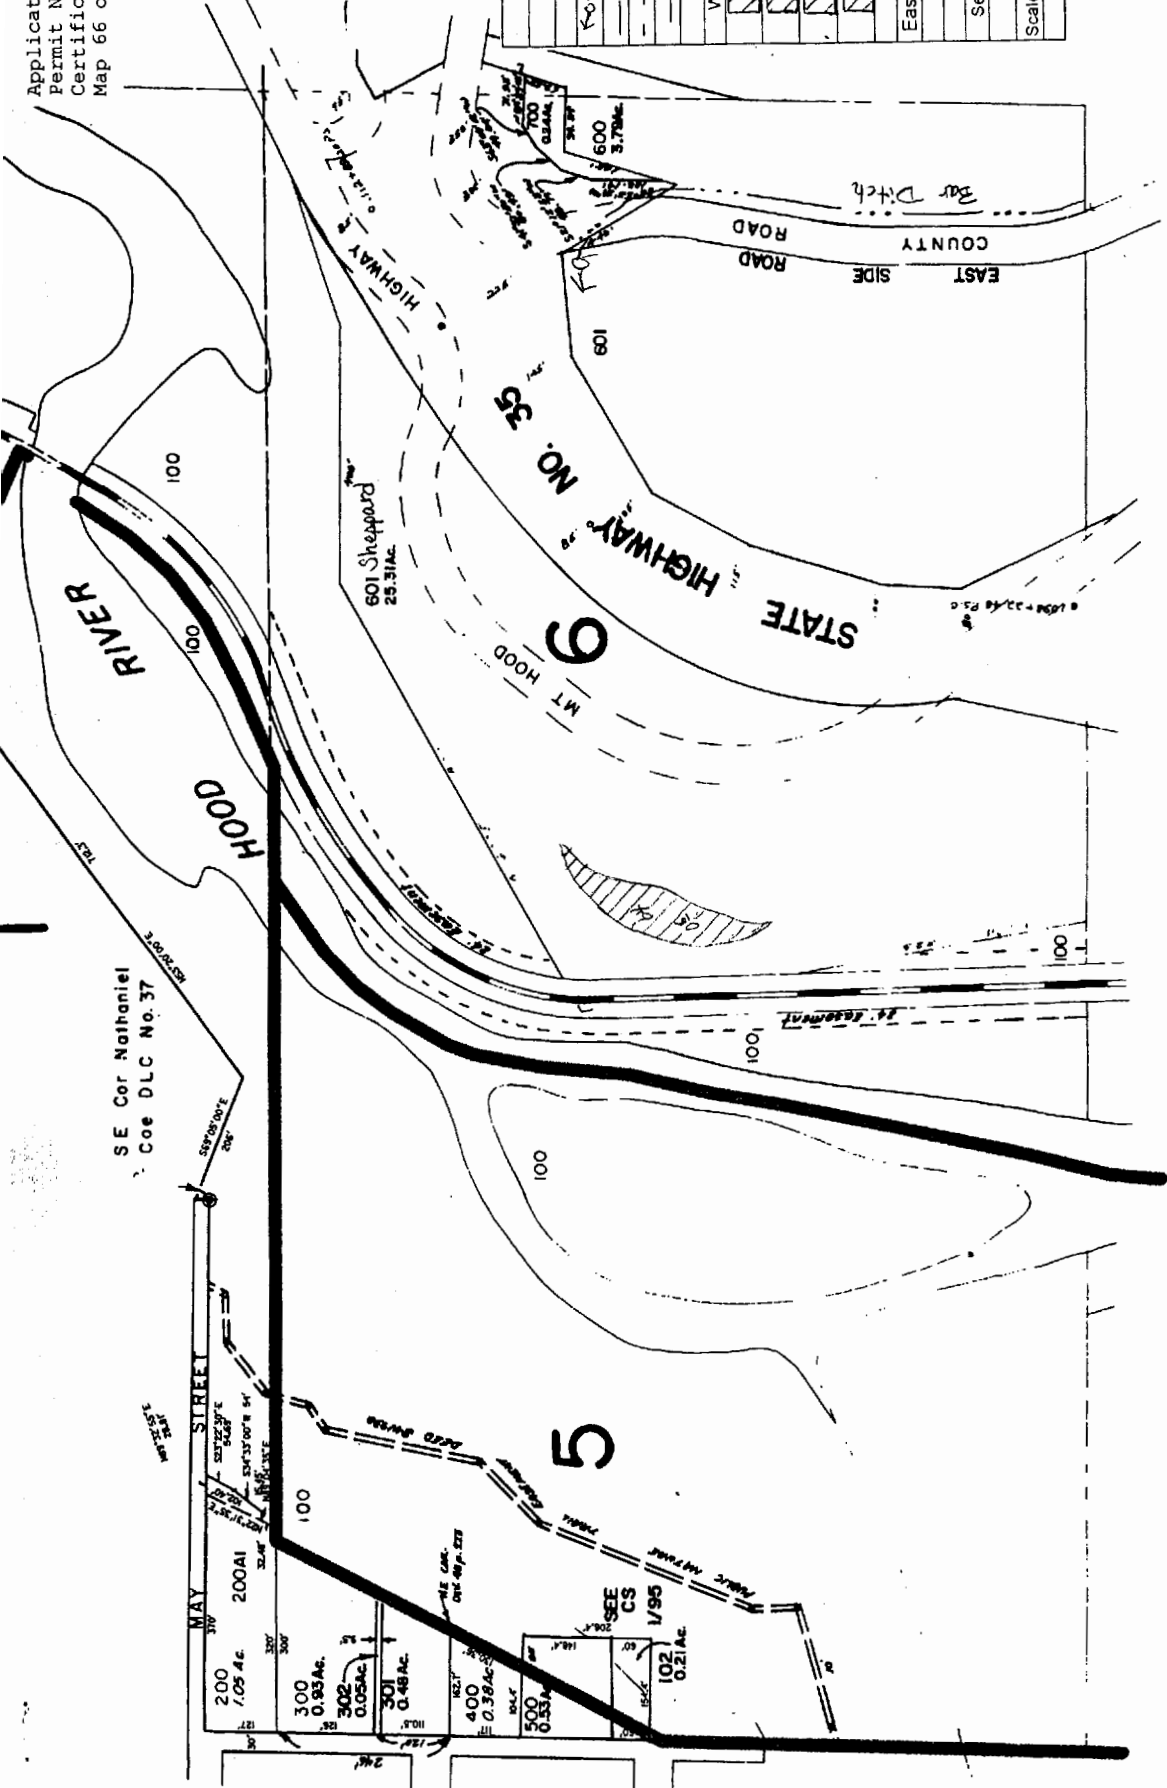


Map Legend	
Map Symbols	
	Turnout Box
	Open Ditch
	Pipeline
	Property Line
Water Right Certificate	
	P - 26517
	P - 30825
	P - 32101
	P - 32685
East Fork Irrigation District Hood River, Oregon	
Section 3N-10-36A	
Scale 1" = 2,000' cms	

3N 10 36A  
 HOOD RIVER

See Map 3N 10 36D

Application No. 39634  
 Permit No. 29617  
 Certificate No. 80929  
 Map 67 of 72  
 JUNE 13 1972  
 WATER RESOURCES DEPT.  
 SALEM, OREGON


CANCELLED  
 1000 thru 22  
 201

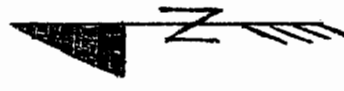

SECTION 31 T.3N. R.IE. W.M.  
 HOOD RIVER COUNTY

1" = 400'

THIS MAP WAS PREPARED FOR  
 ASSESSMENT PURPOSE ONLY

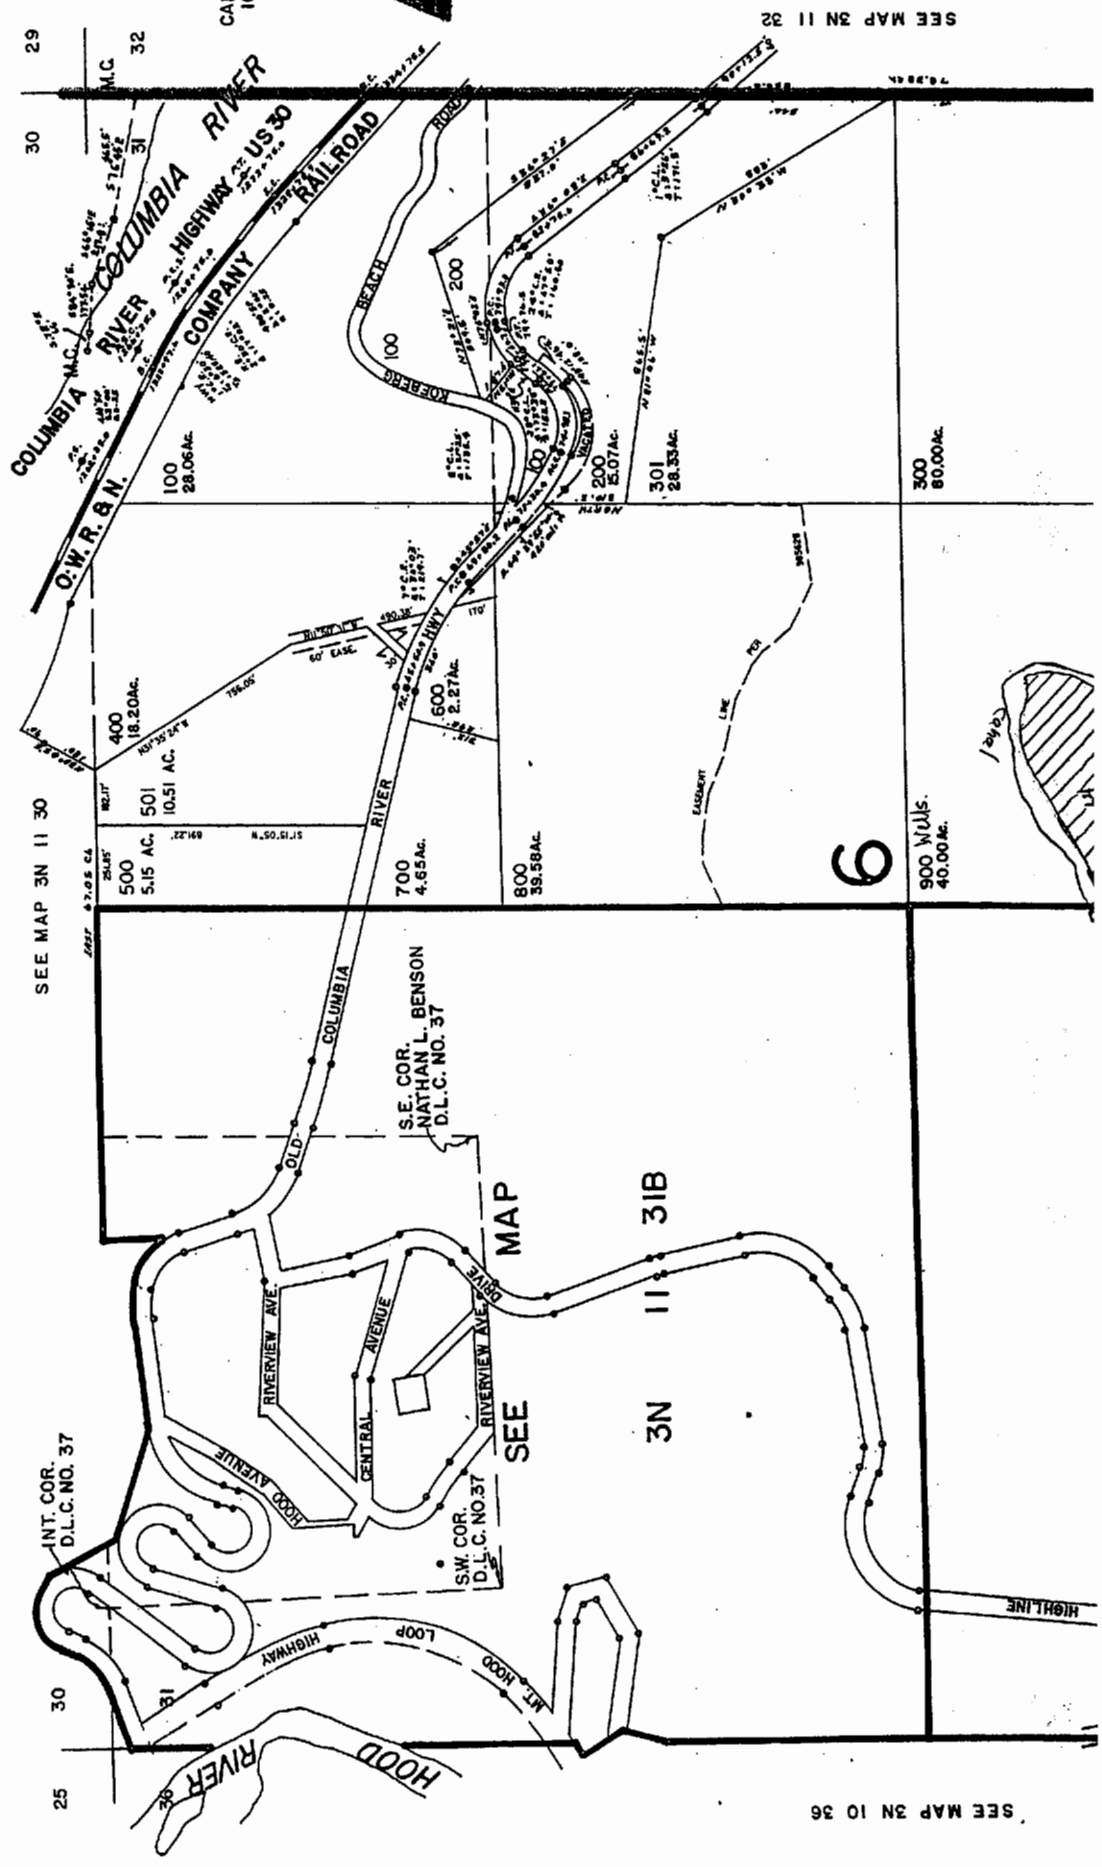

SEE MAP 3N 10 36

SEE MAP 3N 11 30

SEE MAP 3N 11 32

MAP 3N 11 31B

INT. COR. D.L.C. NO. 37

S.W. COR. D.L.C. NO. 37

S.E. COR. NATHAN L. BENSON D.L.C. NO. 37

Application No. 39634  
 Permit No. 29617  
 Certificate No. 80929  
 Map 68 of 72

**RECEIVED**  
 JUN n 3 2002  
 WATER RESOURCES DEPT.  
 SALEM, OREGON

SEE MAP 3N

6

900 WILLS.  
40.00 Ac.

300  
80.00 Ac.

2300  
40.00 Ac.

SEE MAP  
 3N 11 31C  
 PRIVATE

HIGHLINE

OLD

Line

Creek

Whiskey

ROAD

ROAD

31

6

31

6

5

SEE MAP 2N 11 6

3N 11 31  
 & INDEX

36

1

REVISED 3-2-99, JD

Map Legend	
Map Symbols	
	Turnout Box
	Open Ditch
	Pipeline
	Property Line
Water Right Certificate	
	P - 26517
	P - 30825
	P - 32101
	P - 32685
East Fork Irrigation District Hood River, Oregon	
Section 3N-11-31	
	400
	100
Scale 1" = 400 cms	

SEE MAP 3N 10 36

Application No. 39634  
Permit No. 29617  
Certificate No. 80929  
Map 69 of 72

NW1/4 SEC. 31 T.3N. R.11E. WM.  
HOOD RIVER COUNTY


RECEIVED  
JUN 03 2002

WATER RESOURCES DEPT.  
SALEM, OREGON

1" = 200'

SEE MAP 3N 11 30

THIS MAP WAS PREPARED FOR  
ASSESSMENT PURPOSE ONLY

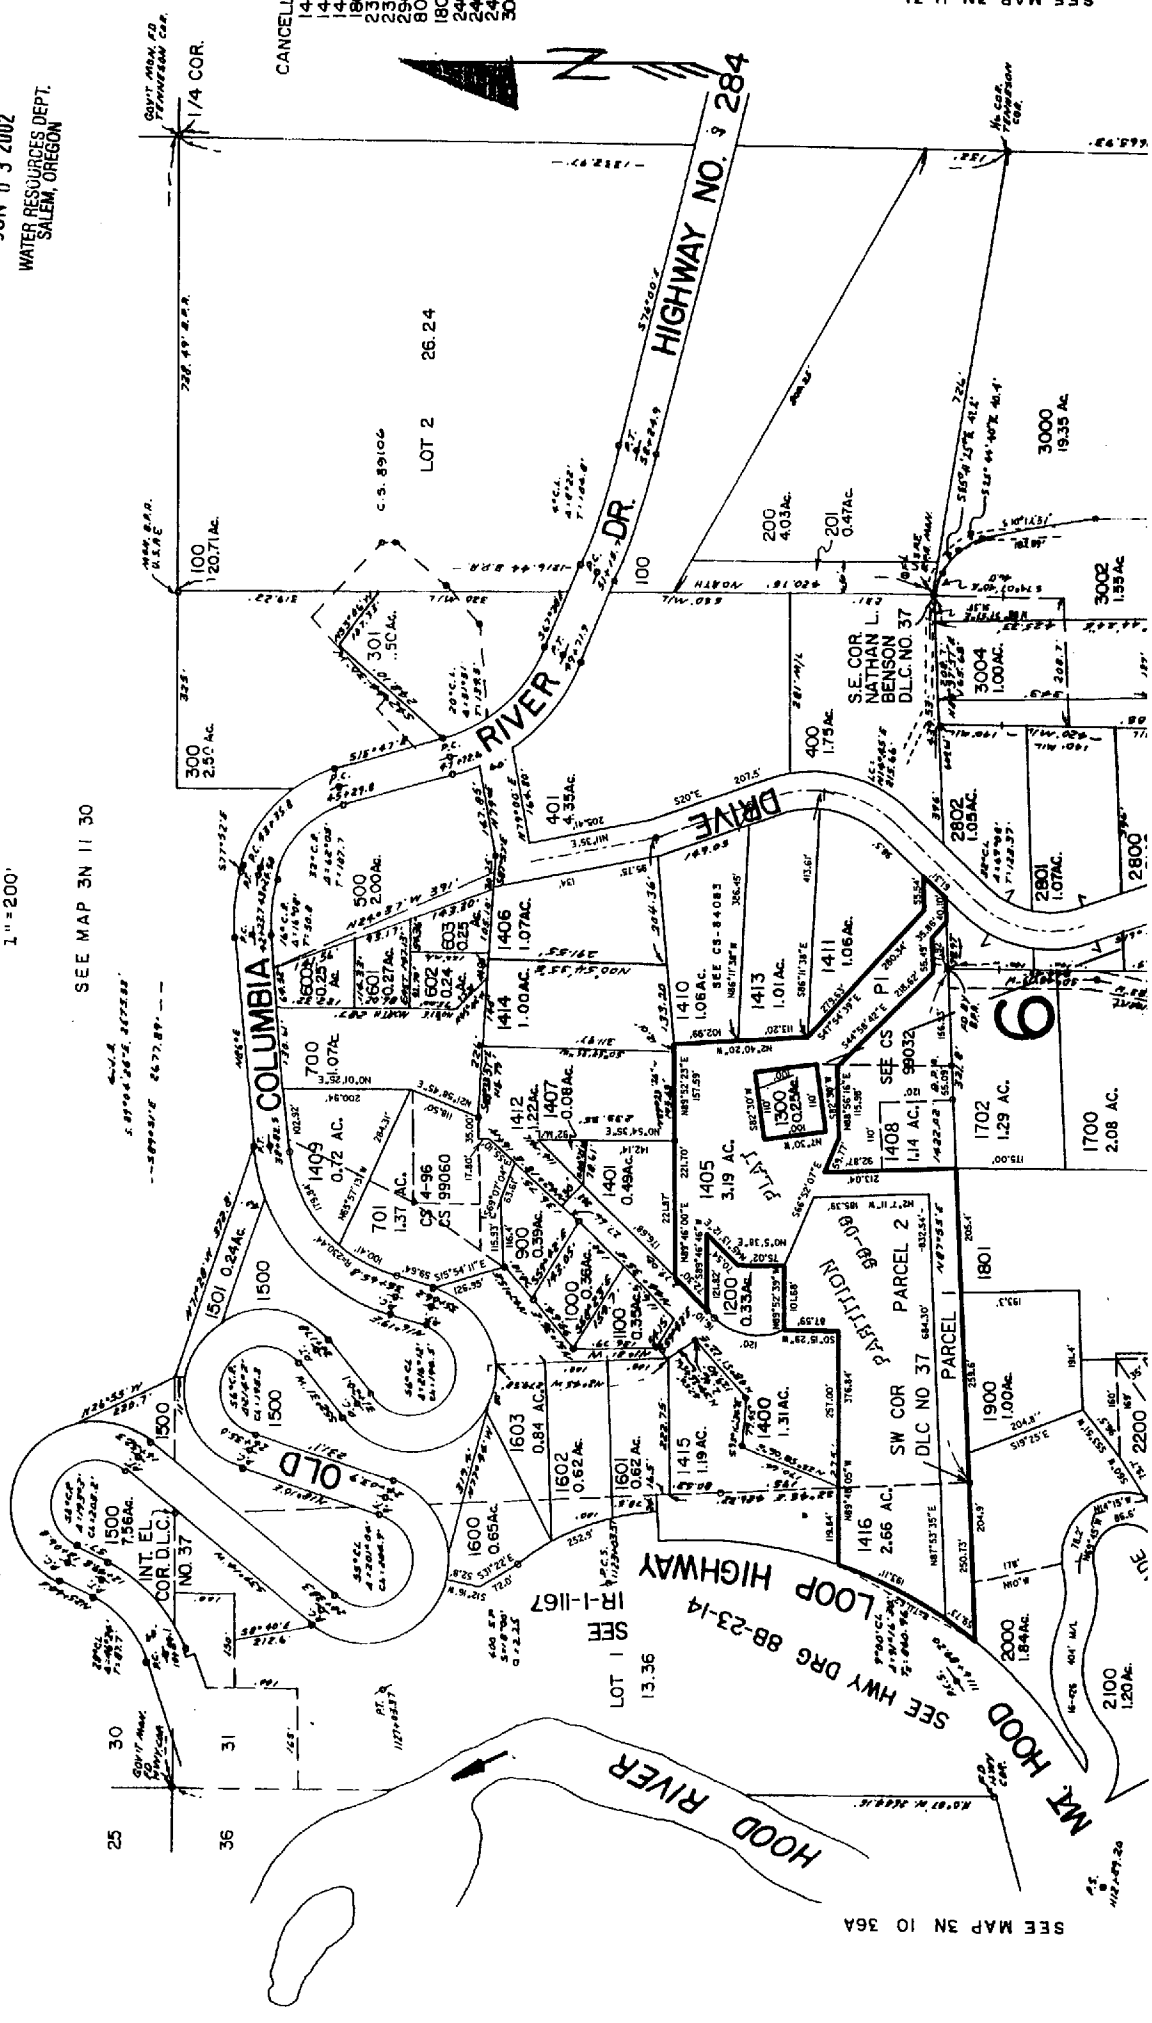

SEE MAP 3N 10 36A


Application No. 39634  
 Permit No. 29617  
 Certificate No. 80929  
 Map 70 of 72

SALEM, OREGON

SEE MAP 3N 11 31B

Map Legend	
Map Symbols	
Turnout Box	⊙
Open Ditch	—
Pipeline	—
Property Line	—
Water Right Certificate	
64	P - 26517
65	P - 30825
66	P - 32101
67	P - 32685
East Fork Irrigation District Hood River, Oregon	
Section 3N-11-31B	
Scale 1" = 200' cms	

Revise  
 8/2/01, J  
 3N 11 31B

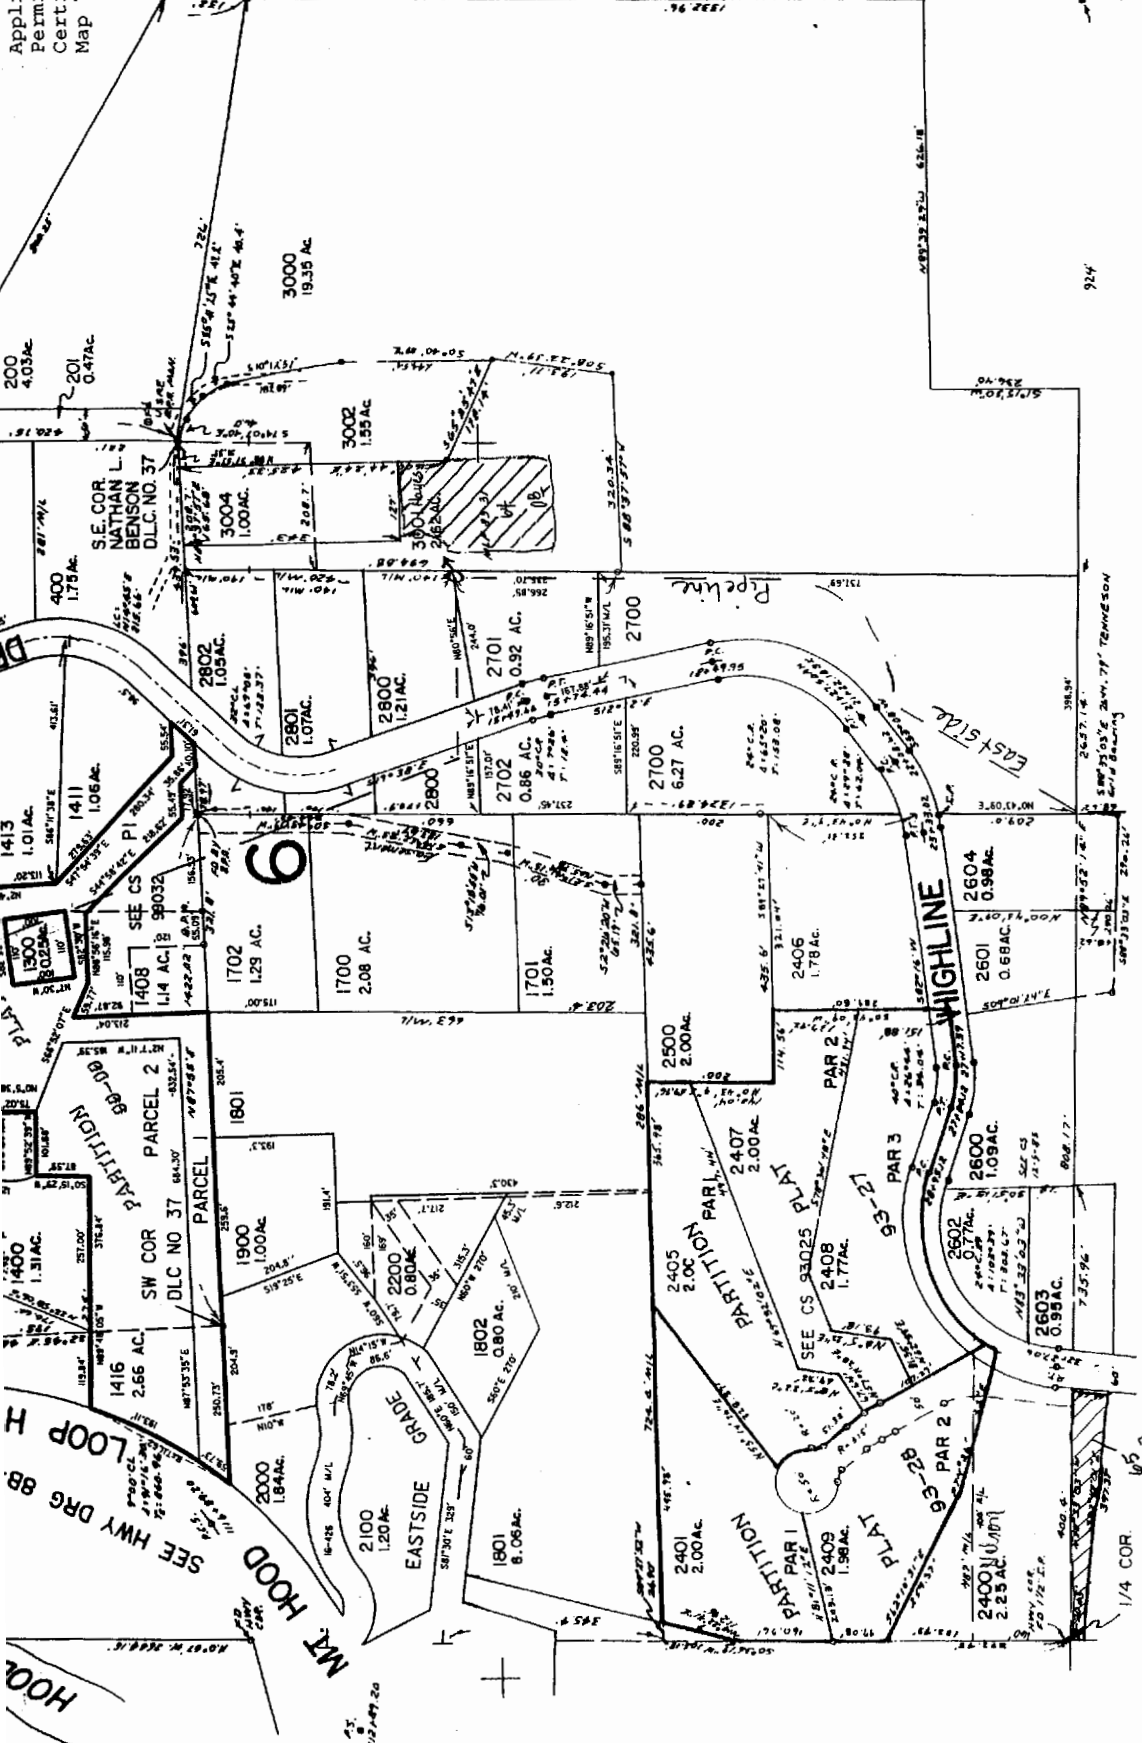

924  
 CEN. SEC.

SEE MAP 3N 11 31C

SEE MAP 3N 10 36A




Application No. 39634  
 Permit No. 29617  
 Certificate No. 80929  
 Map 72 of 72

RECEIVED  
 JUN 11 3 2002  
 WATER RESOURCES DEPT  
 SALEM, OREGON

SEE MAP 3N

MP 15.50-2 2607.96 72NWA  
 GRID

Map Legend	
Map Symbols	
	Turnout Box
	Open Ditch
	Pipeline
	Property Line
Water Right Certificate	
	P - 26517
	P - 30825
	P - 32101
	P - 32685
East Fork Irrigation District Hood River, Oregon	
Section 3N-11-31G	
Scale 1" = 200 cms	

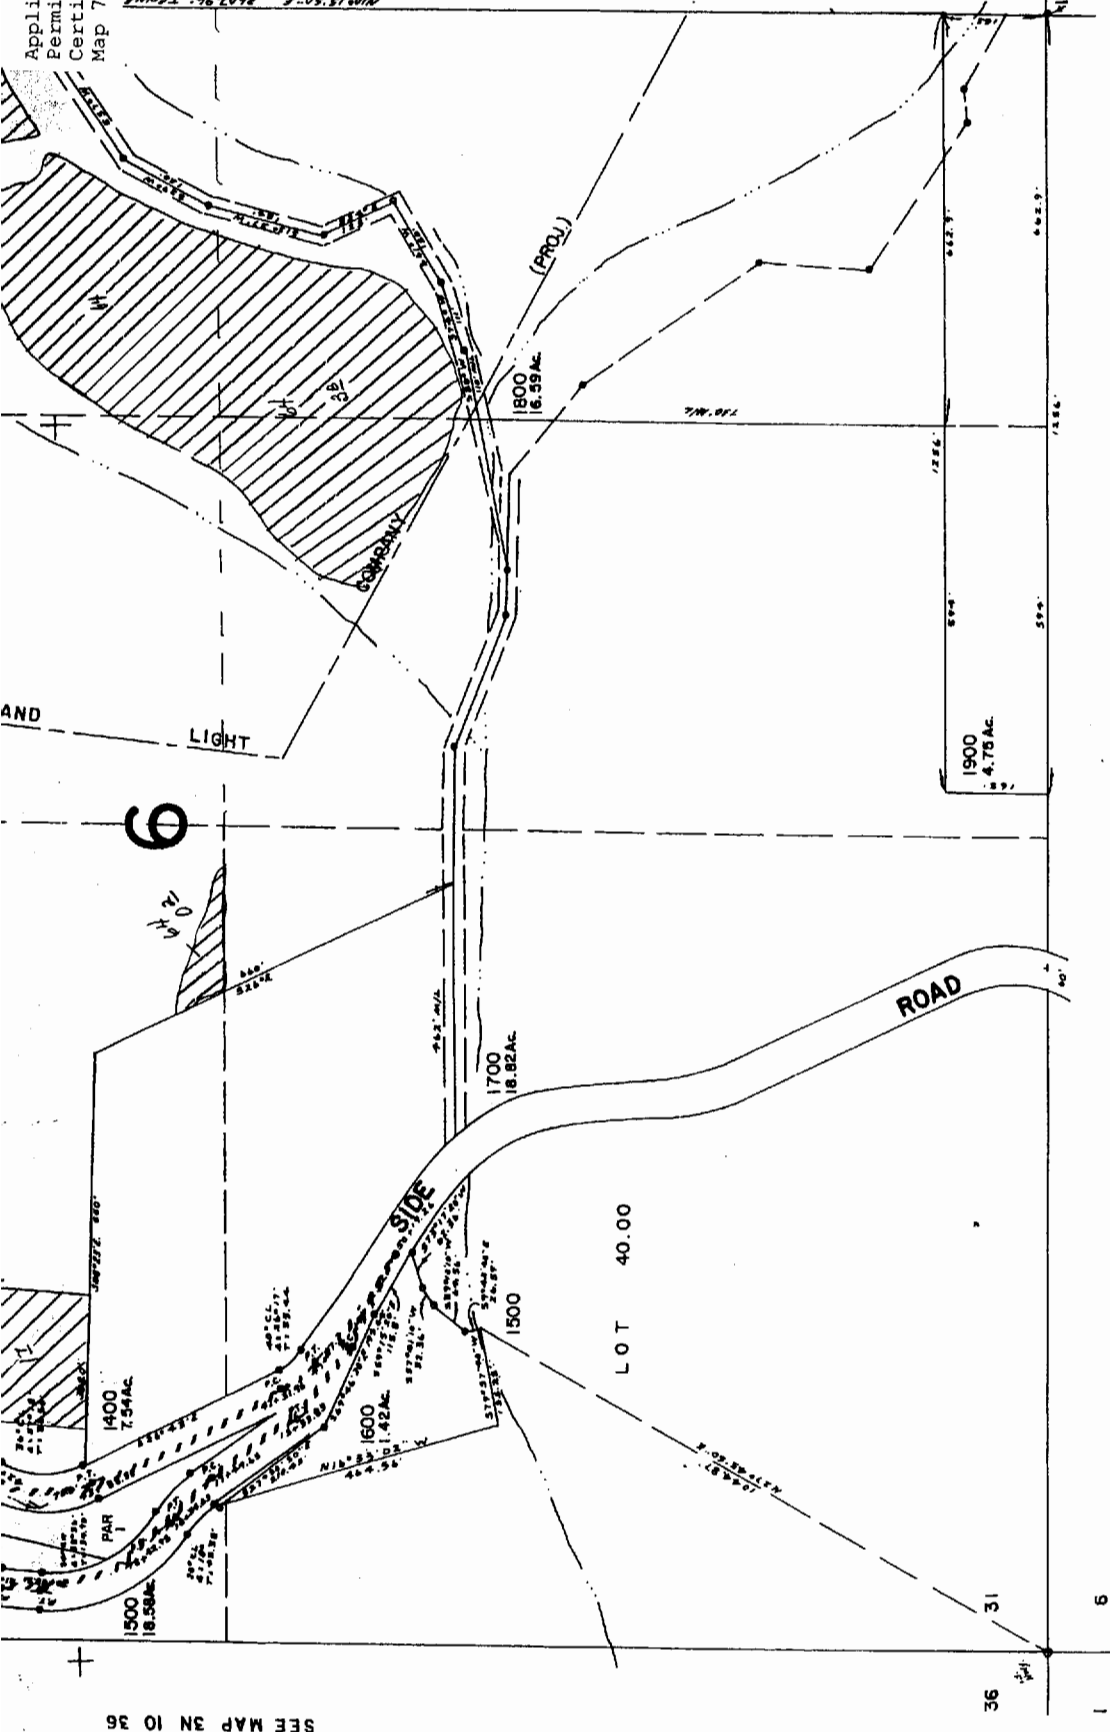

SEE MAP 3N 10 36

SEE MAP 2N 11 6

3N 11 31G

Revised 12/14/99, JD