


T3NRIOW.W.M.

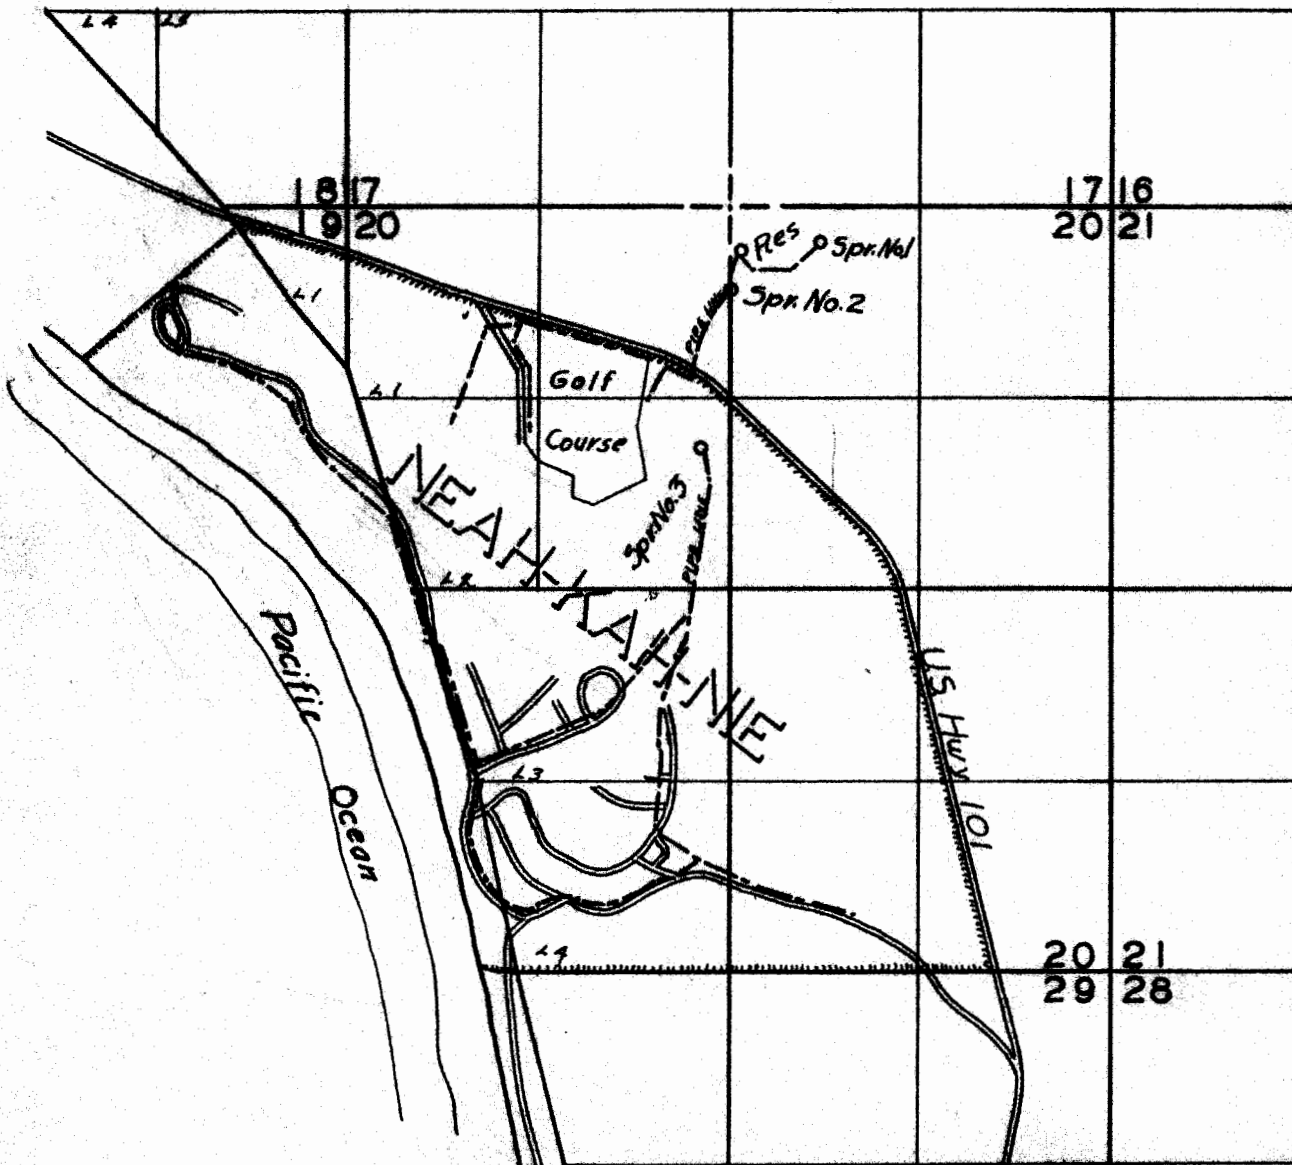

FINAL PROOF SURVEY

UNDER

47767

35776

Application No. 12602... Permit No. 10040.

IN NAME OF

NEAH-KAH-NIE WATER COMPANY

Surveyed August, 1965, by *[Signature]*
MAY 21, 1966 R. PASTER

41057-150-788

T1-12-200