
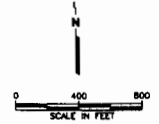


SEC. 32 T.6S. R.2E.W.M.

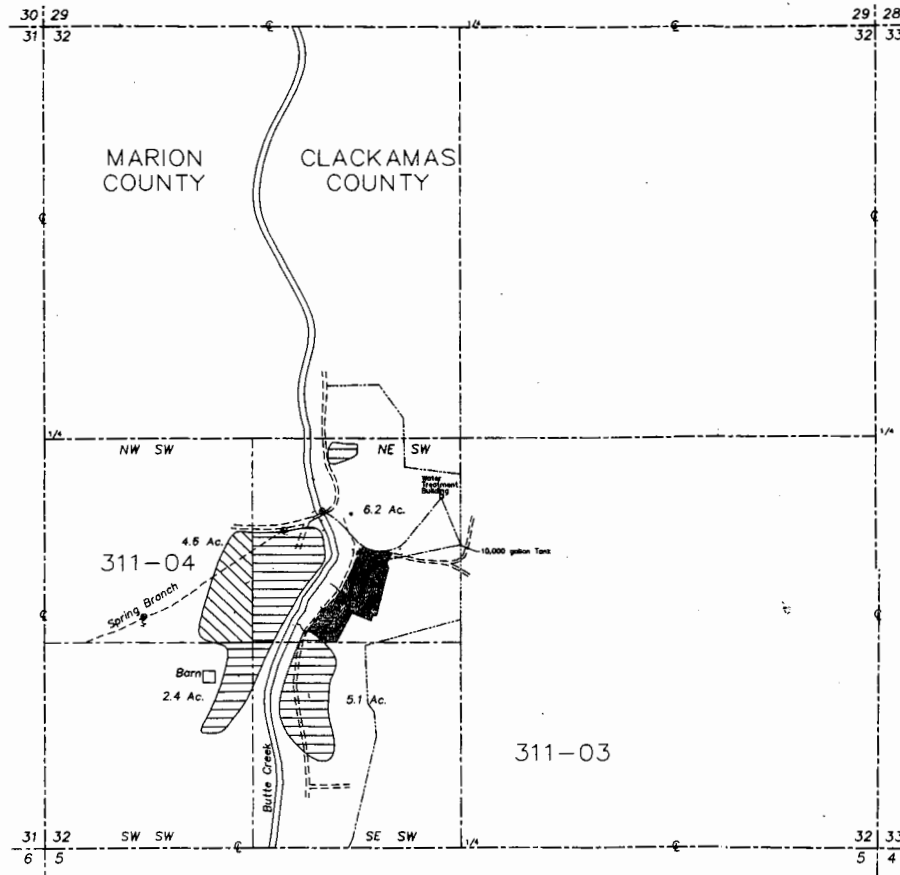

EXPLANATION:

- IRRIGATED FROM BUTTE CREEK AND AS PROVIDED FROM SPRING BRANCH WHEN WATER IS AVAILABLE AT ORIGINAL BUTTE CREEK DIVERSION POINT
- IRRIGATED FROM SPRING BRANCH
- COMMERCIAL USE
- 1 1/2-INCH-DIAMETER WATER LINE
- POINT OF DIVERSION


Irrigation System

Butte Creek point of diversion located 1,765 feet east and 470 feet south of the NW corner of Section 32.

Spring Branch points of diversion located: 1) 1,520 feet east and 585 feet south of the NW corner of Section 32; and 2) 1,150 feet south and 630 feet east of the NW corner of Section 32.

Commercial System

Point of diversion located on Butte Creek at 1,760 feet east and 460 feet south of the NW corner of Section 32.

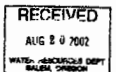

COBU MAP # 0102

Map drawing created from AutoCAD file entitled "Butte Creek Scout Camp Water Source Location," dated June 1997 provided by Curran-McLeod, INC. Consulting Engineers.

THE PURPOSE OF THIS MAP IS TO IDENTIFY THE LOCATION OF THE WATER RIGHT. IT IS NOT INTENDED TO PROVIDE INFORMATION RELATIVE TO THE LOCATION OF PROPERTY OWNERSHIP BOUNDARY LINES.

GeoEngineers

CLAIM OF BENEFICIAL USE MAP
WATER RIGHT TRANSFER T-7418