

G371
27659


G-371

T
27
S
300'

by the application
Fort Rock Ore.
ground waters by
an purposes.
6- T27S. R18E.W.M.
on.

ON
Lakeriew, Oregon
the foregoing map
old notes taken
y made by me
are as follows:-
7' from the North
6- T27S. R18E.W.M.
7.2' from the NE
27S. R18E.W.M.
1.5' from the NE
T27S. R18E.W.M.

Section corners
set as closely
original position
rents and
n the ground.
Surveyor
2. Oct.

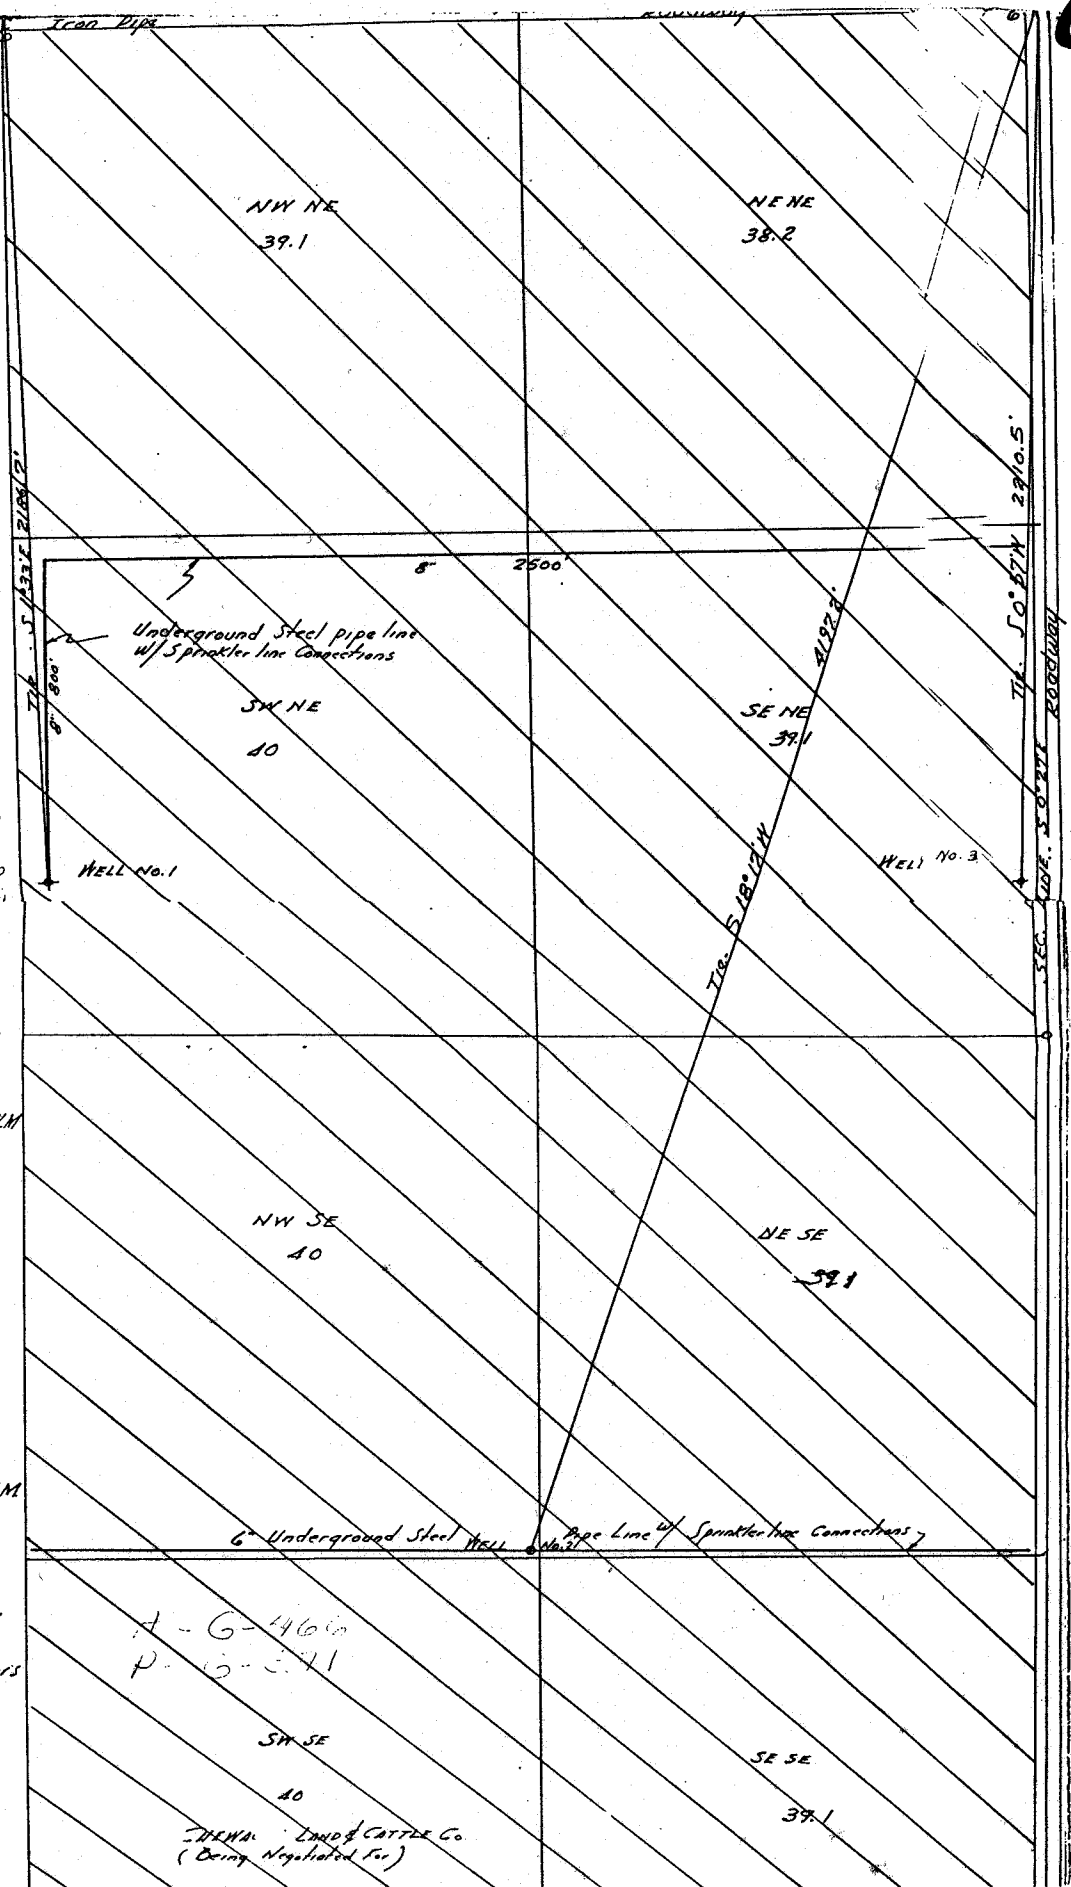

THEYAL LAND & CATTLE CO.
(Being Negotiated For)