


G-826
33068
T 8518
80941

T.27S.R.18E.W.M.

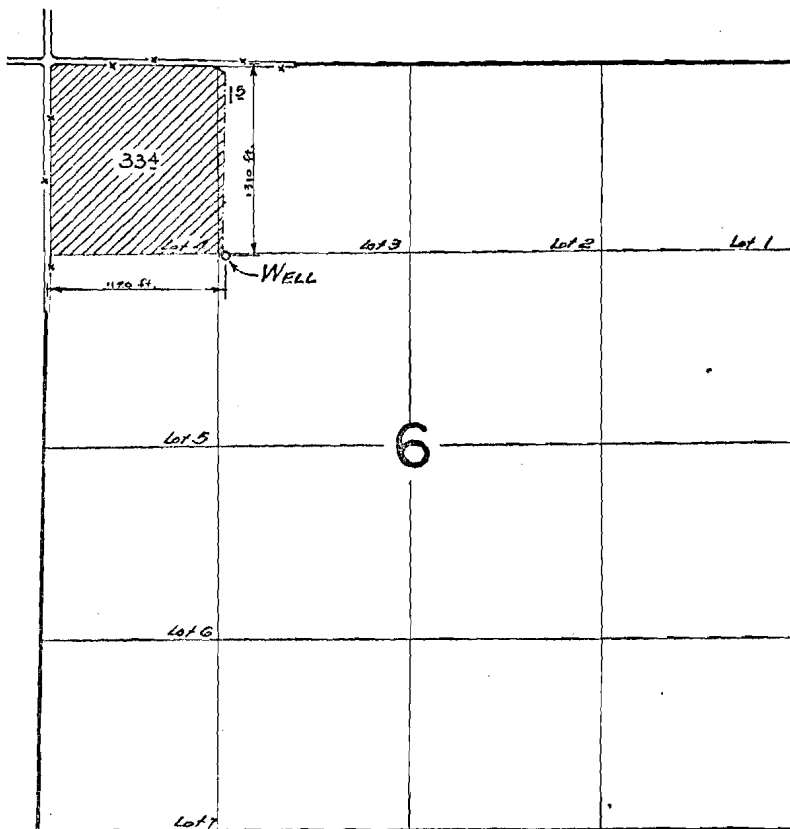

FINAL PROOF SURVEY
UNDER

Application No. G-881 Permit No. G-826
IN NAME OF

ROBERT MOREHOUSE

Surveyed Sept. 10 1964, by *R. H. Jackson*