

C-1-20

T.25S., R.17 & 18E., W.M.

-  G-9261 WELL #5
-  G-7841 WELL #1
-  G-6530 WELL #6
-  G-9261 WELL #1
-  G-9261 WELL #3
-  G-9261 WELL #2

FINAL PROOF SURVEY UNDER

G-7043 G-6530
G-7174 G-7841
Application No. 5-10068 Permit No. 5-9261


IN NAME OF

DAVID & GALYN ROTH

Surveyed AUG. 31, 1988 by B. BISHOP

1-19-89
revised 6-28-2004 by dlc
PTS 11-1988

MAP FILE C-1-20

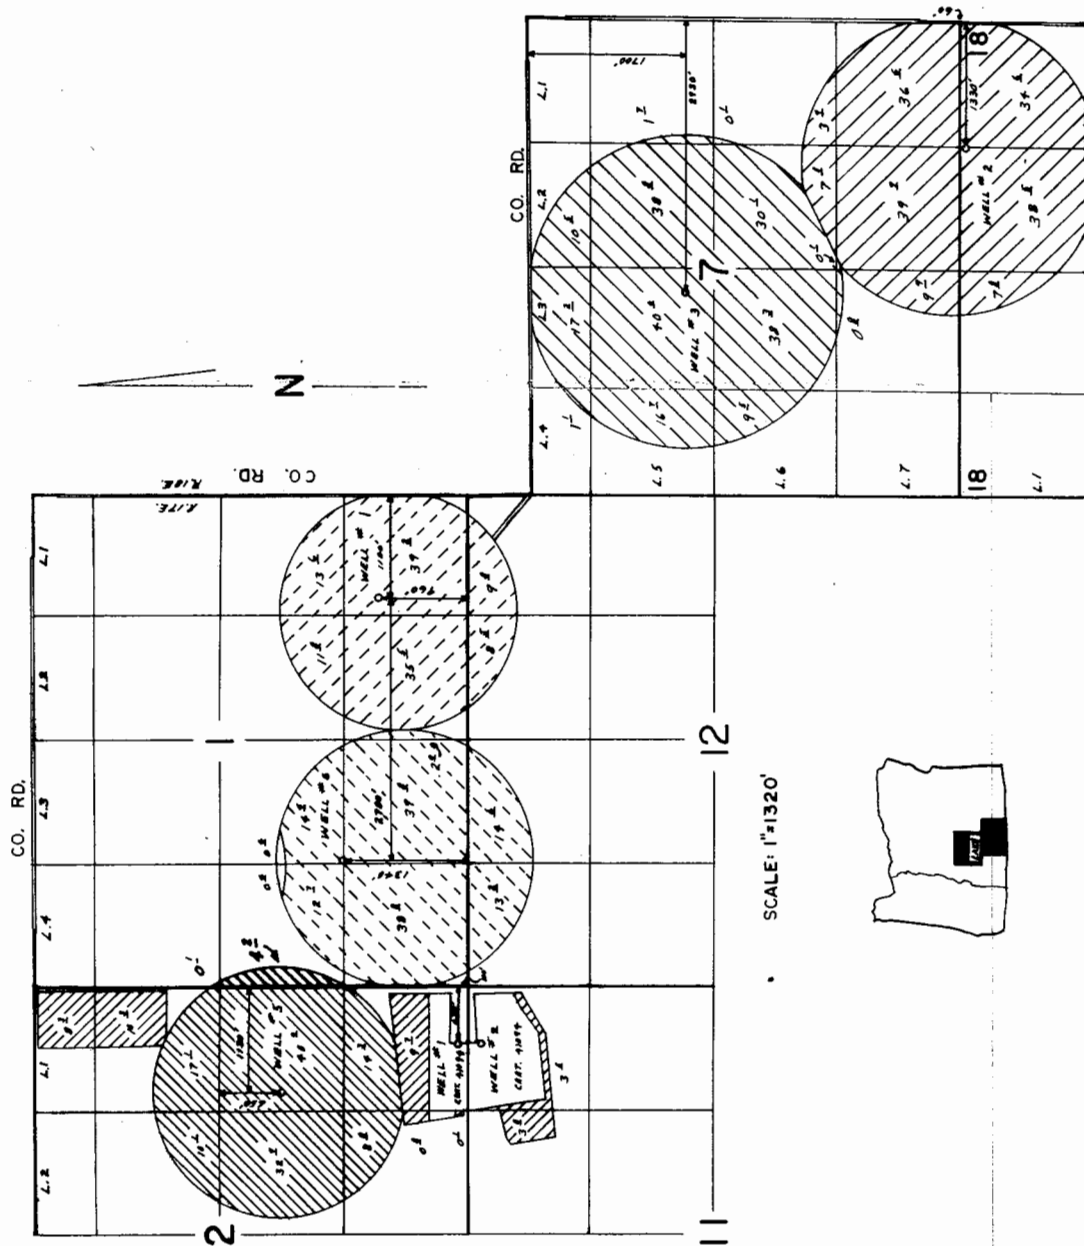

SCALE: 1"=1320'

