


T.7S. R.1^EW. W.M.
MARION COUNTY

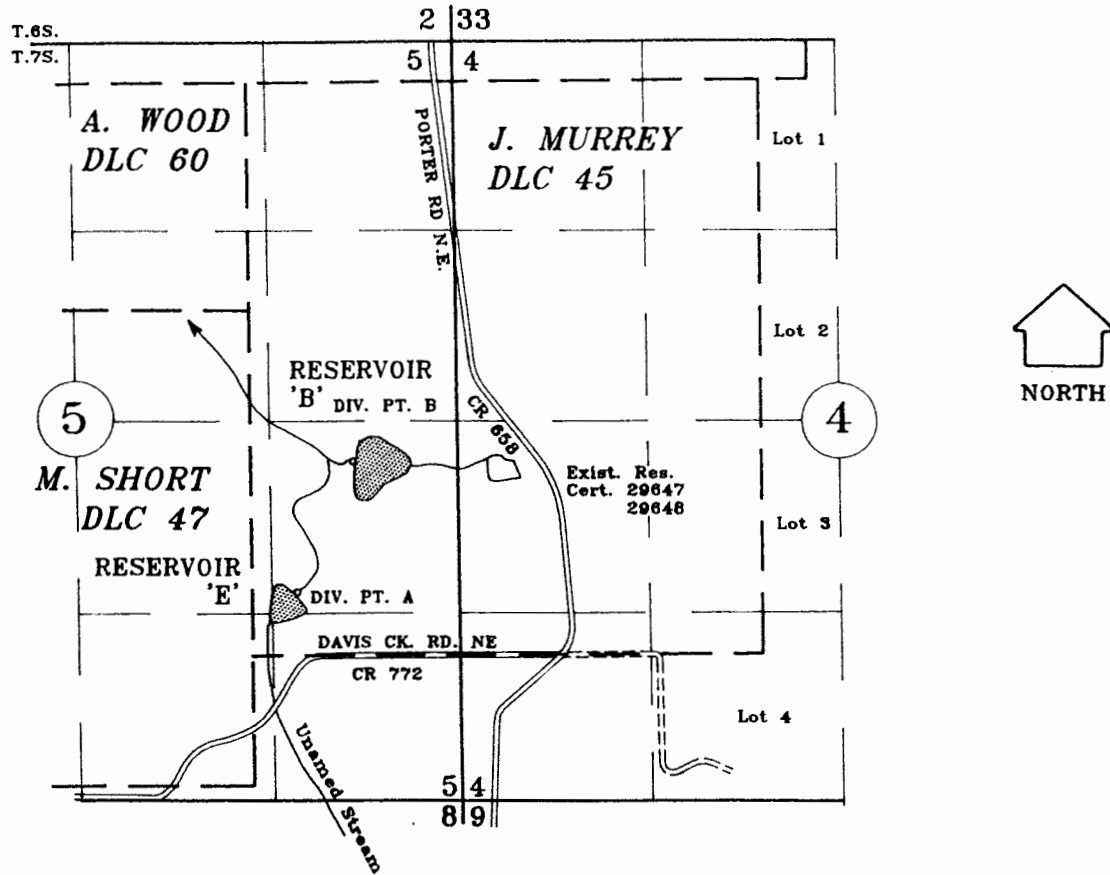

DIV. PT. A LOCATION: 450' N & 282' E OF SW COR. J. MURREY DLC 45
DIV. PT. B LOCATION: 1352' N & 708' E OF SW COR. J. MURREY DLC 45

Application No. R-72533
S-72534

Permit No. R-11605
S-51839

FINAL PROOF SURVEY

IN NAME OF

Kathryn J. Adkins

AUGUST 11, 1998

SCALE 1" = 1320'

RECEIVED

OCT 01 1998

WATER RESOURCES DEPT.
SALEM, OREGON

NOTE: This map is for the purpose of identifying the location of water rights and has not intent to dimension or locate property ownership lines.

