


T.6N.R.34E.W.M.

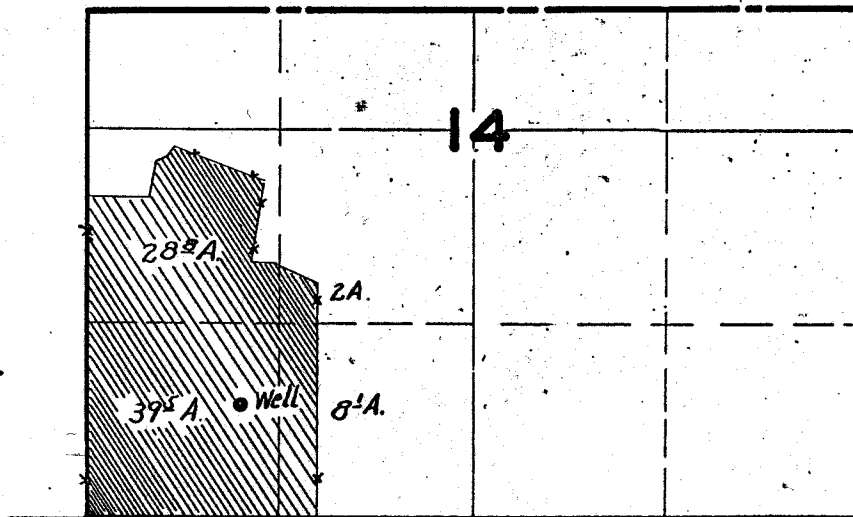

FINAL PROOF SURVEY UNDER

Application No. U_359... Permit No. U_334.
IN NAME OF

..... O. J. HELLBERG

Surveyed .OCT. 9. 1950, by H.L. COFFMAN