


T.30S. R.6W. W.M.

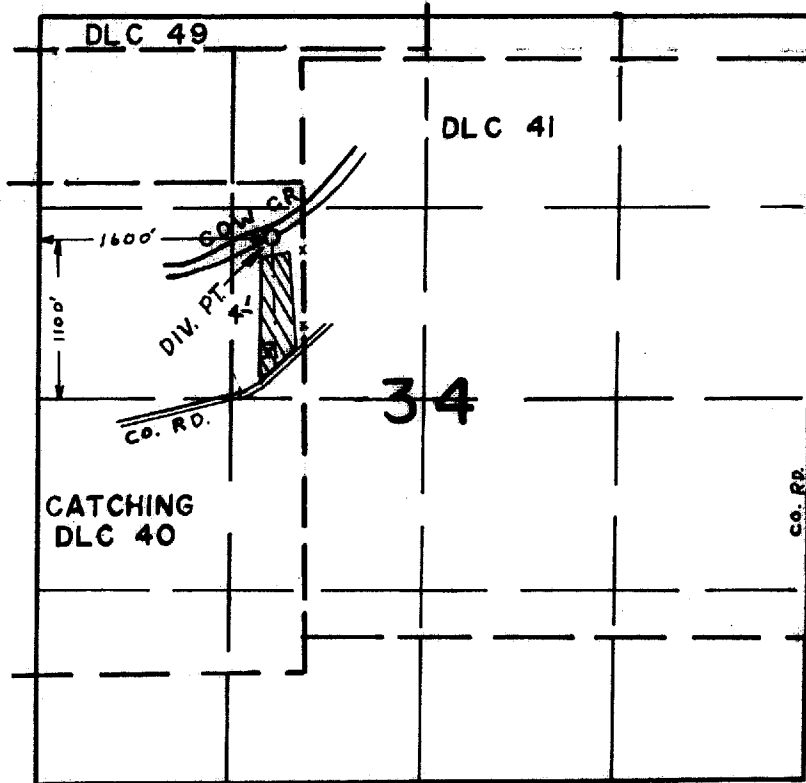

FINAL PROOF SURVEY UNDER

Application No. 47522 Permit No. 35589
IN NAME OF

FRANCIS M. MORGAN

Surveyed JULY 2, 1974, by L. H. NUNN