


R.R. HIGHWAY

K 1084B

2

Application No.
Permit No.

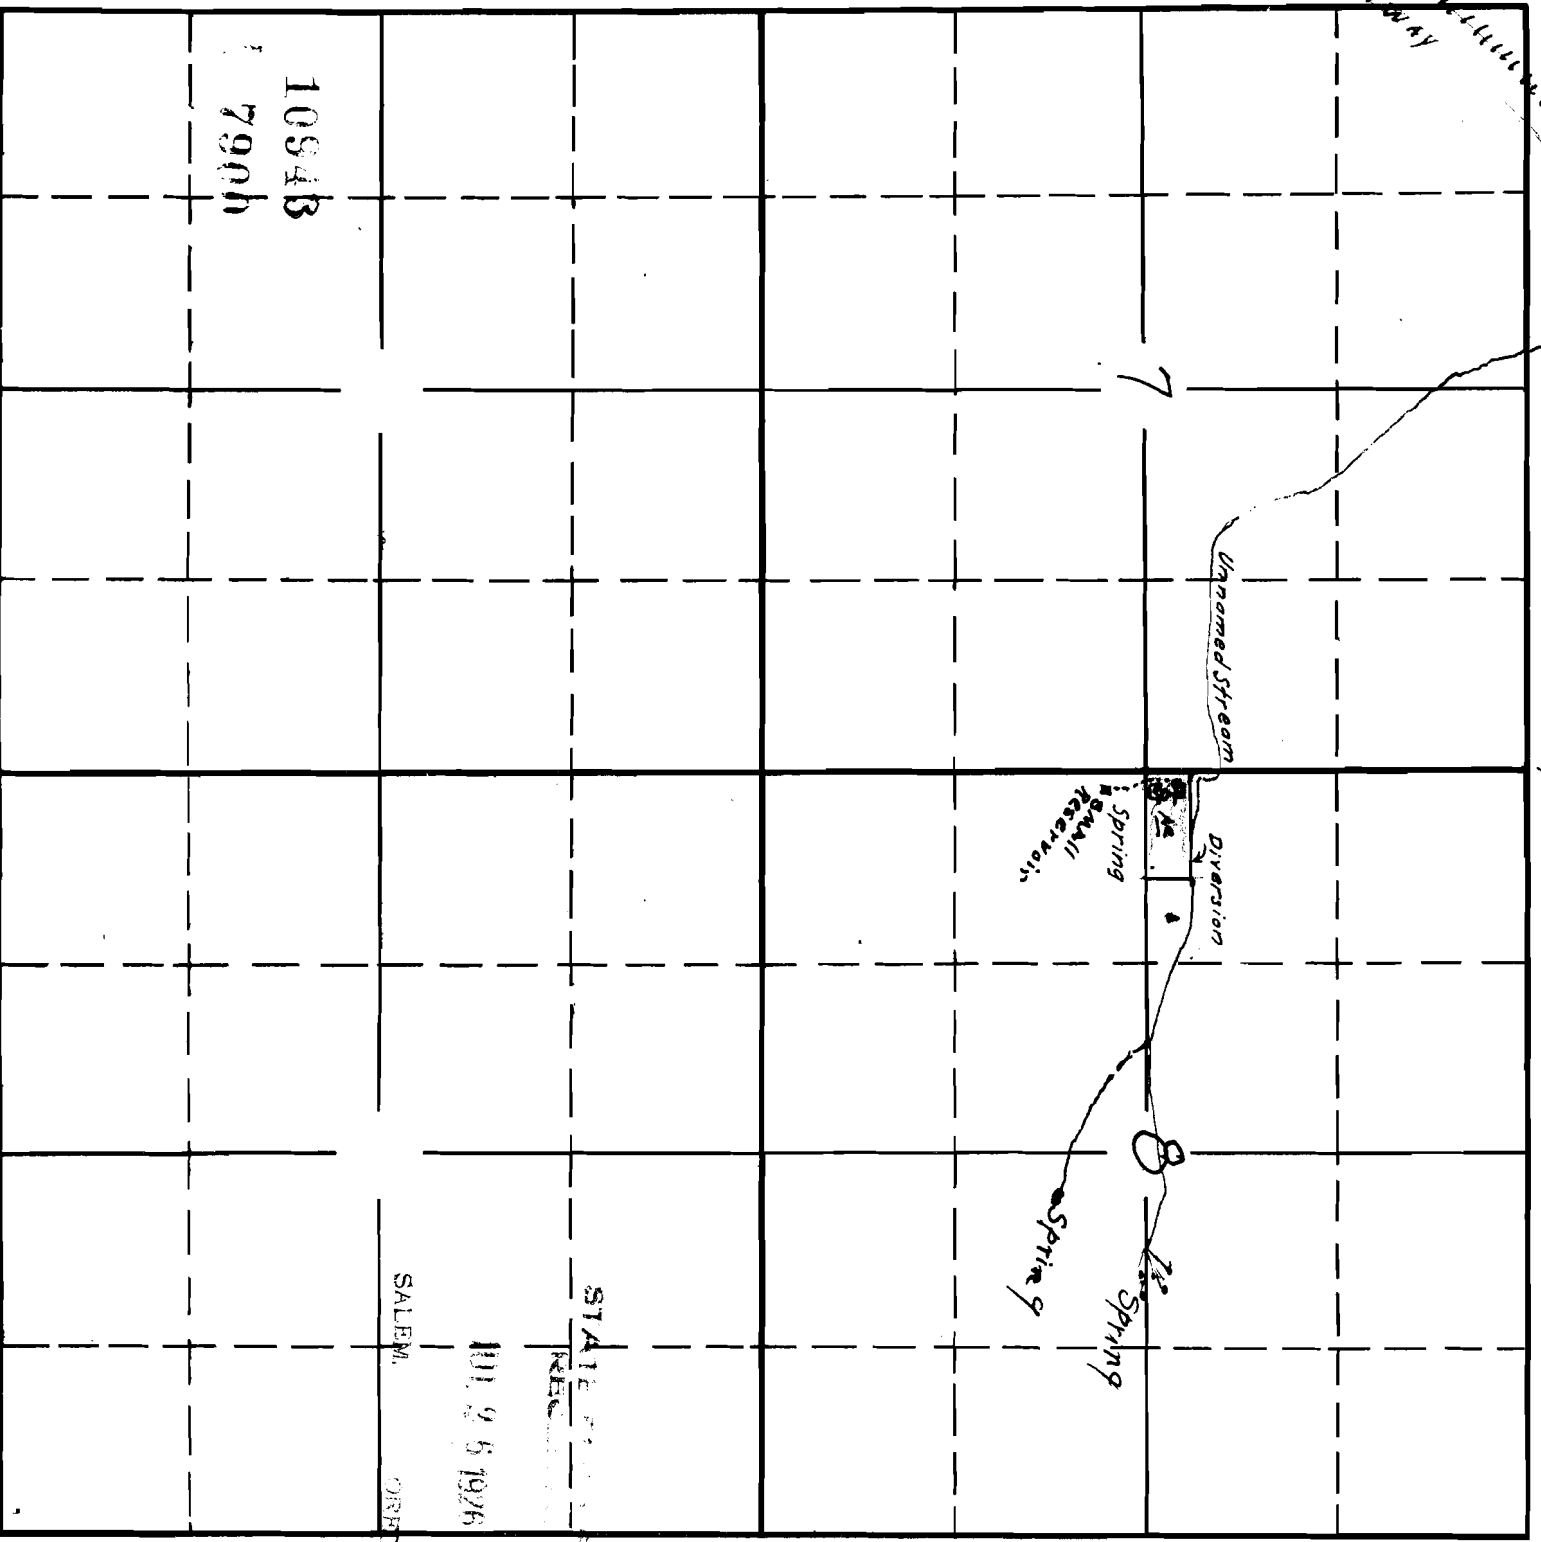

1084B
790b

STATE OF OREGON
RECORDS
JUL 25 1976
SALEM GREGG

Sec. 7
8
Tp. 4S
R. 1E

E