


TOWNSHIP 2 NORTH, RANGE 10 EAST, W.M.

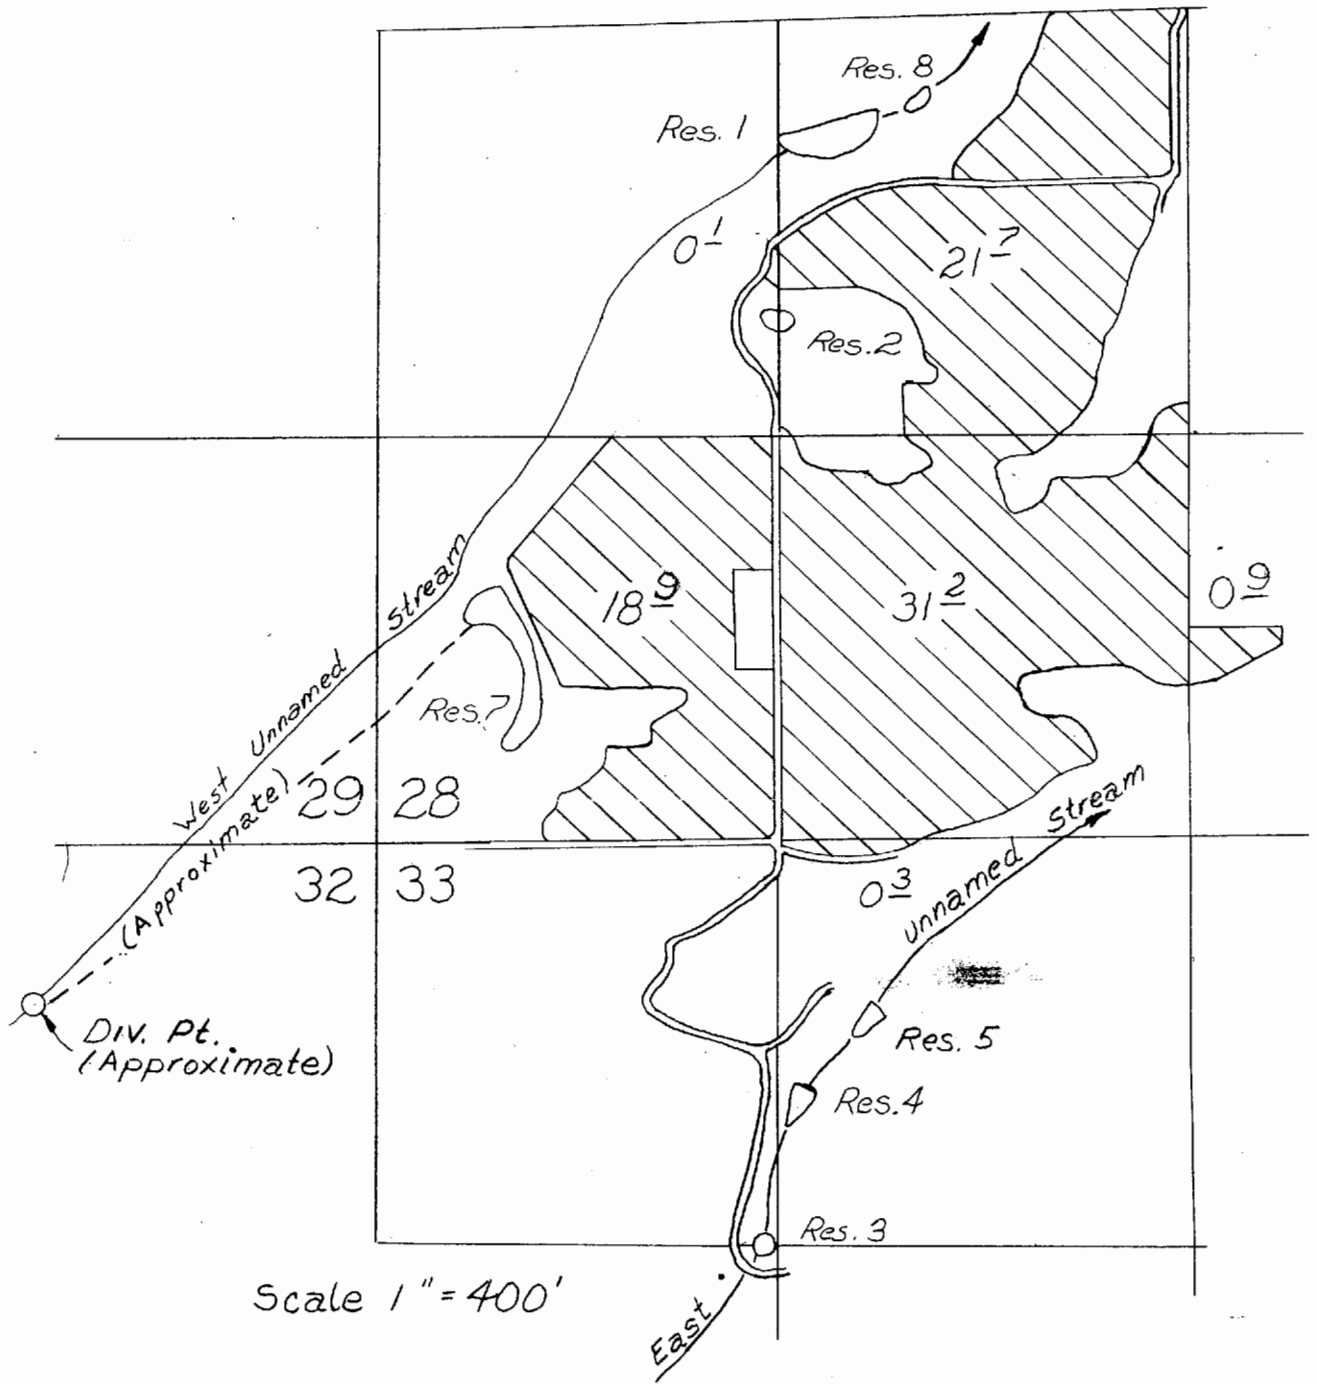

FINAL PROOF SURVEY

UNDER

Application No.'s: R-67951, R-67952, 67335

Permit No.'s: R-10835, R-10836, 50046

IN THE NAME OF

GOLDEN MOUNTAIN, LLC

Surveyed: 4 June 2004 by L. Toll

[Signature]
7-14-04