
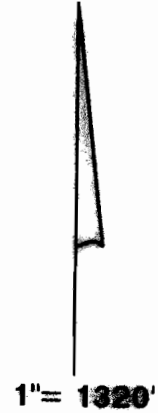


T.S.S., R.1W., W.M.

RECEIVED

SEP 9 1993

WATER RESOURCES DEPT
SALEM, OREGON

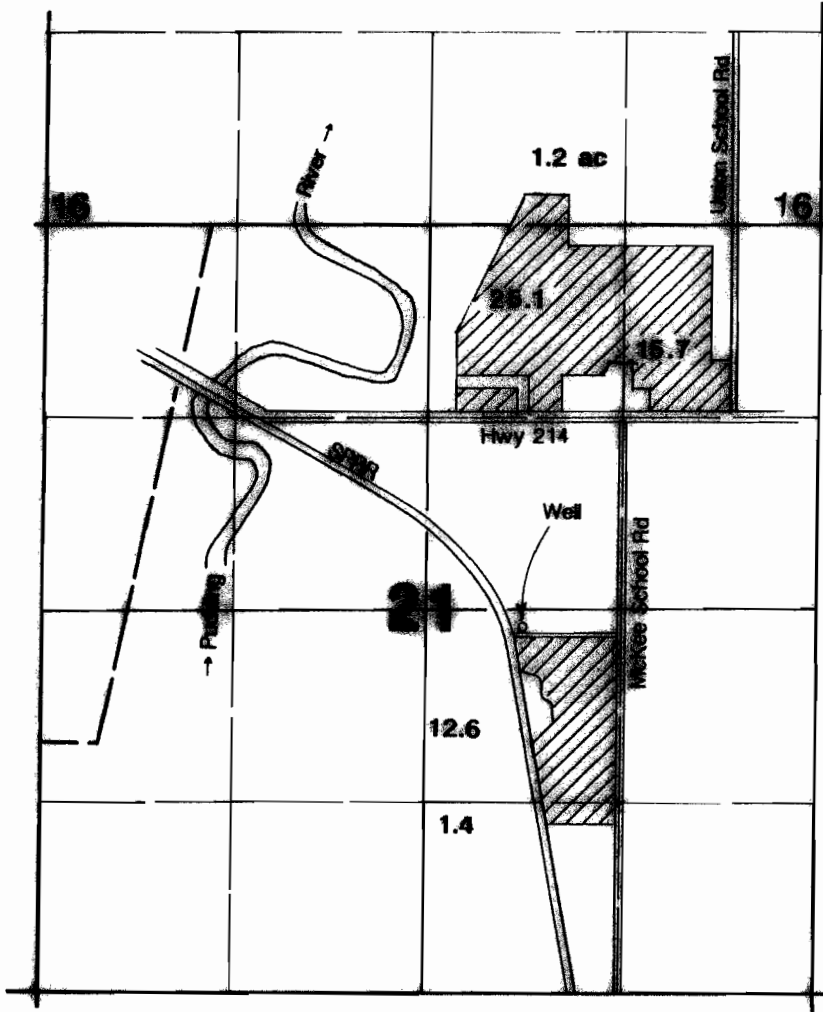

Well located 2500'N & 2000'W from SE corner Section 21.



Final Proof Survey

Application #: G-12183

Permit #: G-11494

In Name Of

Carl I. Vistola

Surveyed by Jim Schuette on August 19, 1988

WATER RESOURCES DEPARTMENT

T 7632