


FINAL PROOF SURVEY MAP IN THE NAME OF DOUGLAS COUNTY NATURAL RESOURCES

PERMIT 19149 TRANSFER T-8354

SECTIONS 9 & 16, TOWNSHIP 23 SOUTH, RANGE 4 WEST, W.M.

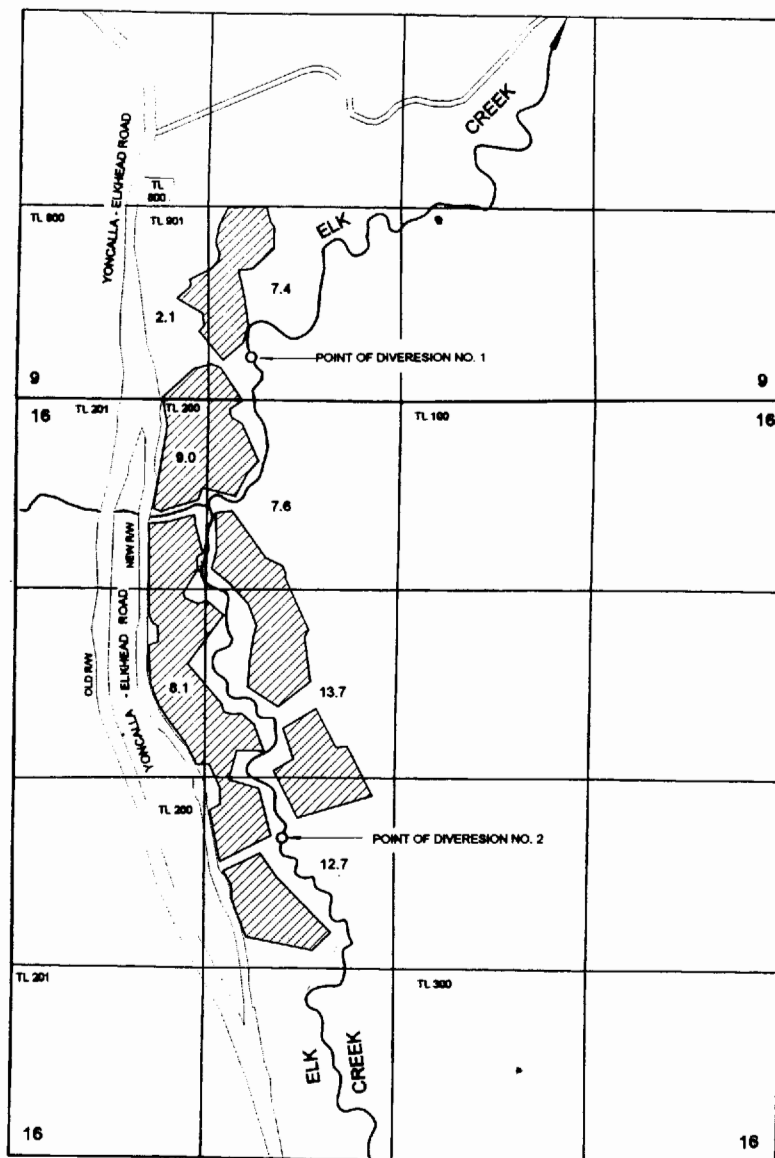

RECEIVED

OCT 8 2004

EPT
REGON

POINT OF DIVERSION No. 1 IS LOCATED 275 FEET NORTH AND 1650 FEET EAST FROM THE NORTHWEST CORNER OF SECTION 16; BEING WITHIN THE SE $\frac{1}{4}$ SW $\frac{1}{4}$ OF SECTION 9; AND

POINT OF DIVERSION No. 2 IS LOCATED 3080 FEET SOUTH AND 1820 FEET EAST, FROM THE NORTHWEST CORNER OF SECTION 16; BEING WITHIN THE NE $\frac{1}{4}$ SW $\frac{1}{4}$ OF SECTION 16; BOTH DIVERSIONS WITHIN TOWNSHIP 23 SOUTH, RANGE 4 WEST, W.M.; DOUGLAS COUNTY.