


FINAL PROOF MAP OF TRANSFER T-7577 FOR WILSON DITCH COMPANY

T3N, R230E WM

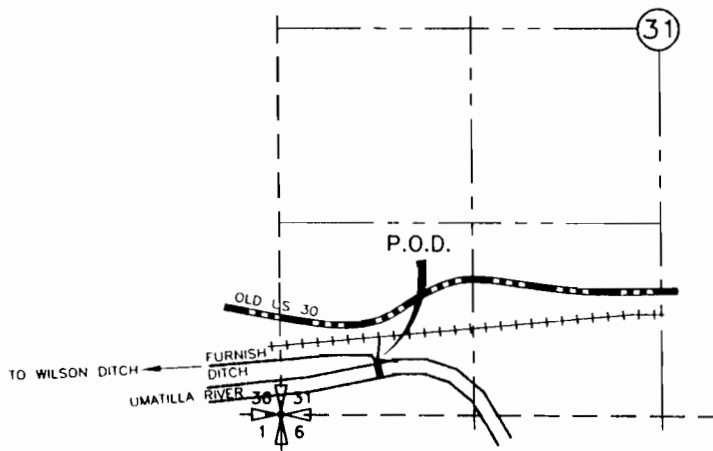

ADDITIONAL P.O.D. FURNISH DITCH


P.O.D. FURNISH DITCH
LOCATED 380' NORTH AND 650' EAST
FROM THE SW CORNER SEC 31



0 1320 2640



SCALE IN FEET

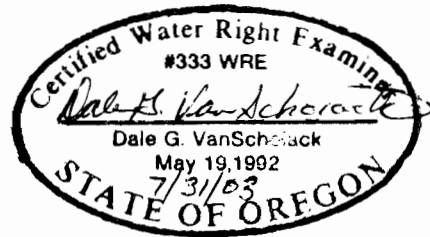

NOTE:
THE PURPOSE OF THIS MAP IS TO IDENTIFY THE APPROXIMATE LOCATION
OF THE WATER RIGHT. IT IS NOT INTENDED TO PROVIDE INFORMATION
RELATIVE TO THE LOCATION OF PROPERTY OWNERSHIP BOUNDARY LINES.

7/30/03

SCM Consultants, Inc.
A Tetra Tech Company

DRAWING: H:\CAD\AG\3522\038\35220FP.DWG
PRINTED BY: rogerw on 07/30/03 02:11 PM