


T. 7S. R. 1E. W.M.

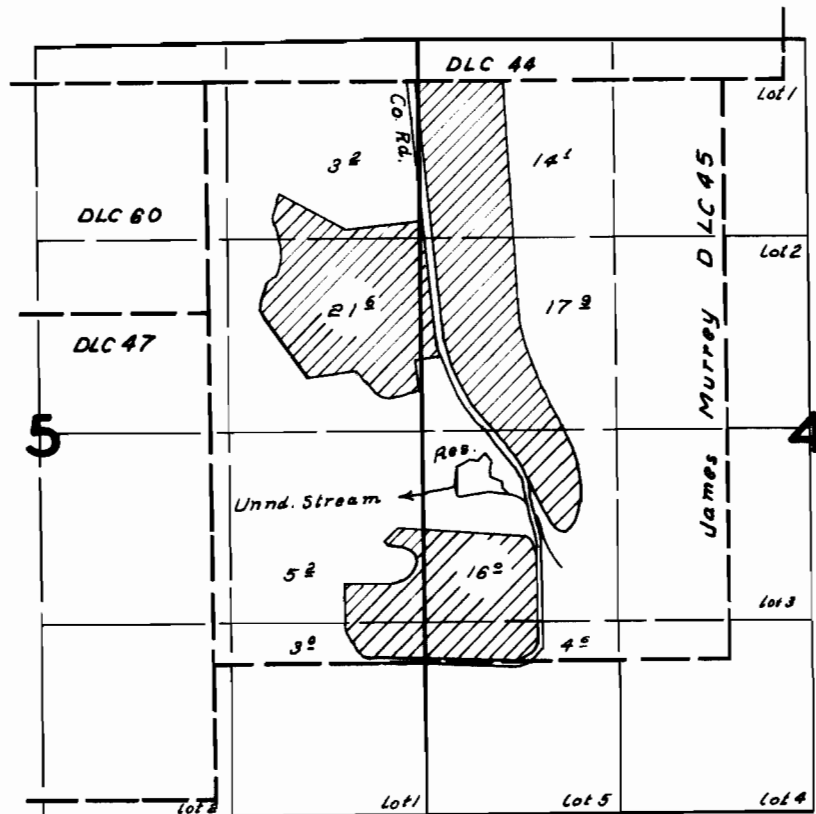

FINAL PROOF SURVEY
UNDER

Application No. *R-27388* Permit No. *R-1611*
27389 *22889*
IN NAME OF

Oscar H. Loe

Surveyed *March 13/16/1959*, by *R. H. Jackson*