


T. 38 S., R. 3 W., W.M.

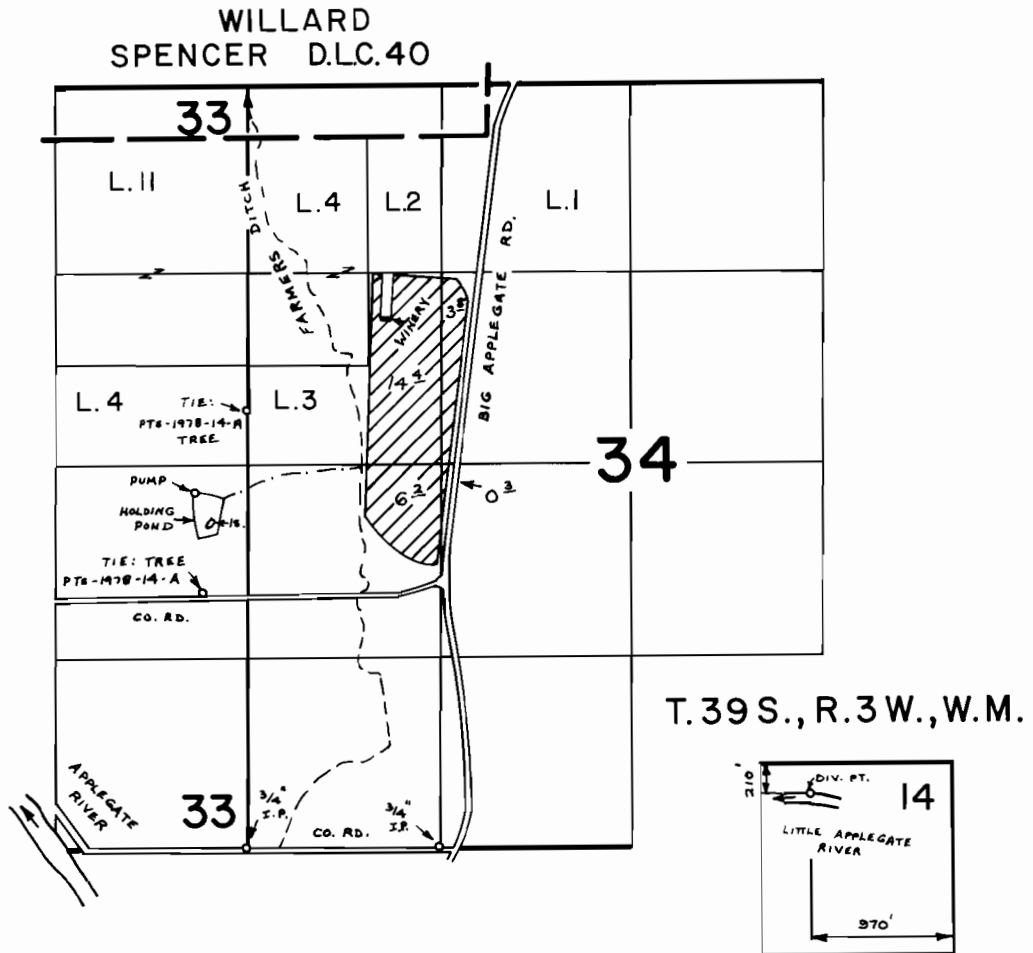

FINAL PROOF SURVEY UNDER

Application No. 48804 Permit No. 36586
IN NAME OF

FRANK WISNOVSKY

Surveyed JUN. 12 1978, by B. SUND

D.H.M.
P.T.S. - 1978 - 14 - A
& BAX - 4AA - 64