


# T.8S. R.1W., W.M.

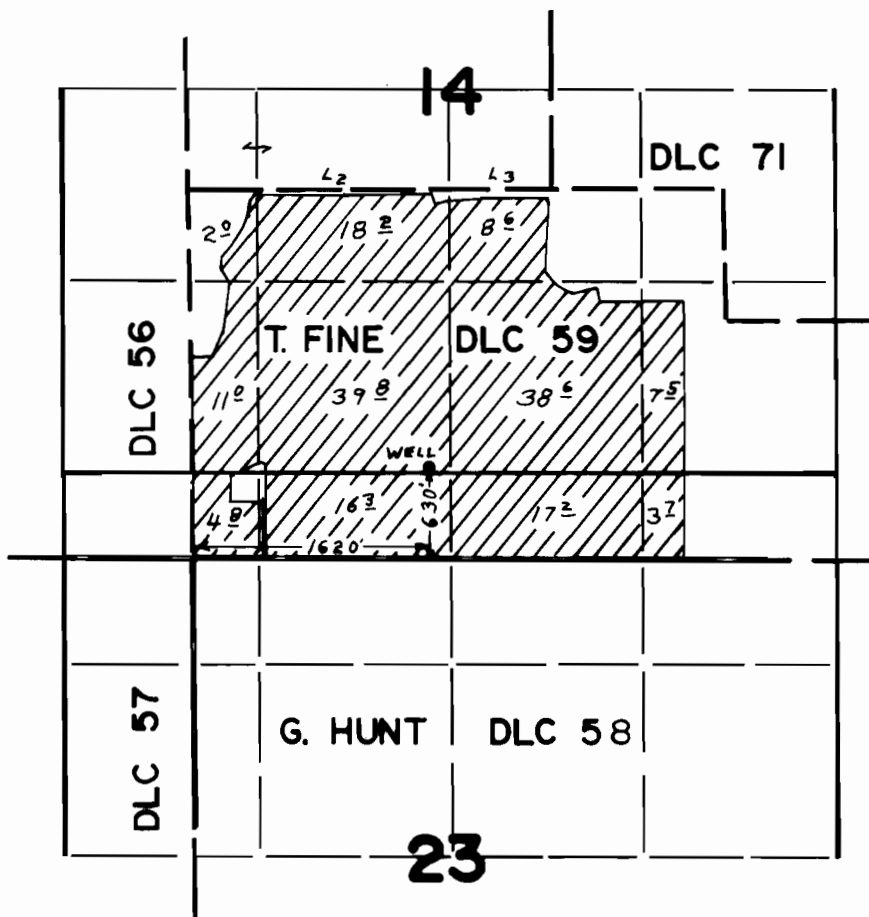

## FINAL PROOF SURVEY UNDER

Application No. G-6041... Permit No. G-5718  
IN NAME OF

TRIUMPH, INC.

Surveyed OCT. 19 1978, by S.P. APPLGATE.