


P.G-3540
41322
T9256
81005
T9256

T. 26S.R.14E.W.M.

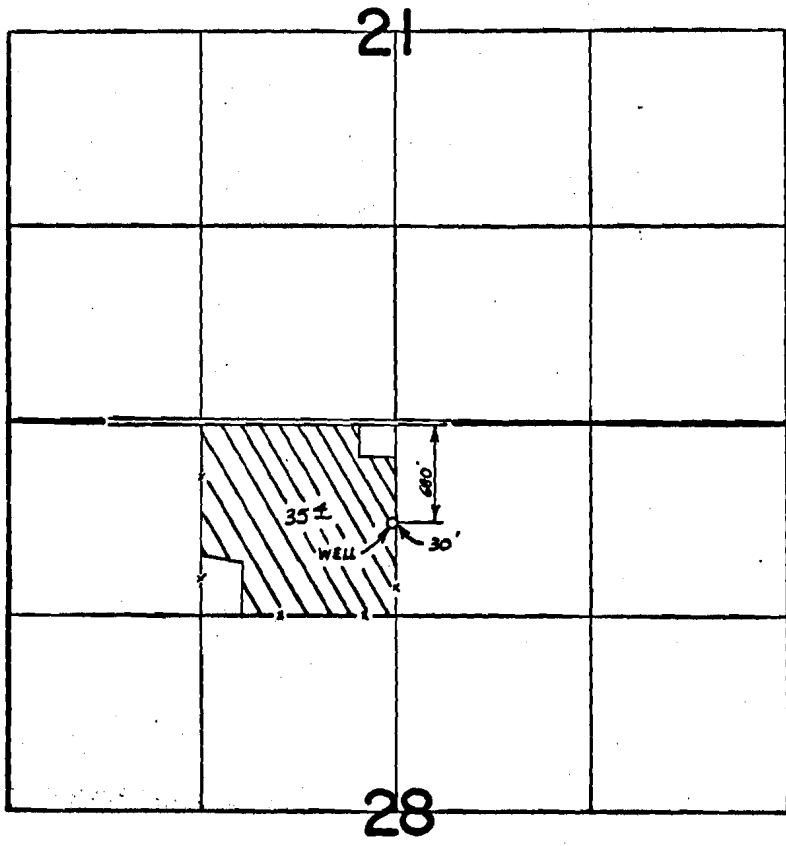

FINAL PROOF SURVEY
UNDER

Application No. G-3748 Permit No. G-3540
IN NAME OF

G. R. BOATWRIGHT

Surveyed AUG. 22 1973, by R. G. MUCKEN