

P.G-4866

41330


T9256

80645

81006

T 9256

T. 26 S. R. 14 E. W.M.

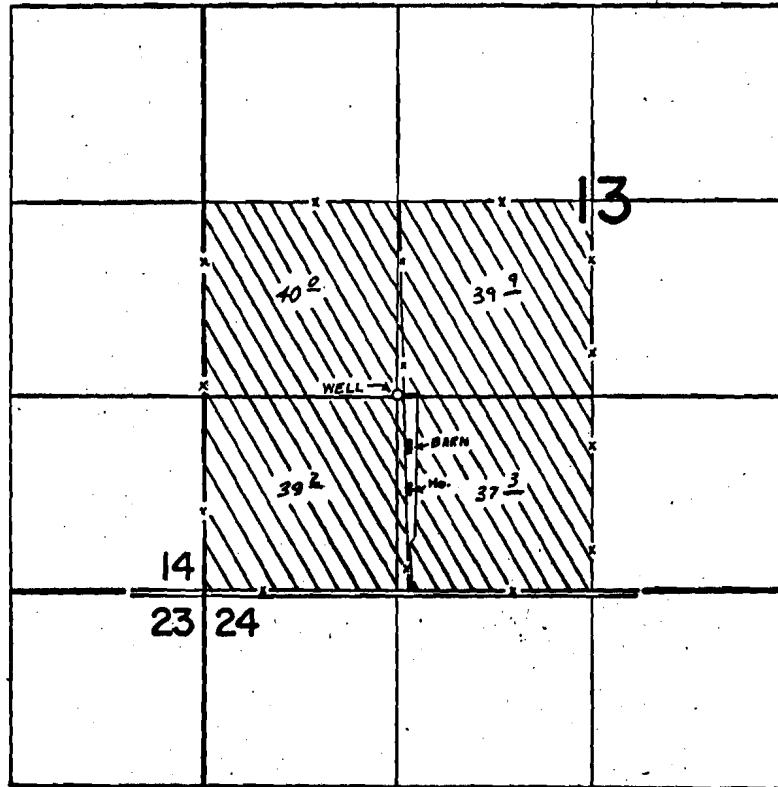

WELL 1320' N. & 1320' E. FROM SW COR. SEC. 13

FINAL PROOF SURVEY UNDER

Application No. G-5129 Permit No. G-4866
IN NAME OF

ANDREW BETTENCOURT

Surveyed AUG 21 1973, by R.G. MUCKEN