

**RECEIVED**


**T. 18 S., R. 47 E., W. M.**

OCT 06 1998


WATER RESOURCES DEPT.  
SALEM, OREGON

SCALE 1" = 1320'

City of Ontario  
444 SW 4th Street  
Ontario, OR 97914

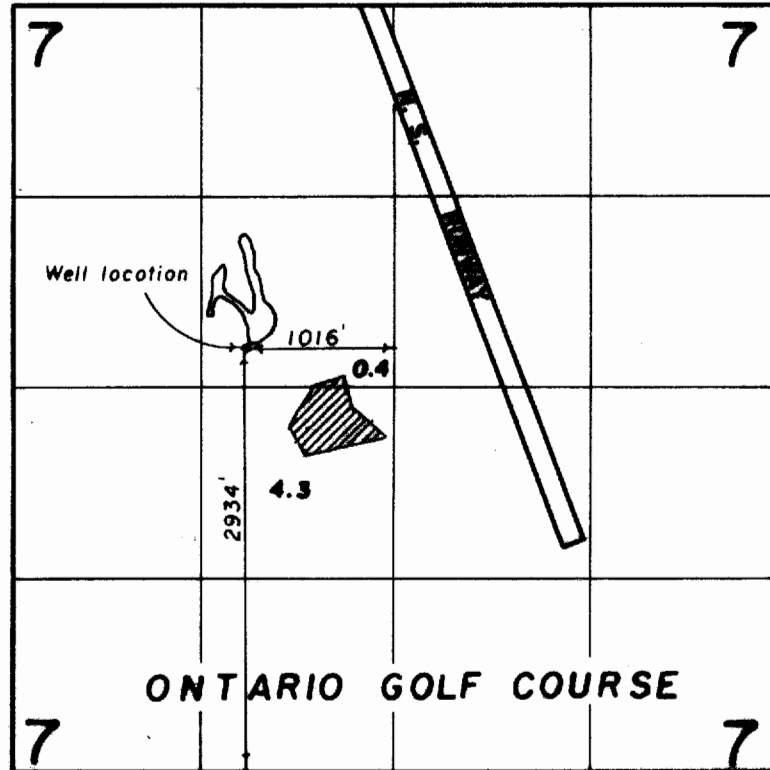

FINAL PROOF SURVEY  
UNDER APPLICATION No. G-11589, PERMIT  
No. G-10885

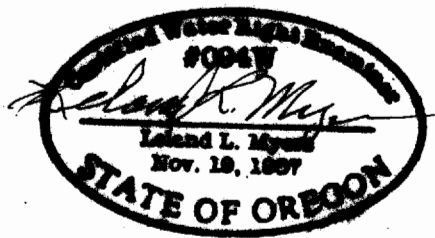

This map is for the purpose of identifying the location of the water right only and has no intent to provide dimensions or location of property ownership lines.