


T.2N.R.4&5W.W.M.

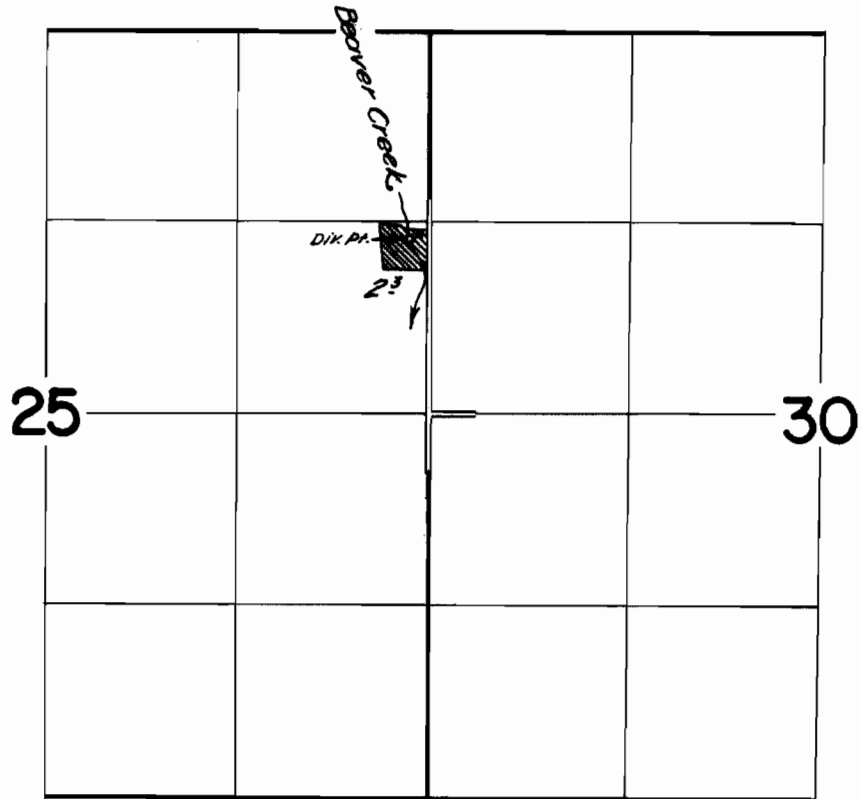

FINAL PROOF SURVEY  
UNDER

Application No. 32936... Permit No. 26029...  
IN NAME OF

**CECIL B. & LOUISE GRAHAM**

Surveyed July 28, 1961, by *R. Jackson*