


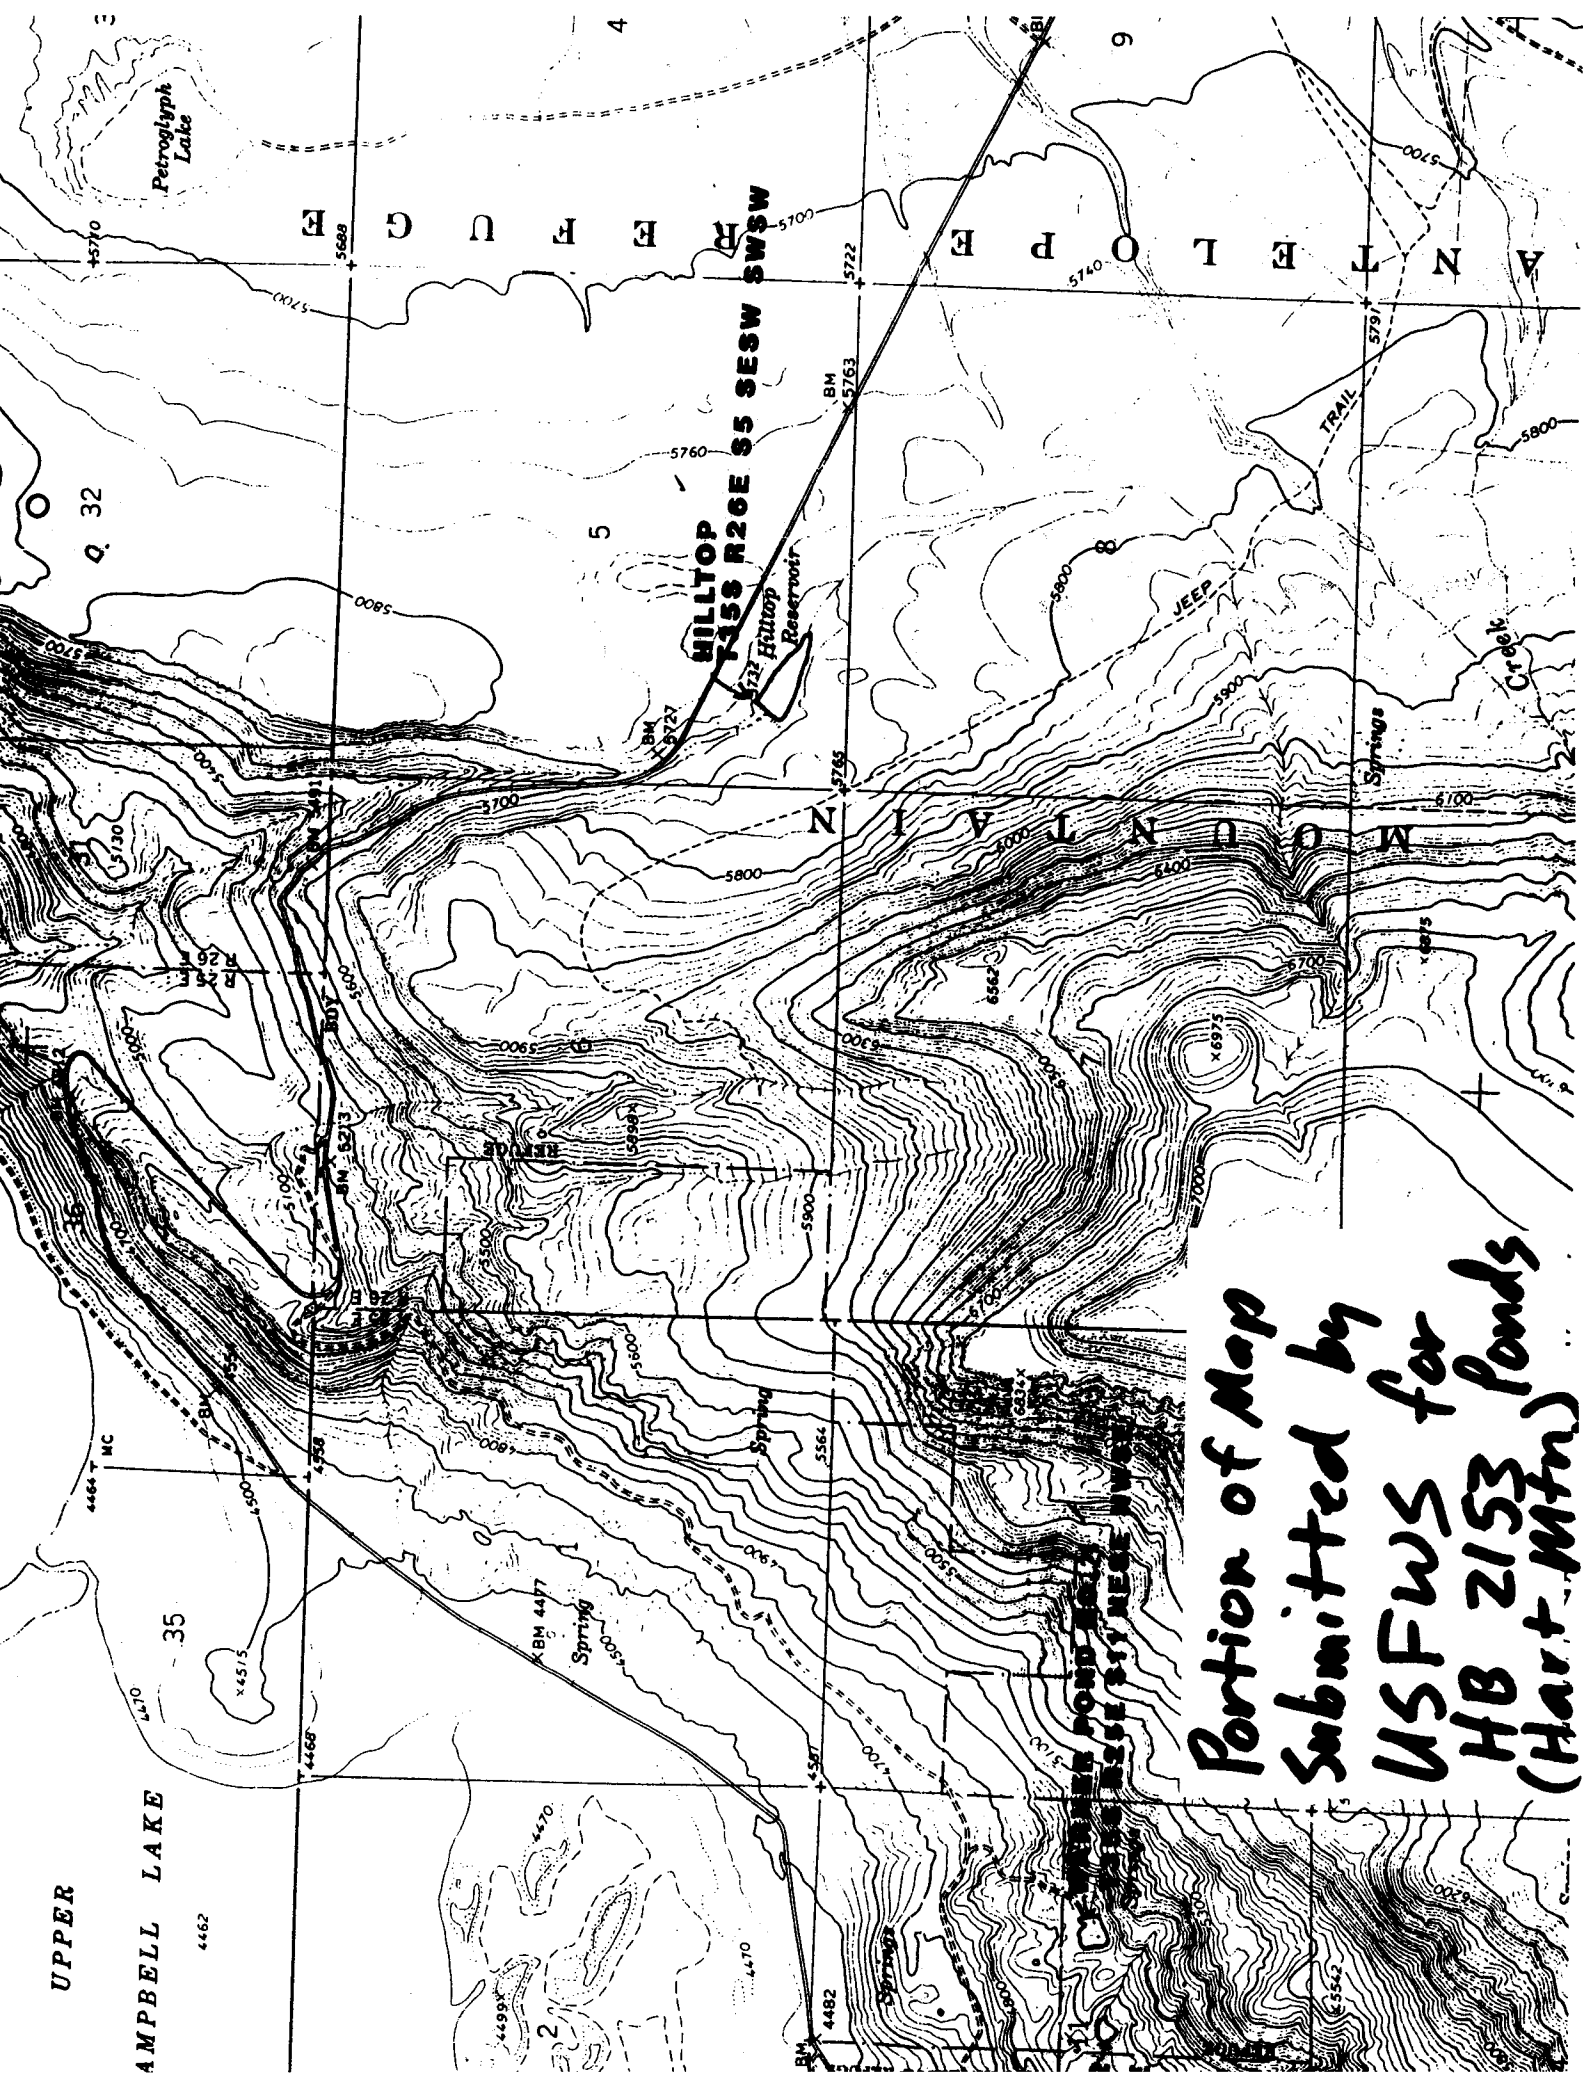

Portion of Map
Submitted by
USFWS for
HB 2153 Ponds
(Hart Mtn)