


CLAIM OF BENEFICIAL USE MAP

UNDER APPLICATION R-81932; PERMIT R-12371

SE1/4 NE1/4 SEC 13 T 38S R 40E W.M.

U.S.G.S. QUAD - BLUE MOUNTAIN BASIN, OREG. - 7 1/2'

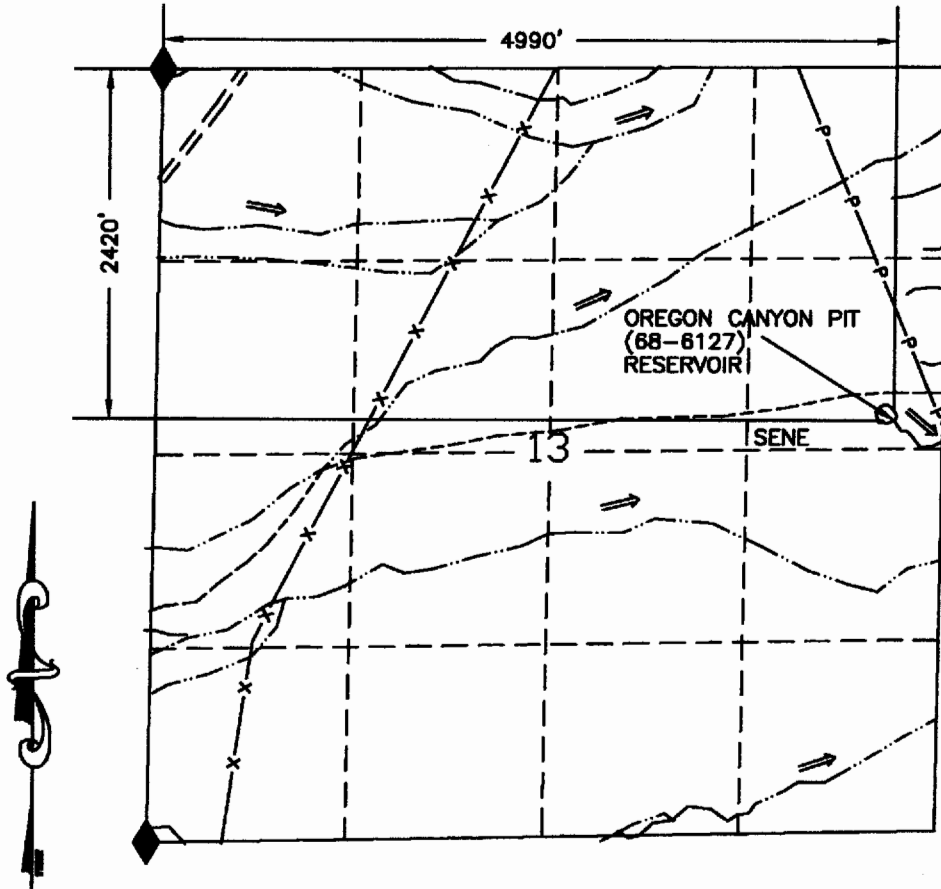

RECEIVED

JUL 03 2003

WATER RESOURCES DEPT.
SALEM, OREGON

LEGEND

- RESERVOIR
- == ROAD
- - - CHANNEL
- ◆ FD SEC COR
- - - TRAIL
- P - POWER LINE
- x - FENCE

OREGON CANYON PIT (68-6127) RESERVOIR

1320 660 0 1320
SCALE 1"=1320'

I, Thomas Terry ADM Operations/Field Services agree to the findings of the CWRE and do submit this site report and map as my Claim of Beneficial Use of the water as provided under the terms and conditions of my Permit R-12371

Thomas Terry

THIS MAP IS FOR THE PURPOSE OF LOCATING A WATER RIGHT AND IS NOT INTENDED TO PROVIDE LEGAL DIMENSIONS FOR LOCATION OF PROPERTY BOUNDARIES.



ACAD2001/LDD
DWG FILEDREGCANPBN

UNITED STATES DEPARTMENT OF THE INTERIOR
BUREAU OF LAND MANAGEMENT
DIVISION OF OPERATIONS VALE DISTRICT

OREGON CANYON PIT (68-6127) RESERVOIR

DRAWN BY: *Thomas R. P. [Signature]*
SURVEYED: *Thomas R. P. [Signature]*
APPROVED: *Thomas Terry*
ADM OPERATIONS AND FIELD SERVICES

DRAWN: CG SCALE: 1"=1320'

DATE: 11/02/01 SHEET 1 OF 1

DRAWING NO. OR-03-9172.45-1109