


CLAIM OF BENEFICIAL USE MAP

UNDER APPLICATION R-81934; PERMIT R-12372

NE1/4 NE1/4 SEC 7 T 38S R 43E W.M.

U.S.G.S. QUAD - BATTLE MOUNTAIN, ORG. - 7 1/2'

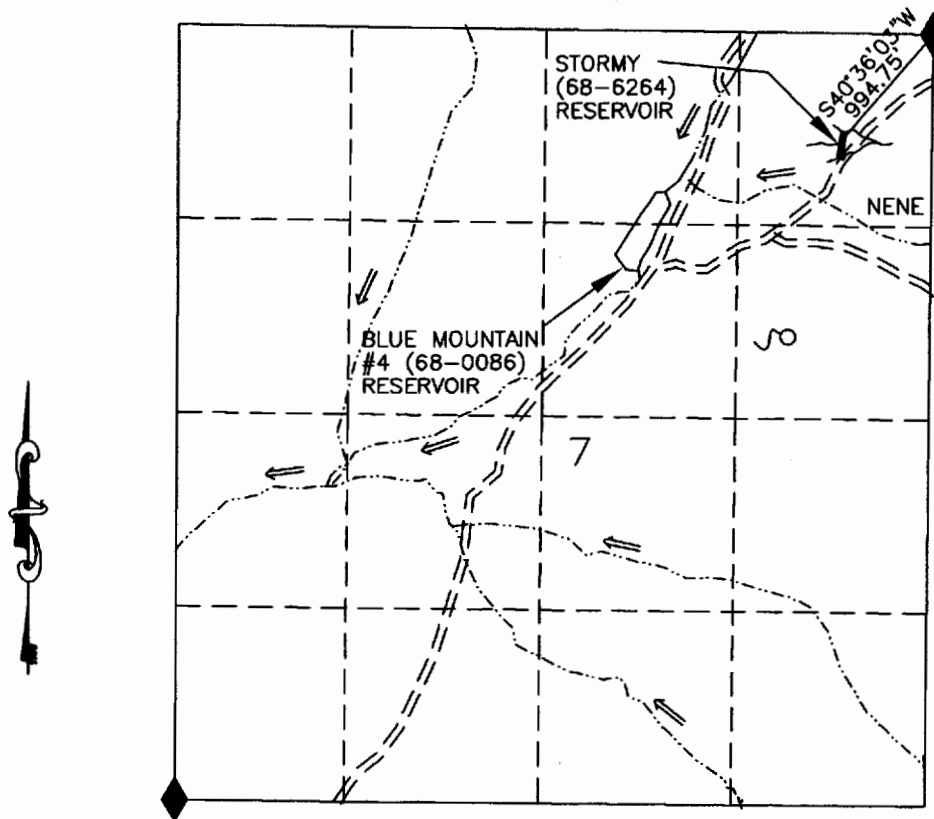

RECEIVED

JUL 14 2003

WATER RESOURCES DEPT.
SALEM, OREGON

LEGEND

-  RESERVOIR ON QUAD
-  RESERVOIR NOT ON QUAD
-  ROAD
-  CHANNEL
-  FD SEC COR
-  SPRING

STORMY (68-6264) RESERVOIR

1320 660 0 1320
SCALE 1"=1320'

I, Thomas D. Terry, ADM Division of Field Support agree to the findings of the CWRE and do submit this site report and map as my Claim of Beneficial Use of the water as provided under the terms and conditions of my Permit R-12372.

Thomas D. Terry

ALWAYS
THINK
SAFETY

THIS MAP IS FOR THE PURPOSE OF LOCATING A WATER RIGHT AND IS NOT INTENDED TO PROVIDE LEGAL DIMENSIONS FOR LOCATION OF PROPERTY BOUNDARIES.

ACAD2000!
DWG FILE: STORMYBEN

UNITED STATES DEPARTMENT OF THE INTERIOR BUREAU OF LAND MANAGEMENT DIVISION OF OPERATIONS VALE DISTRICT	
STORMY (68-6264) RESERVOIR	
DRAWN BY: <i>Thomas D. Terry</i>	
SURVEYED: <i>Thomas D. Terry</i>	
APPROVED: <i>Thomas D. Terry</i> ADM OPERATIONS AND FIELD SERVICES	
DRAWN: CG	SCALE: 1"=1320'
DATE: 7/07/03	SHEET 1 OF 1
DRAWING NO. OR-03-9172.45-1112	