

CLAIM OF BENEFICIAL USE MAP

UNDER APPLICATION R-81935; PERMIT R-12600

SW1/4 SW1/4 SEC 13 T 32S R 45E W.M.

U.S.G.S. QUAD - JUNIPER RIDGE, OREG. - 7 1/2'

LEGEND

▷ RESERVOIR

== ROAD


--- CHANNEL

◄ FD SEC COR

~ SPRING

-x- FENCE

— PIPELINE

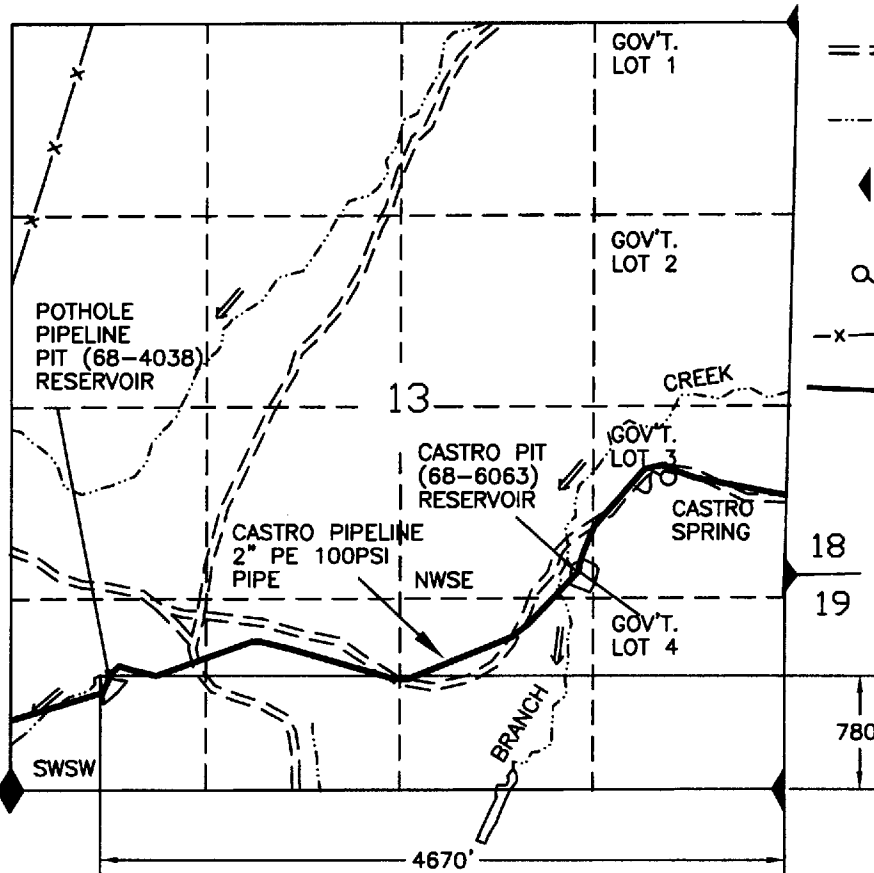


RECEIVED

DEC 10 2003

WATER RESOURCES DEPT
SALEM OREGON

POTHOLE PIPELINE PIT (68-4038) RESERVOIR

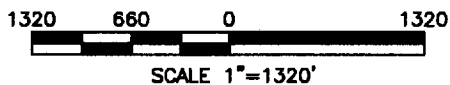

I, Thomas D. Terry, ADM Division of Field Support agree to the findings of the CWRE and do submit this site report and map as my Claim of Beneficial Use of the water as provided under the terms and conditions of my Permit R-12600

Thomas D. Terry



THIS MAP IS FOR THE PURPOSE OF LOCATING A WATER RIGHT AND IS NOT INTENDED TO PROVIDE LEGAL DIMENSIONS FOR LOCATION OF PROPERTY BOUNDARIES.

ACAD2000I
DWG FILE: POTHOLEP-BENE

UNITED STATES DEPARTMENT OF THE INTERIOR
BUREAU OF LAND MANAGEMENT
DIVISION OF OPERATIONS VALE DISTRICT

POTHOLE PIPELINE PIT
(68-4038) RESERVOIR

DESIGNED: *Thomas D. Terry*
REVIEWED: *Ken S. Hall*
APPROVED: _____

ADM OPERATIONS AND FIELD SERVICES

DRAWN: CG SCALE: 1"=1320'

DATE: 08/29/03 SHEET 1 OF 1

DRAWING NO. OR-03-9172.45-1200