

CLAIM OF BENEFICIAL USE MAP

UNDER APPLICATION R-81937; PERMIT R-12373


NE1/4 NE1/4 SEC 36 T 40S R 41E W.M.

U.S.G.S. QUAD - BOGHOLE SPRING, OREG. - 7 1/2'


RECEIVED

JUL 14 2003


WATER RESOURCES DEPT.
SALEM, OREGON

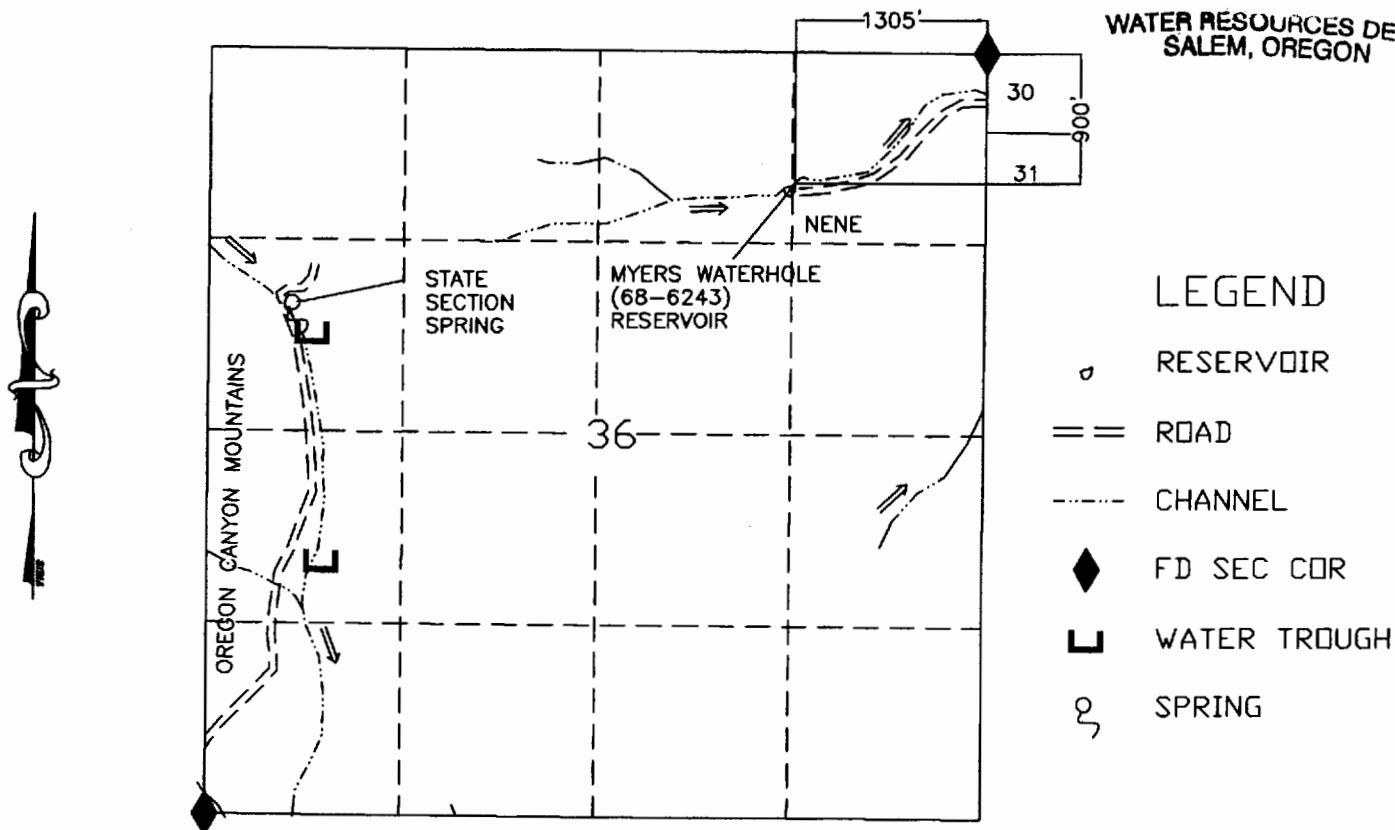

MYERS WATERHOLE (68-6243) RESERVOIR

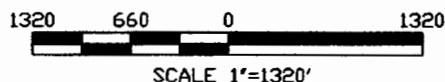

I, Thomas D. Terry, ADM Division of Field Support agree to the findings of the CWRE and do submit this site report and map as my Claim of Beneficial Use of the water as provided under the terms and conditions of my Permit R-12373.

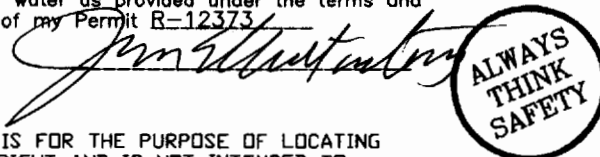

THIS MAP IS FOR THE PURPOSE OF LOCATING A WATER RIGHT AND IS NOT INTENDED TO PROVIDE LEGAL DIMENSIONS FOR LOCATION OF PROPERTY BOUNDARIES.

ACAD2000
DWG FILE MYERSWHBEN

UNITED STATES DEPARTMENT OF THE INTERIOR BUREAU OF LAND MANAGEMENT DIVISION OF OPERATIONS VALE DISTRICT	
MYERS WATERHOLE (68-6243) RESERVOIR	
DRAWN BY: <i>[Signature]</i>	
SURVEYED: <i>[Signature]</i>	
APPROVED: <i>[Signature]</i> ADM OPERATIONS AND FIELD SERVICES	
DRAWN: CG	SCALE: 1"=1320'
DATE: 07/07/03	SHEET 1 OF 1
DRAWING NO. OR-03-9172.45-1108	