

RECEIVED

JUL 03 2003


CLAIM OF BENEFICIAL USE MAP

UNDER APPLICATION R-83413; PERMIT R-12365


WATER RESOURCES DEPT.
SALEM, OREGON

GOV'T LOT 2 SEC 31 T 28S R 43E W.M.

U.S.G.S. QUAD - BOGUS BENCH, OREG. - 7 1/2'

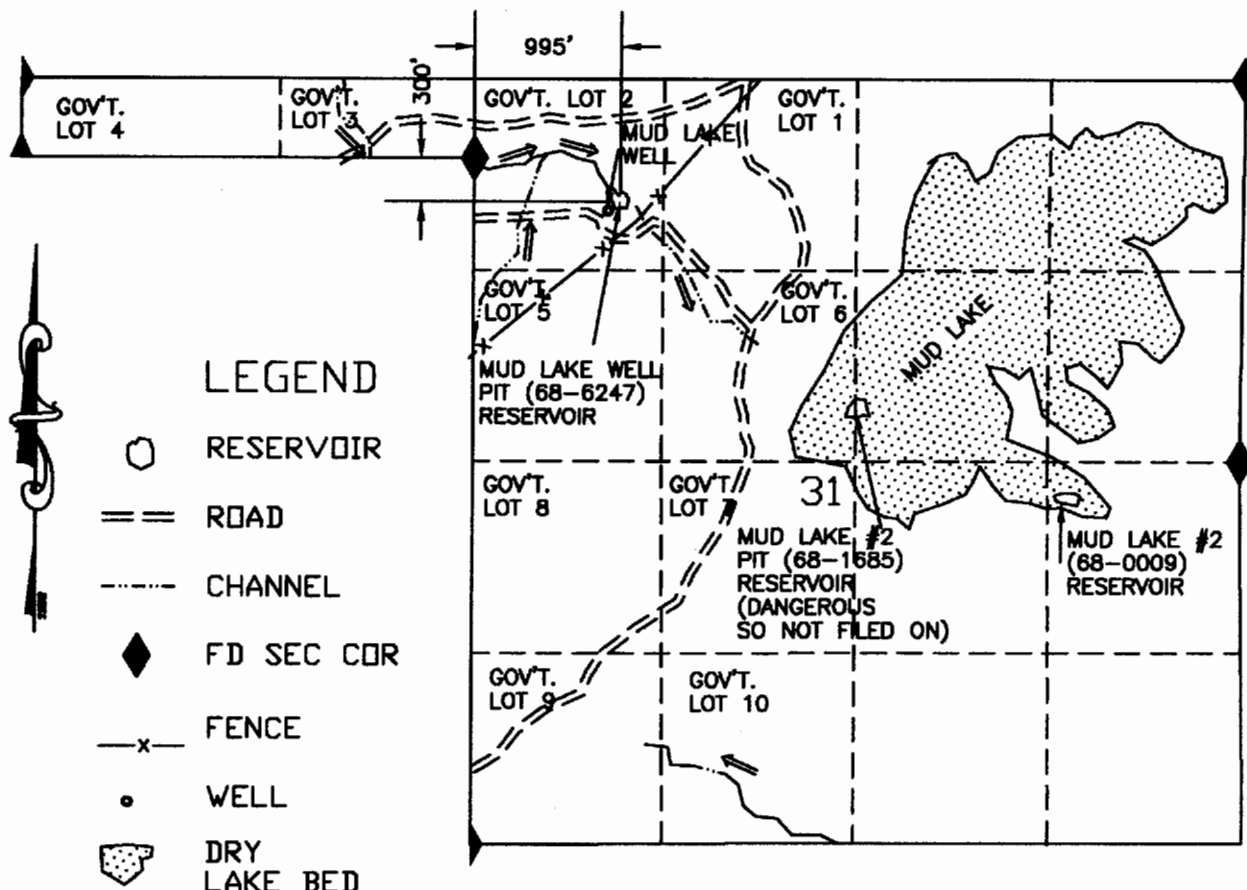

MUD LAKE WELL PIT (68-6247) RESERVOIR

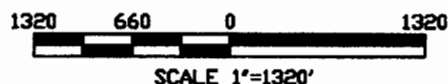

I, Thomas Terry ADM Operations/Field Services agree to the findings of the CWRE and do submit this site report and map as my Claim of Beneficial Use of the water as provided under the terms and conditions of my Permit R-12365

Thomas Terry

ALWAYS
THINK
SAFETY

THIS MAP IS FOR THE PURPOSE OF LOCATING A WATER RIGHT AND IS NOT INTENDED TO PROVIDE LEGAL DIMENSIONS FOR LOCATION OF PROPERTY BOUNDARIES.

ACAD2000/LDD
DWG FILEMUDLAKEVBN

UNITED STATES DEPARTMENT OF THE INTERIOR BUREAU OF LAND MANAGEMENT DIVISION OF OPERATIONS VALE DISTRICT	
MUD LAKE WELL PIT (68-6247) RESERVOIR	
DRAWN BY: <i>[Signature]</i>	
SURVEYED: <i>[Signature]</i>	
APPROVED: <i>[Signature]</i> ADM OPERATIONS AND FIELD SERVICES	
DRAWN: CG	SCALE: 1"=1320'
DATE: 11/02/01	SHEET 1 OF 1
DRAWING NO. OR-03-9172.45-1107	