

CLAIM OF BENEFICIAL USE MAP


 
 

 

UNDER APPLICATION R-83964; PERMIT R-12662


NW1/4 NE1/4 SEC 28 T 28S R 45E W.M.

U.S.G.S. QUAD - DOWNEY CANYON, OREG. - 7 1/2'

BASIS OF BEARING GLO
N00°10'00"E
2642.85'

LEGEND

-  RESERVOIR
-  ROAD
-  CHANNEL
-  FD SEC COR
-  FENCE
-  PRIVATE PROPERTY

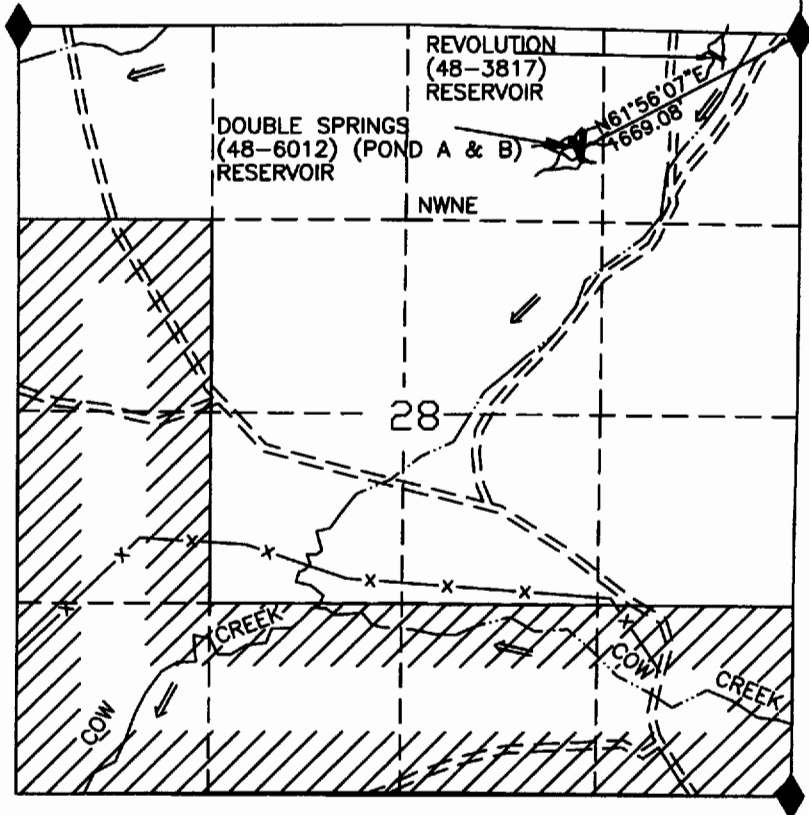

RECEIVED

DEC 10 2003

WATER RESOURCES DEPT
SALEM OREGON

DOUBLE SPRING B (48-6012) RESERVOIR



I, Thomas D. Terry, ADM Division of Field Support agree to the findings of the CWRE and do submit this site report and map as my Claim of Beneficial Use of the water as provided under the terms and conditions of my Permit R-12662

Thomas D. Terry



THIS MAP IS FOR THE PURPOSE OF LOCATING A WATER RIGHT AND IS NOT INTENDED TO PROVIDE LEGAL DIMENSIONS FOR LOCATION OF PROPERTY BOUNDARIES.

ACAD20001
DWG FILE: DBLSPRA-BENE

UNITED STATES DEPARTMENT OF THE INTERIOR BUREAU OF LAND MANAGEMENT DIVISION OF OPERATIONS VALE DISTRICT	
DOUBLE SPRINGS B (48-6012) RESERVOIR	
DESIGNED:	
REVIEWED:	<i>John J. Hall</i>
APPROVED:	<i>Thomas D. Terry</i> ADM OPERATIONS AND FIELD SERVICES
DRAWN: CG	SCALE: 1"=1320'
DATE: 09/02/03	SHEET 1 OF 1
DRAWING NO. OR-03-9172.45-1203	