


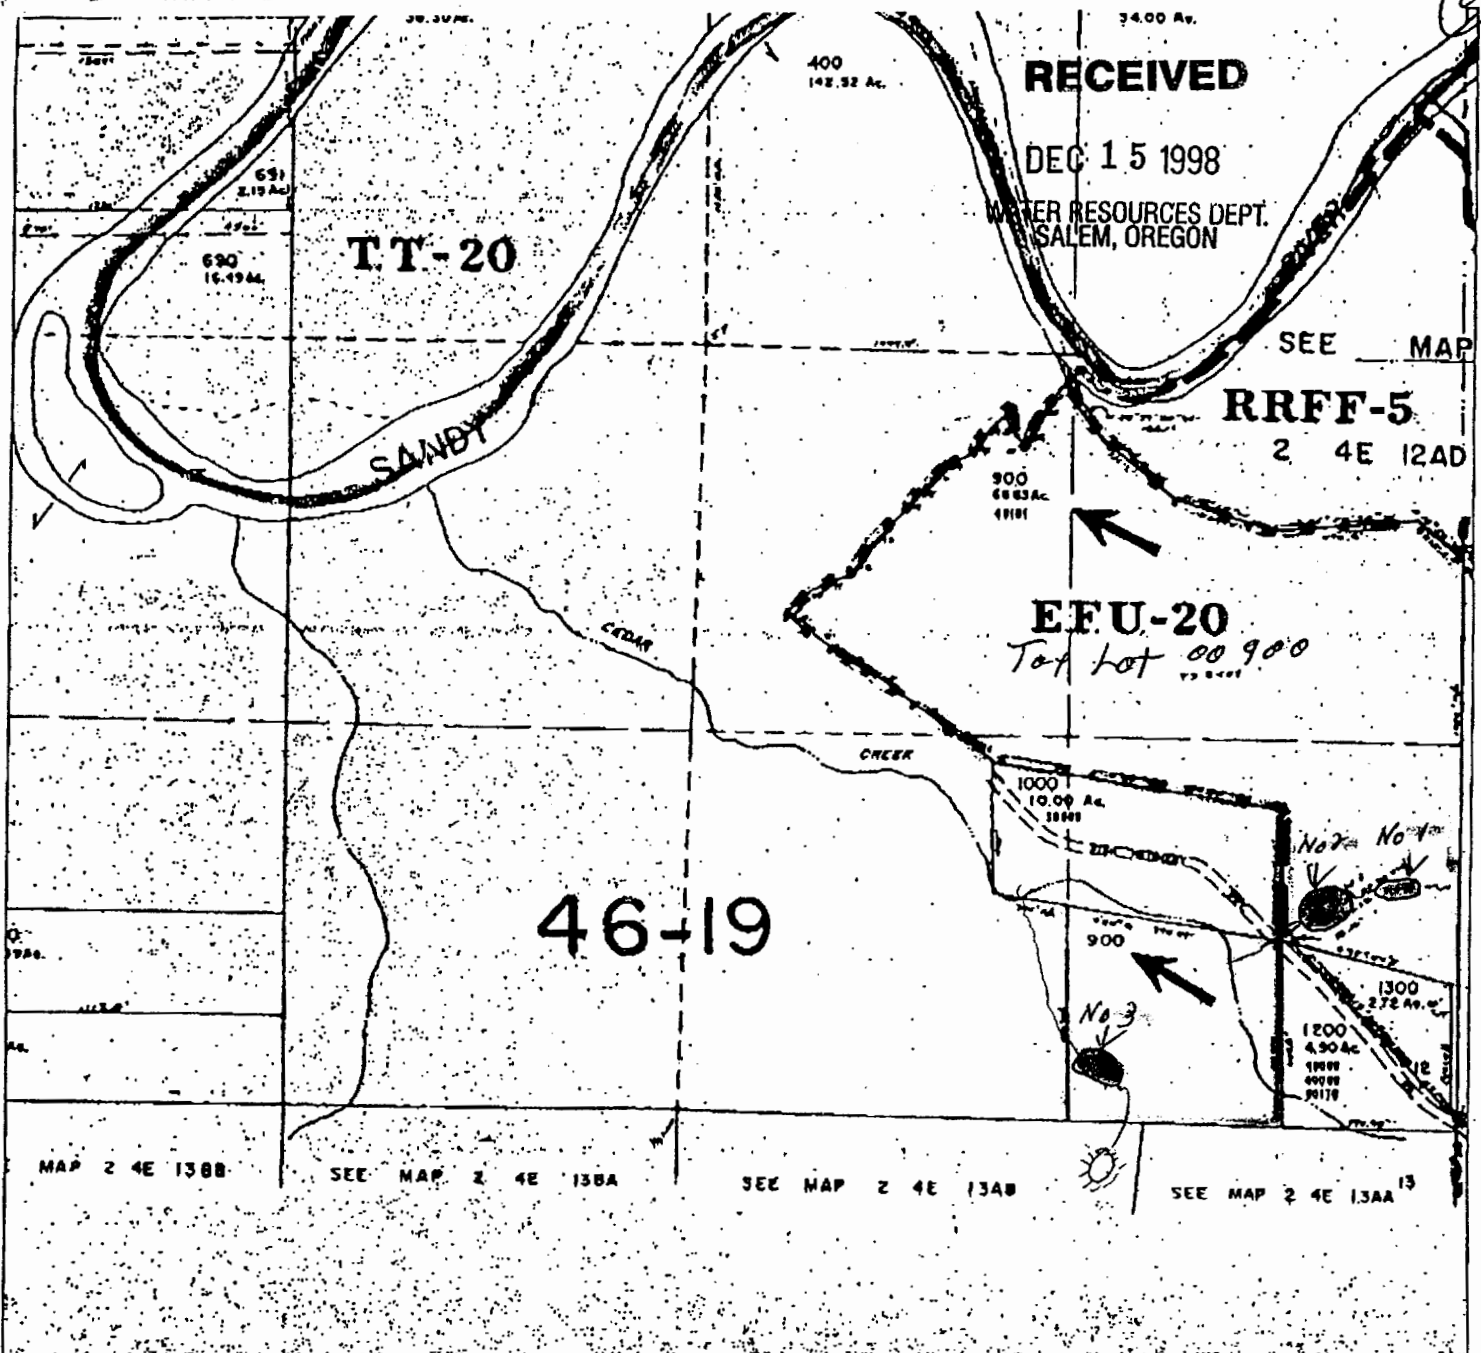

2N 4E 12

Application No. R-84016
Permit No. R-12680

