


Keith Charles
Grant County
John Day River Basin
T10S R27E Section 25
Permit #
R-12725

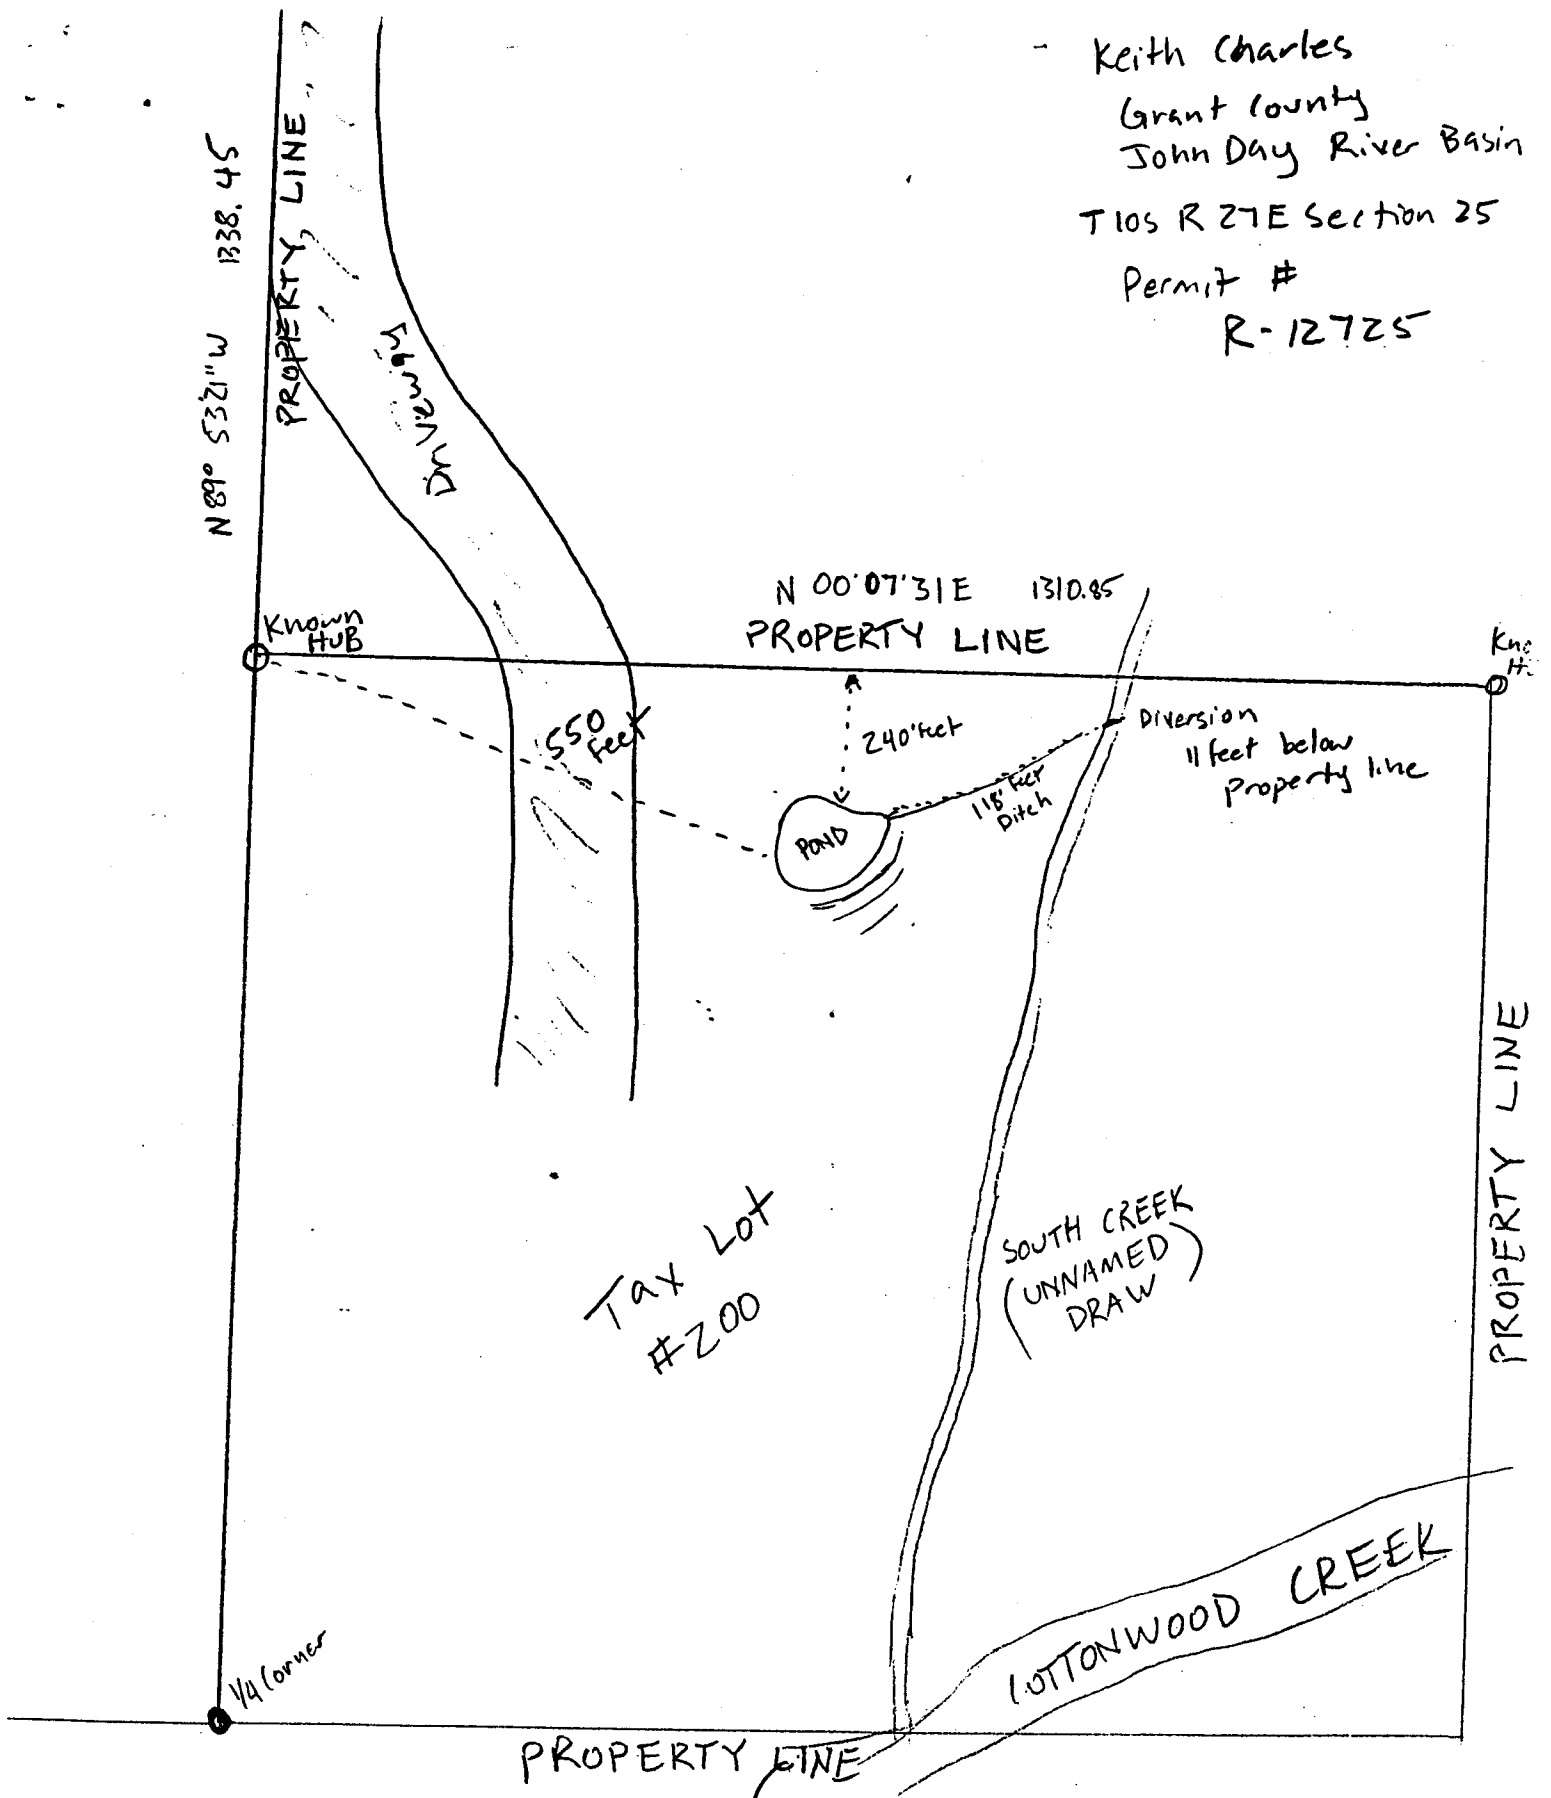

RECEIVED
FEB 28 2005
WATER RESOURCES DEPT
SALEM, OREGON

Charles Charles
2/15/05

By: Charles Charles 3/10/00