SEC. 22 TWP 36 S., R.1W, W.M.
JACKSON COUNTY

36 1W 22A

SCALE: 1 INCH = 200 FEET
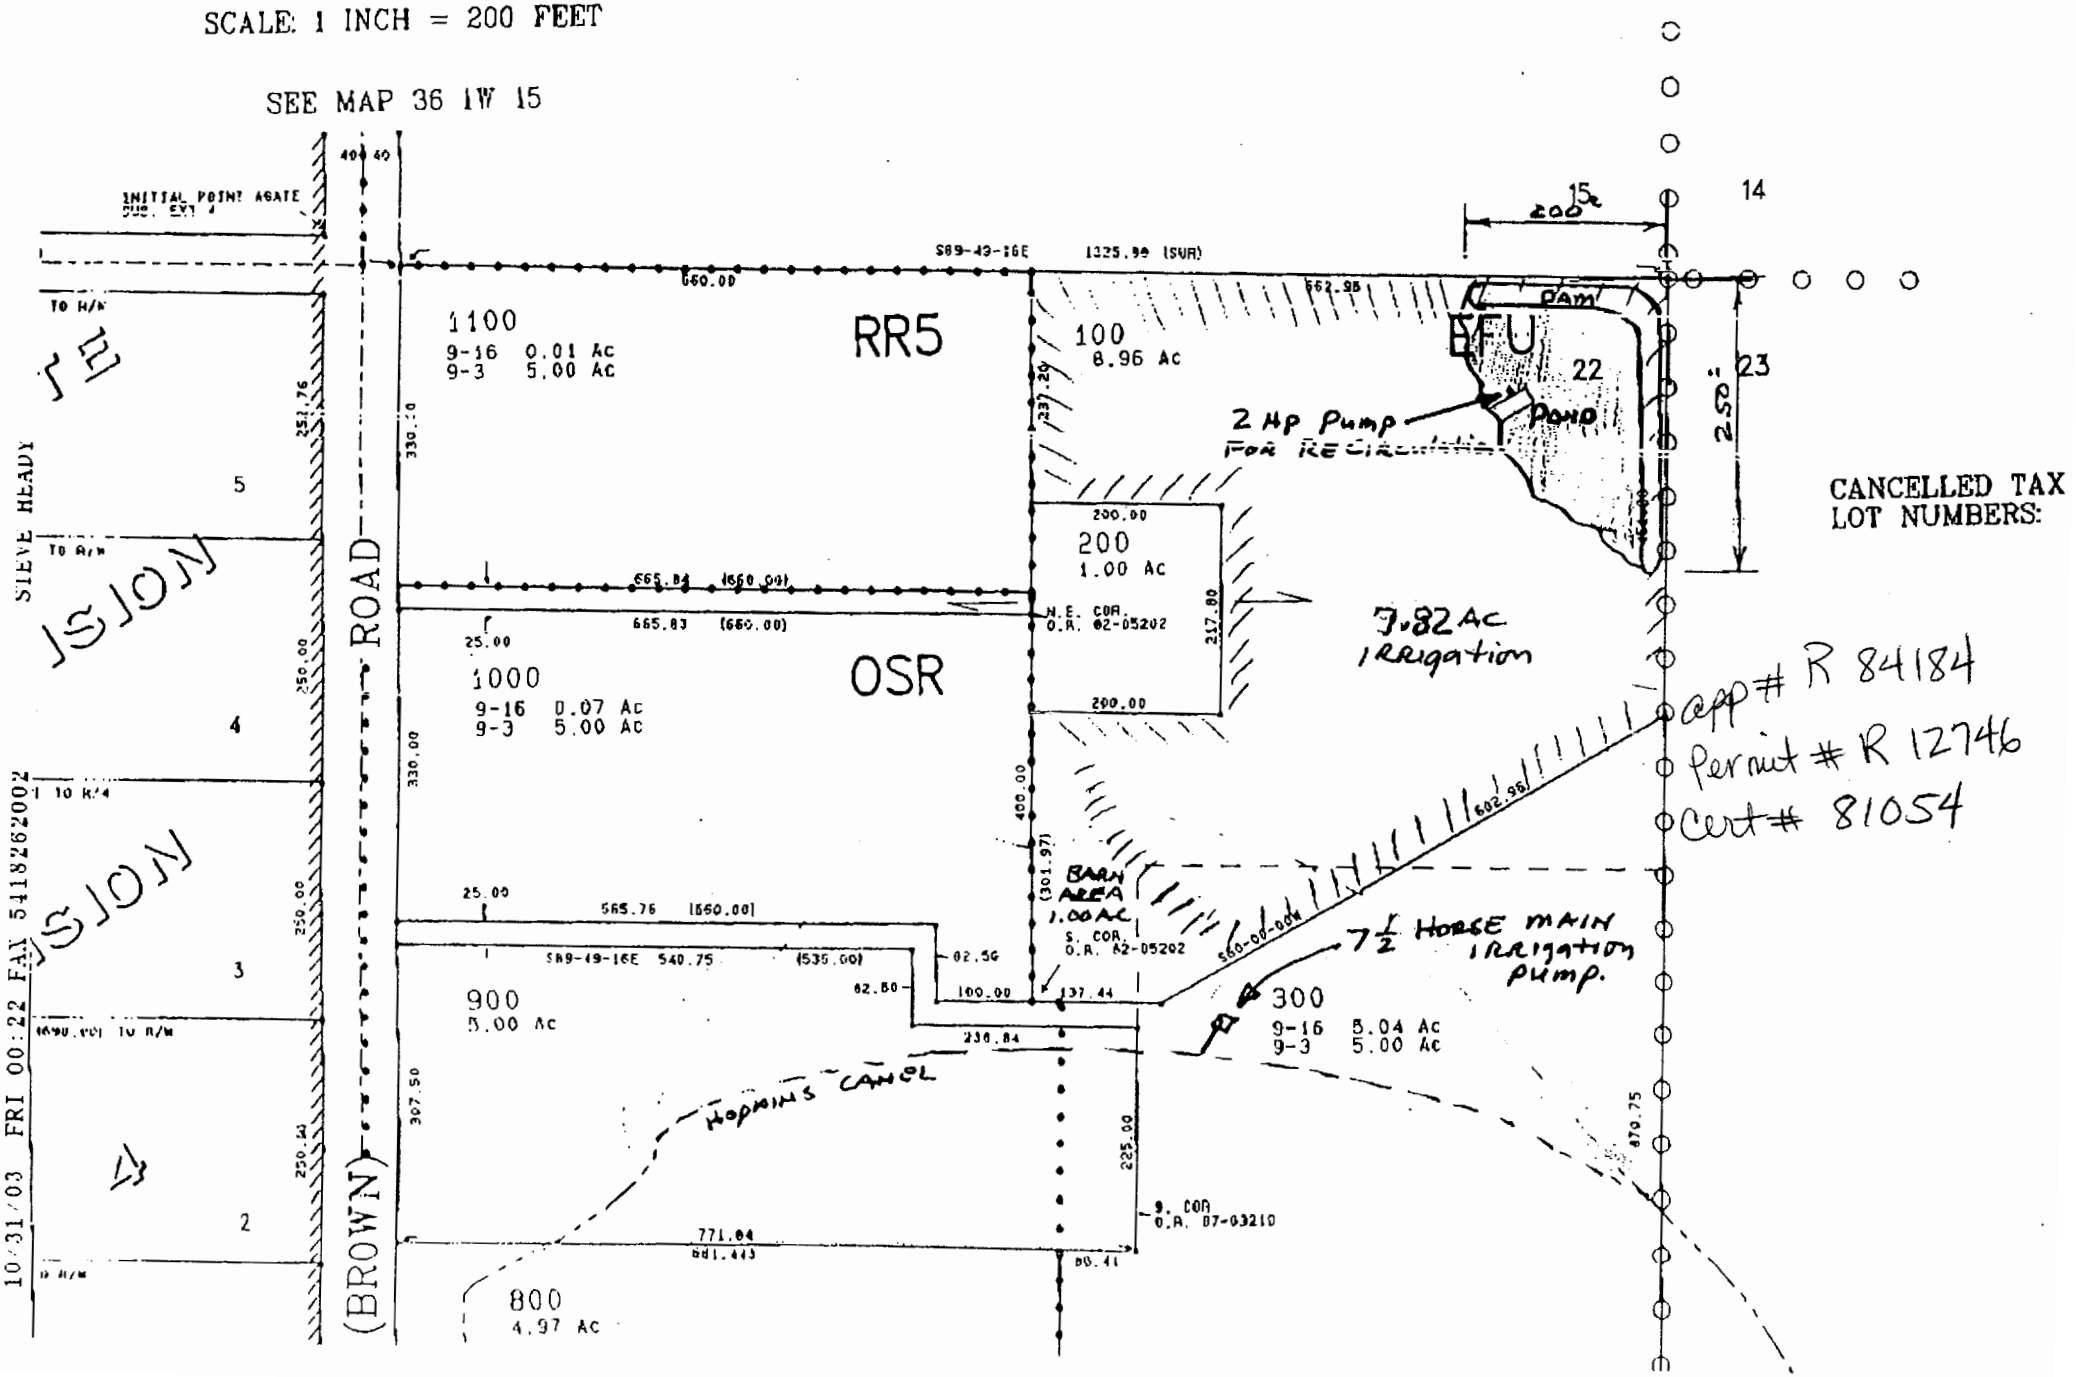
SEE MAP 36 1W 15