


SEC. 22, TWP 36 S., R.1W, W.M.  
JACKSON COUNTY

SCALE: 1 INCH = 200 FEET

SEE MAP 36 1W 15

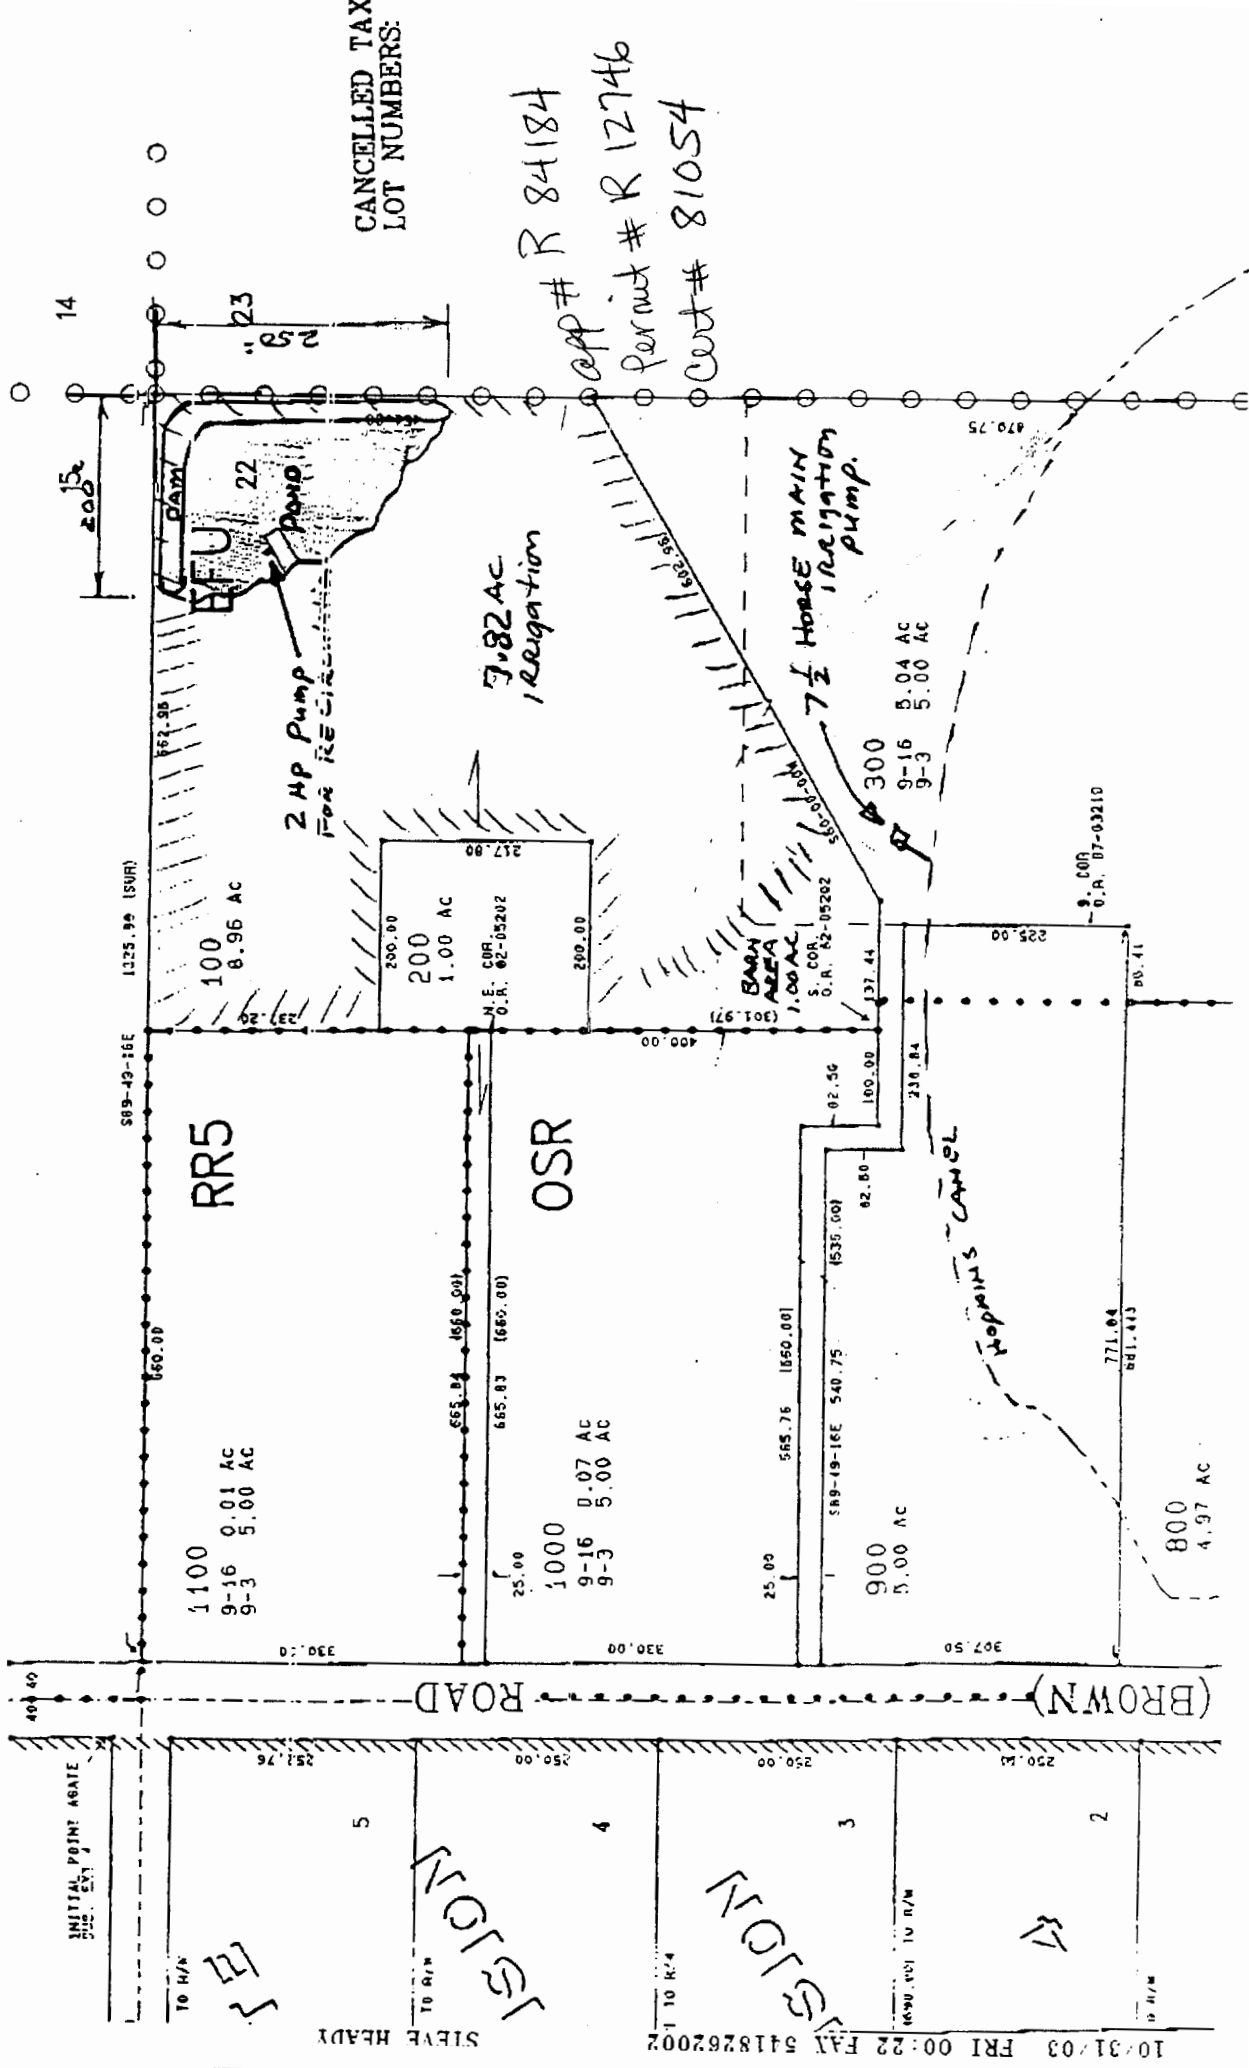

CANCELED TAX  
LOT NUMBERS:

app # R 84184  
Permit # R 12746  
Cont # 81054

(BROWN) ROAD

SIEVE HEADY

10/31/03 FRI 00:22 FAX 5418262002

INITIAL POINT AGATE  
SUC. E.V. J

5

4

3

2

1100  
9-16 0.01 AC  
9-3 5.00 AC

1000  
9-16 0.07 AC  
9-3 5.00 AC

900  

800  
4.97 AC

RR5

OSR

100  
8.96 AC

200  
1.00 AC

BARN AREA  
1.00 AC

2 HP Pump  
FOR RECIRCULATION

7.82 AC  
Irrigation

7 1/2 HORSE MAIN  
IRRIGATION  
PUMP.

HOPKINS CAMEL

9.00  
O.R. 07-03210

N.E. COR.  
O.R. 62-05202

S. COR.  
O.R. 62-05202

14

23

2005

S89-40-16E

1325.99 (SVR)

161.30

237.29

290.00

217.00

290.00

400.00

301.97

337.44

100.00

02.56

100.00

238.84

307.50

771.04

841.443

80.41

225.00

470.75

300

9-16 5.04 AC  
9-3 5.00 AC













