
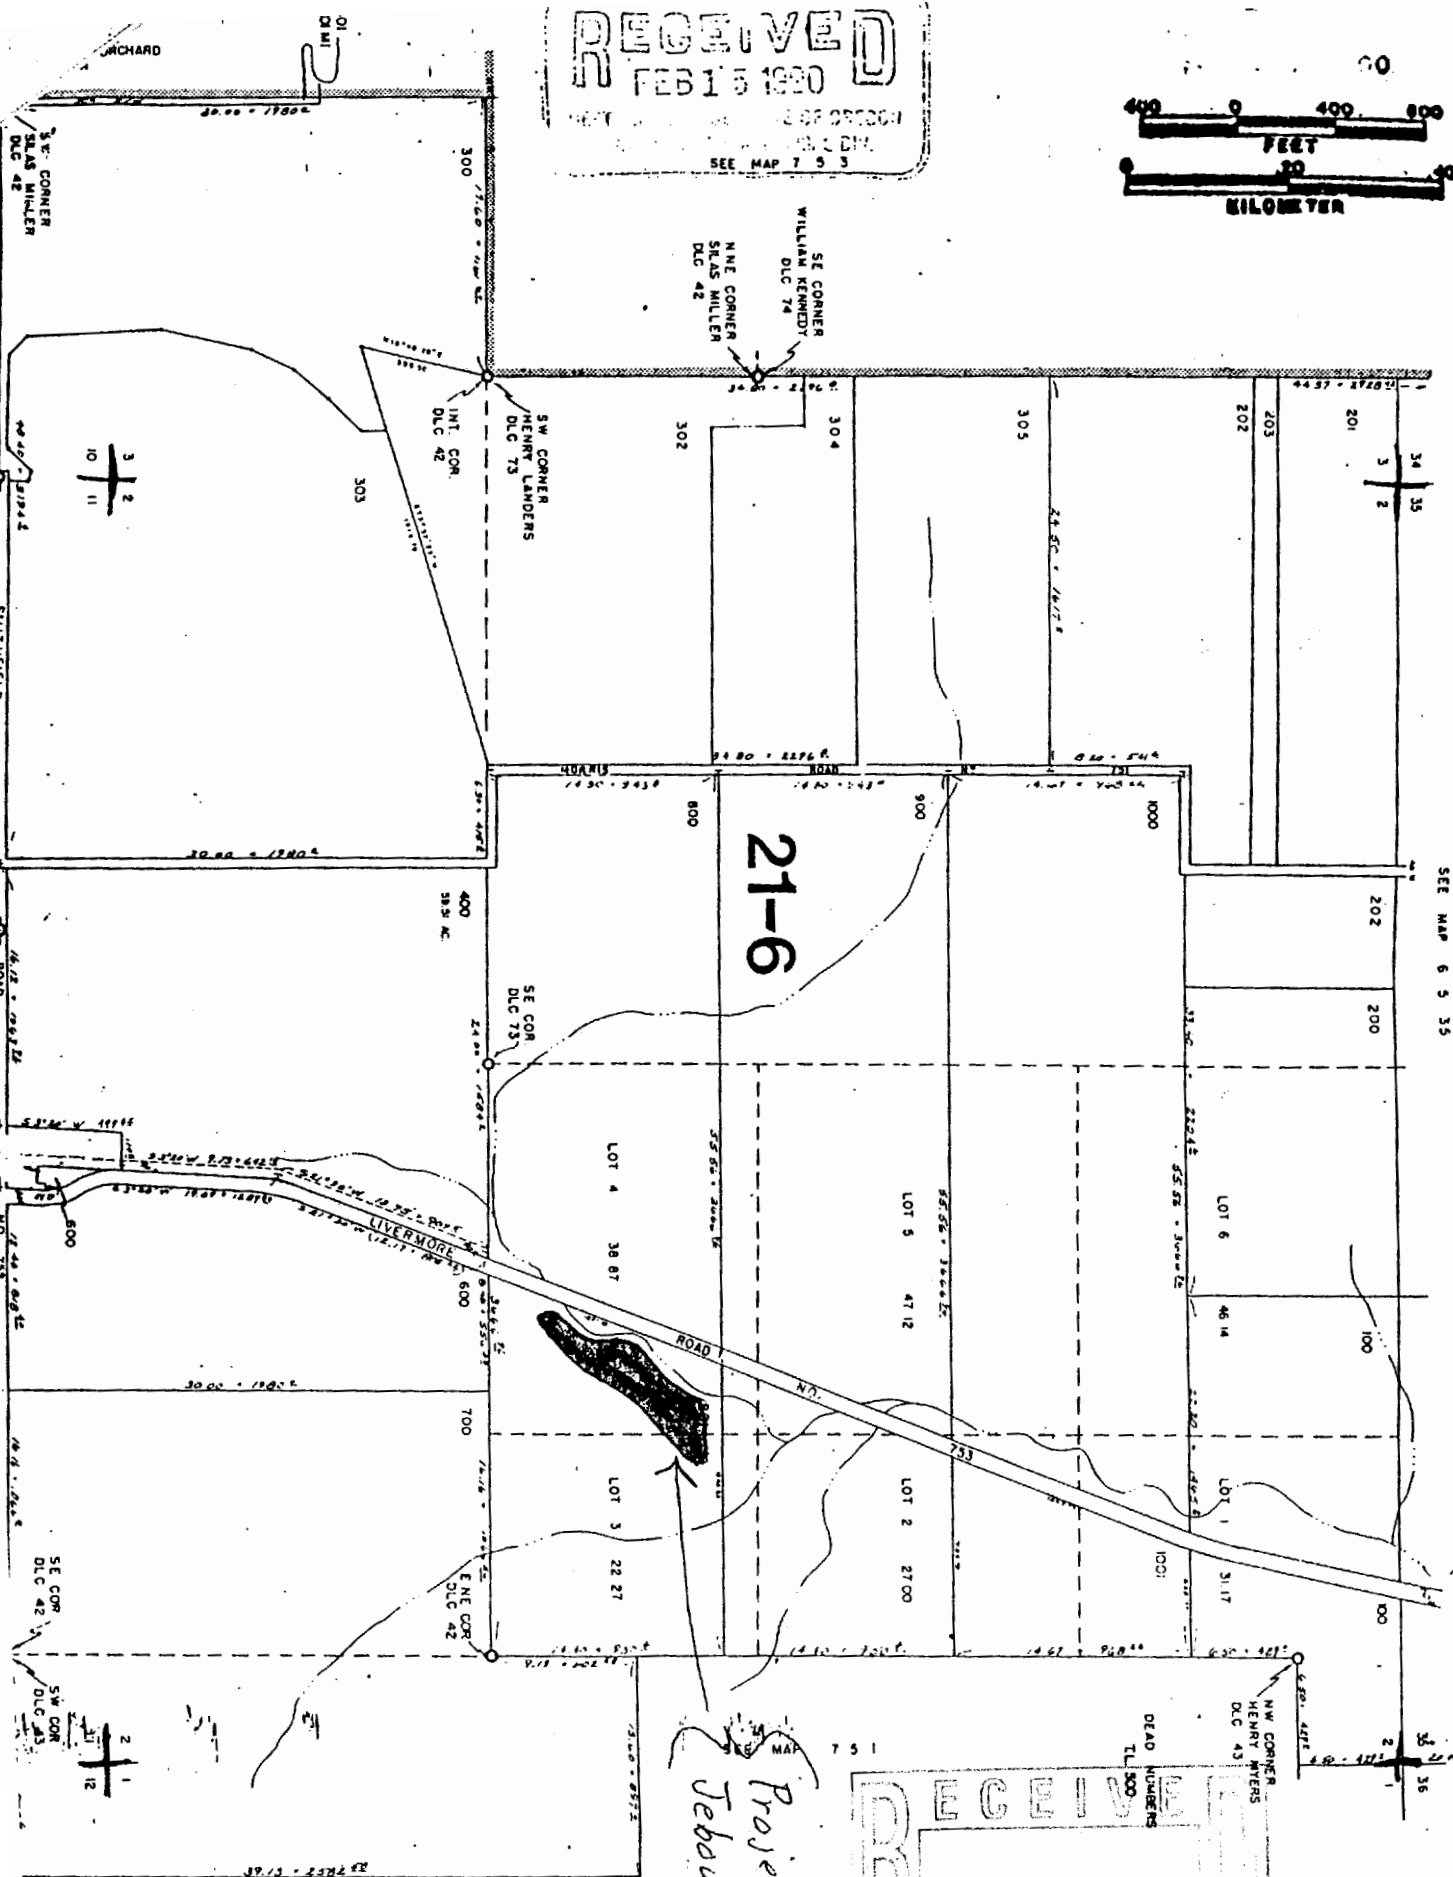


RECEIVED
FEB 13 1990

WATER RESOURCES DEPT OF OREGON
SALEM, OREGON 97331

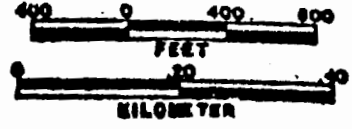

21-6

Project location
Jebausak 2

RECEIVED
NOV 29 2001
WATER RESOURCES DEPT
SALEM, OR

SCALE 1"=400'

SEE MAP 6 9 35

Application R 84187
752