

RECEIVED

JAN 09 2004

CLAIM OF BENEFICIAL USE MAP


WATER RESOURCES DEPT
SALEM OREGON

UNDER APPLICATION R-84533; PERMIT R-13052

SE1/4 NW1/4 SEC 15 T 30S R 37E W.M.

Cert # 81060

U.S.G.S. QUAD - JOHNNY CREEK NW, OREG. - 7 1/2'

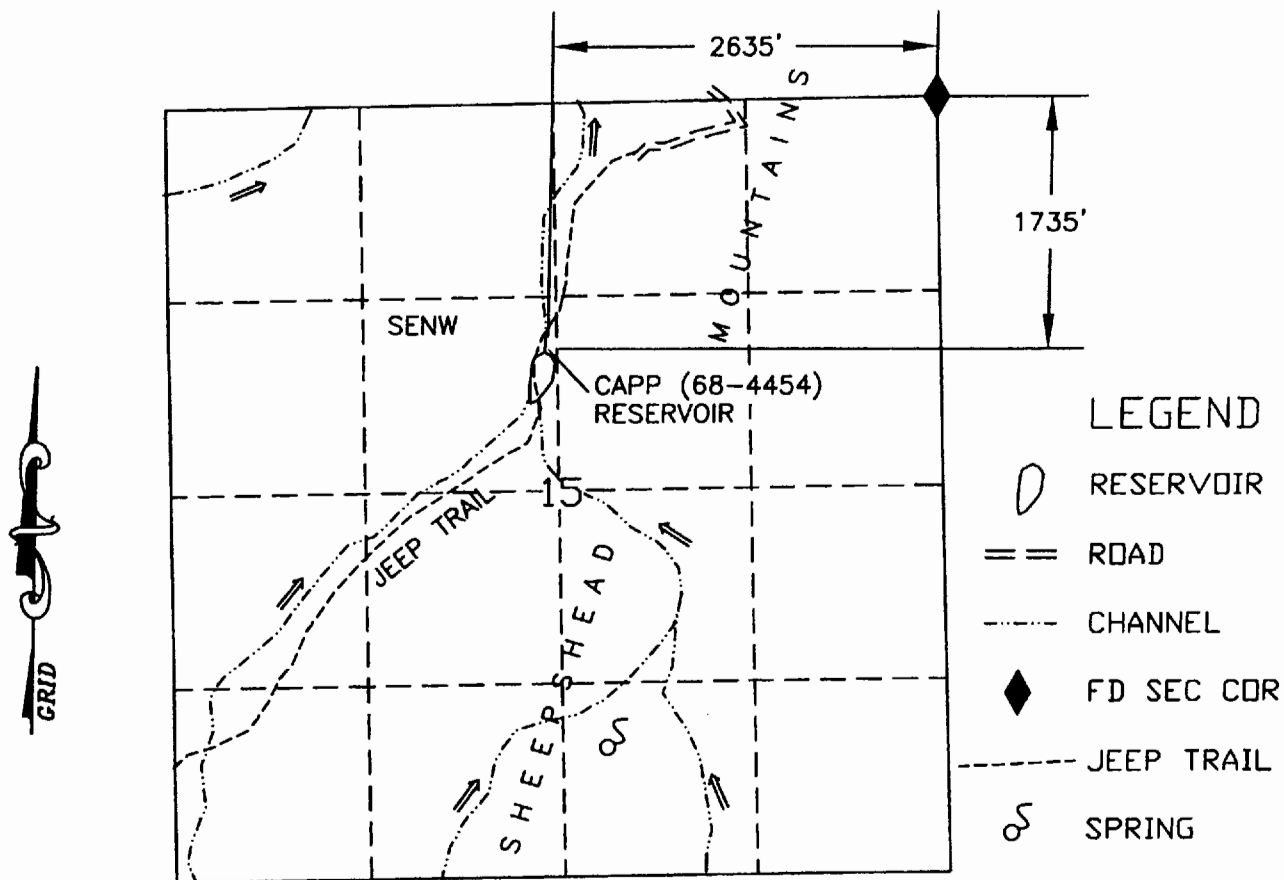

CAPP (68-4454) RESERVOIR

1320 660 0 1320
SCALE 1"=1320'

I, Thomas D. Terry, ADM Division of Field Support agree to the findings of the CWRE and do submit this site report and map as my Claim of Beneficial Use of the water as provided under the terms and conditions of my Permit R-13052.

Thomas D. Terry



THIS MAP IS FOR THE PURPOSE OF LOCATING A WATER RIGHT AND IS NOT INTENDED TO PROVIDE LEGAL DIMENSIONS FOR LOCATION OF PROPERTY BOUNDARIES.

ACAD20001
DWG FILE: CAPP-BENE

UNITED STATES DEPARTMENT OF THE INTERIOR BUREAU OF LAND MANAGEMENT DIVISION OF OPERATIONS VALE DISTRICT	
CAPP (68-4454) RESERVOIR	
DESIGNED:	
REVIEWED:	<i>Don 3 166</i>
APPROVED:	<i>Thomas D. Terry</i> ADM OPERATIONS AND FIELD SERVICES
DRAWN: CG	SCALE: 1"=1320'
DATE: 09/02/03	SHEET 1 OF 1
DRAWING NO. DR-03-9172.45-1205	