
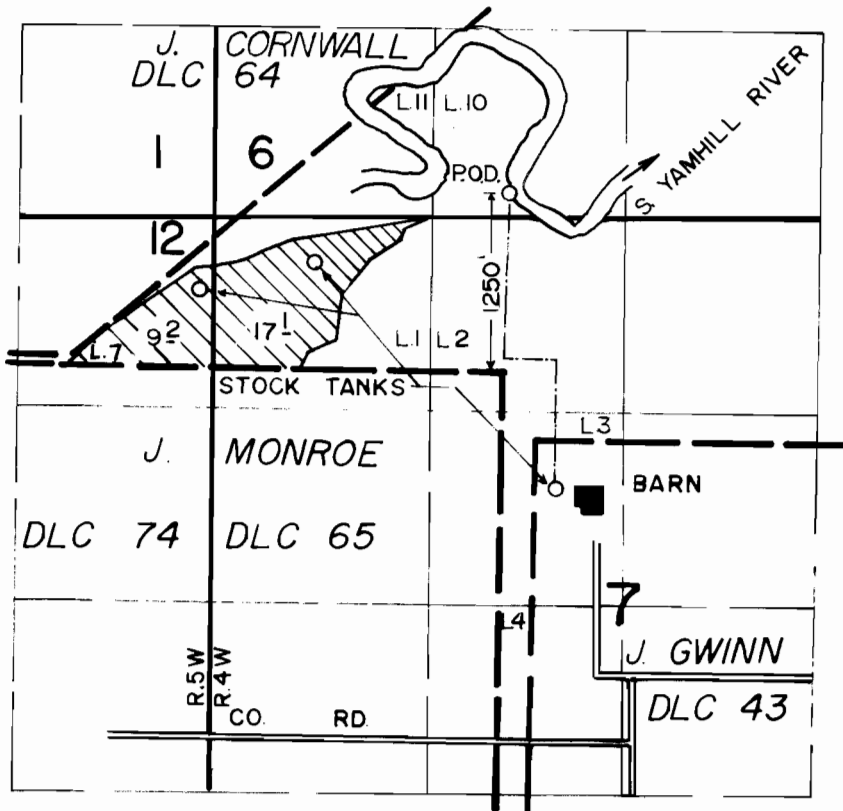


T. 5 S., R. 4 & 5 W. W.M.

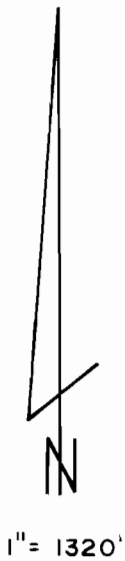

FINAL PROOF SURVEY UNDER

Application No. 55166 Permit No. 41461
IN NAME OF

SHARER

Surveyed OCTOBER 6 1983, by P. PRAGTER