


# T.16S., R.4W., W.M.

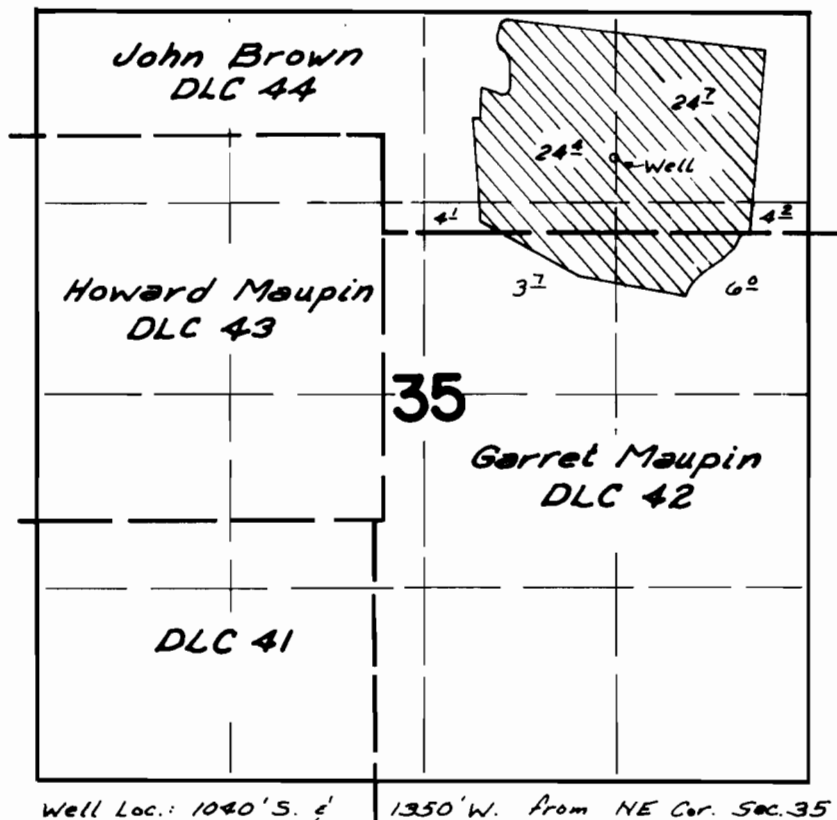

## FINAL PROOF SURVEY UNDER

Application No. G-5558 Permit No. G-5431  
IN NAME OF

Esther Jane Everson & John Scott

Surveyed May 14, 1976, by D.M. Norby