


T.I.S., R.I.W., W.M.

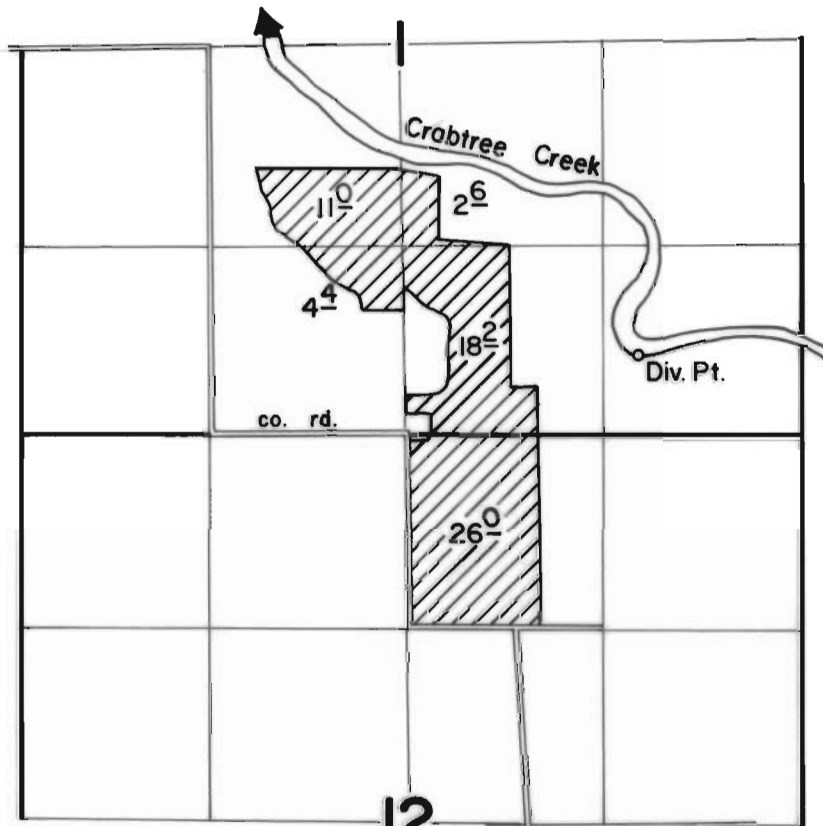

DIV. PT. LOC: 570' N & 1620' E from S 1/4 cor. sec. 1

FINAL PROOF SURVEY
UNDER

Application No. 51666 Permit No. 38956
IN NAME OF

PURMAN & MARY ANN RICHEY

Surveyed Sept. 30 1976, by D. Norby