T.1S., R.2W., W.M.

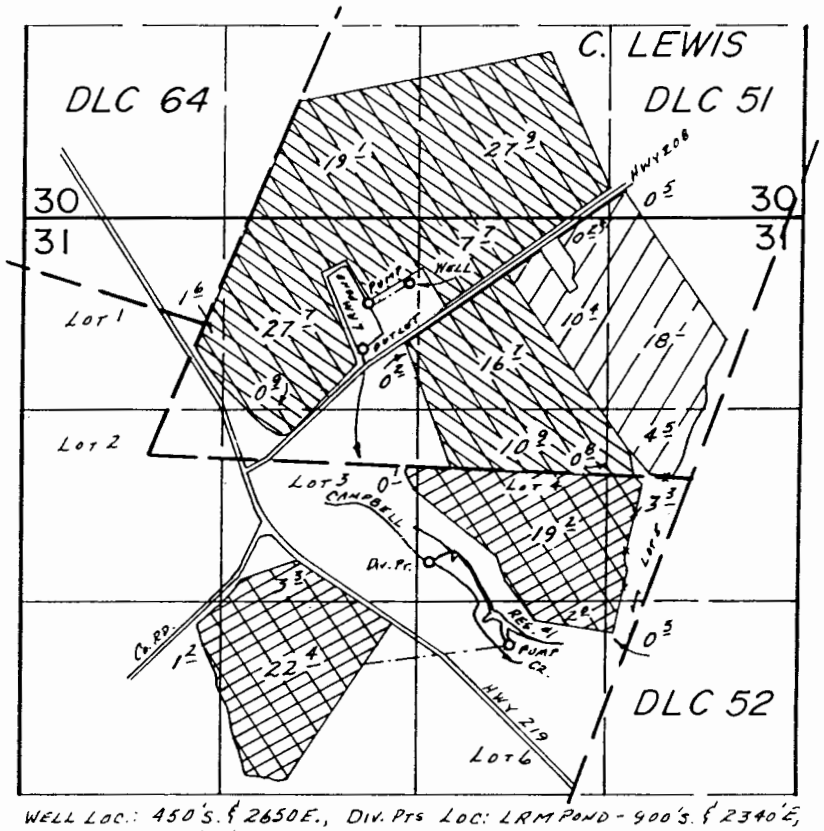

WELL LOC.: 450'S. & 2650E., DIV. PTS LOC: LRM POND - 900'S. & 2340'E, RES. #1 - 2370'S & 2790'E, ALL FROM NW COR SEC. 31.

SCALE: 1" = 1320'

FINAL PROOF SURVEY

UNDER

55461	43172
55462	43174
G-7908	G-8144
G-7912	G-8145
Application No. G-9234	Permit No. G-8585

IN NAME OF

.....

Surveyed July 24 1986, by B.W. BISHOP
Feb. 4 1987

2/4/87
BWB

41067-178-137A