



 
 

 
T. 1 S., R. 2 W., W. M.

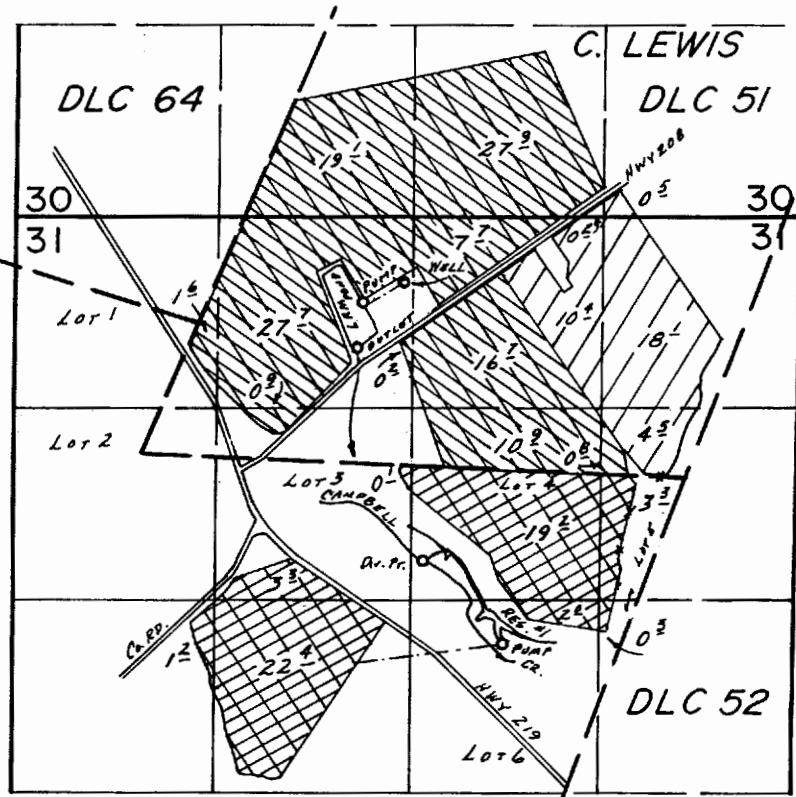

WELL LOC: 450'S. & 2650'E., DIV. Pts LOC: LRM POND - 900'S. & 2340'E,  
RES. #1- 2370'S & 2790'E, ALL FROM NW COR SEC. 31.

SCALE: 1" = 1320'

**FINAL PROOF SURVEY**  
UNDER

55461	43172	
55462	43174	
G-7908	G-8144	
G-7912	G-8145	
Application No. G-9234	Permit No. G-8585	

IN NAME OF

.....  
 Surveyed July 24, 1986, by B.W. BISHOP.....  
 Feb. 4 1987

2/4/87  
BWB

41067-178-137A