


CLAIM OF BENEFICIAL USE MAP

UNDER APPLICATION R-84535; PERMIT R-13044

SE1/4 NE 1/4 SEC 33 T 33S R 45E W.M.

U.S.G.S. QUAD - WHITEHORSE BUTTE, OREG. - 7 1/2'

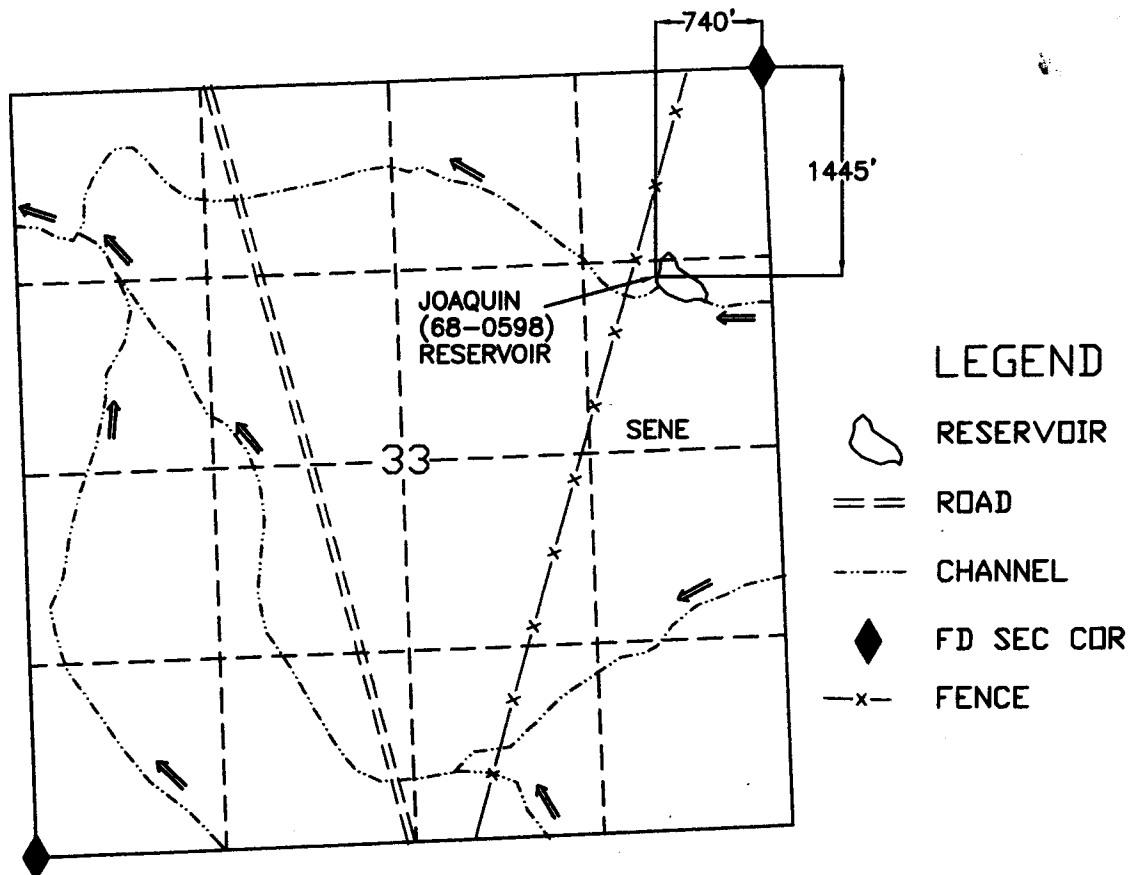

RECEIVED

DEC 22 2003

WATER RESOURCES DEPT
SALEM, OREGON

JOAQUIN (68-0598) RESERVOIR



I, Thomas D. Terry, ADM Division of Field Support agree to the findings of the CWRE and do submit this site report and map as my Claim of Beneficial Use of the water as provided under the terms and conditions of my Permit R-13044.

Thomas D. Terry



THIS MAP IS FOR THE PURPOSE OF LOCATING A WATER RIGHT AND IS NOT INTENDED TO PROVIDE LEGAL DIMENSIONS FOR LOCATION OF PROPERTY BOUNDARIES.

ACAD2004
DWG FILE: JOAQUINA.DWG

UNITED STATES DEPARTMENT OF THE INTERIOR
BUREAU OF LAND MANAGEMENT
DIVISION OF OPERATIONS VALE DISTRICT

JOAQUIN (68-0598)
RESERVOIR

DESIGNED: _____
REVIEWED: John J. Hall
APPROVED: Thomas D. Terry
ADM OPERATIONS AND FIELD SERVICES

DRAWN: CG	SCALE: 1"=1320'
DATE: 12/17/03	SHEET 1 OF 1
DRAWING NO. OR-03-9172.45-1223	