


CLAIM OF BENEFICIAL USE MAP

UNDER APPLICATION R-84537; PERMIT R-13046

NE1/4 SW1/4 SEC 28 T 40S R 46E W.M.


U.S.G.S. QUAD - OREGON BUTTE, OREG. - 7 1/2'

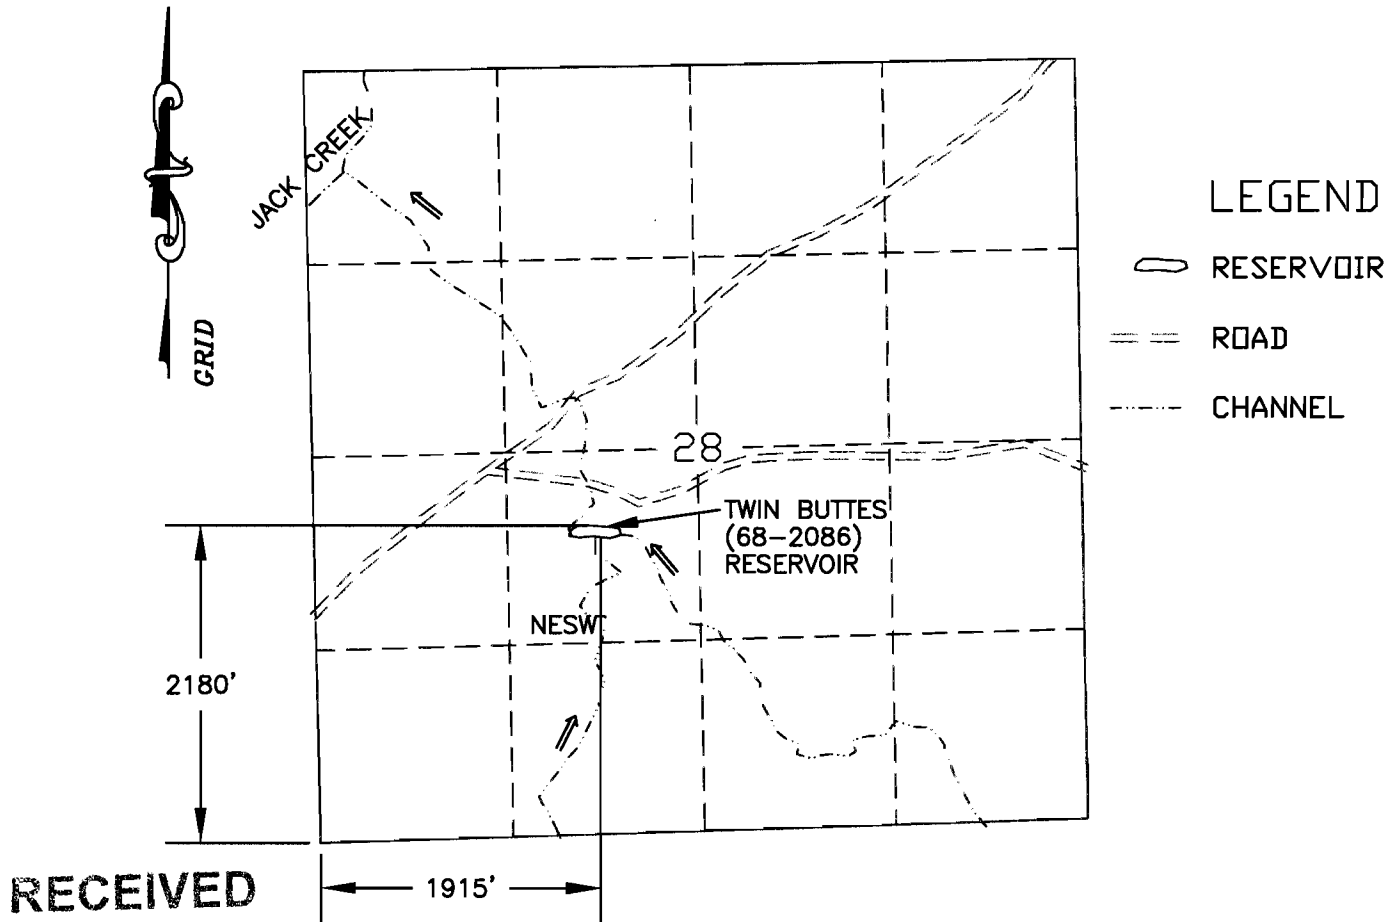

RECEIVED

DEC 18 2003 TWIN BUTTES (68-2086) RESERVOIR

WATER RESOURCES DEPT
SALEM, OREGON

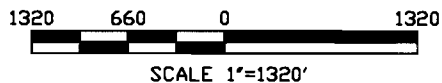

I, Thomas D. Terry, ADM Division of Field Support agree to the findings of the CWRE and do submit this site report and map as my Claim of Beneficial Use of the water as provided under the terms and conditions of my Permit R-13046.

Thomas D. Terry



THIS MAP IS FOR THE PURPOSE OF LOCATING A WATER RIGHT AND IS NOT INTENDED TO PROVIDE LEGAL DIMENSIONS FOR LOCATION OF PROPERTY BOUNDARIES.

ACAD2004
DWG FILEWINBUTTESAPP

UNITED STATES DEPARTMENT OF THE INTERIOR
BUREAU OF LAND MANAGEMENT
DIVISION OF OPERATIONS VALE DISTRICT

TWIN BUTTES (68-2086)
RESERVOIR

DESIGNED: _____
REVIEWED: *Ray 3 Hill*
APPROVED: *Thomas D. Terry*
ADM OPERATIONS AND FIELD SERVICES

DRAWN: CG SCALE: 1"=1320'
DATE: 12/08/03 SHEET 1 OF 1
DRAWING NO. OR-03-9172.45-1223