


CLAIM OF BENEFICIAL USE MAP

UNDER APPLICATION R-84538; PERMIT R-13047

NE1/4 NW1/4 SEC 18 T 34S R 44E W.M.

U.S.G.S. QUAD - SQUAW FLAT, OREG. - 7 1/2'

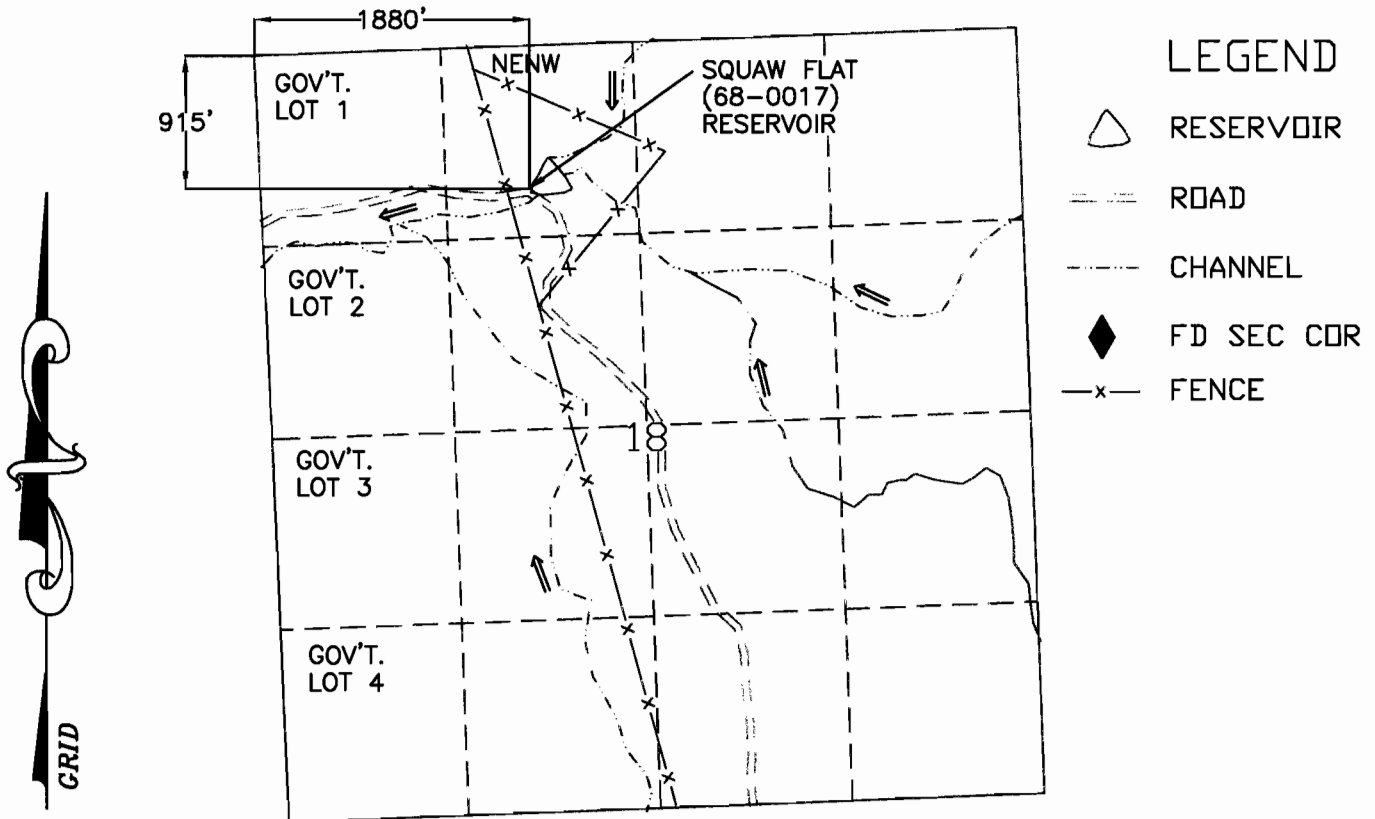


RECEIVED

DEC 18 2003

SQUAW FLAT (68-0017) RESERVOIR

WATER RESOURCES DIV.
SALEM, OREGON

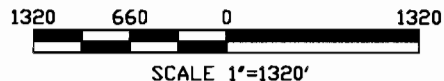

I, Thomas D. Terry, ADM Division of Field Support agree to the findings of the CWRE and do submit this site report and map as my Claim of Beneficial Use of the water as provided under the terms and conditions of my Permit R-13047

Thomas D. Terry



THIS MAP IS FOR THE PURPOSE OF LOCATING A WATER RIGHT AND IS NOT INTENDED TO PROVIDE LEGAL DIMENSIONS FOR LOCATION OF PROPERTY BOUNDARIES.

ACAD2004
DWG FILE: SQUAWFLATA

UNITED STATES DEPARTMENT OF THE INTERIOR
BUREAU OF LAND MANAGEMENT
DIVISION OF OPERATIONS VALE DISTRICT

SQUAW FLAT (68-0017)
RESERVOIR

DESIGNED:

REVIEWED:

APPROVED:

ADM OPERATIONS AND FIELD SERVICES

DRAWN:

CG

SCALE: 1"=1320'

DATE:

12/08/03

SHEET 1 OF 1

DRAWING NO.

OR-03-9172.45-1220