

CLAIM OF BENEFICIAL USE MAP

UNDER APPLICATION R-84539; PERMIT R-13048

NE1/4 SE1/4 SEC 20 T 17S R 38E W.M.

U.S.G.S. QUAD - HUNTER MOUNTAIN, OREG. - 7 1/2'

LEGEND


△ RESERVOIR

—x— FENCE

--- CHANNEL

◆ FD SEC COR

∞ SPRING

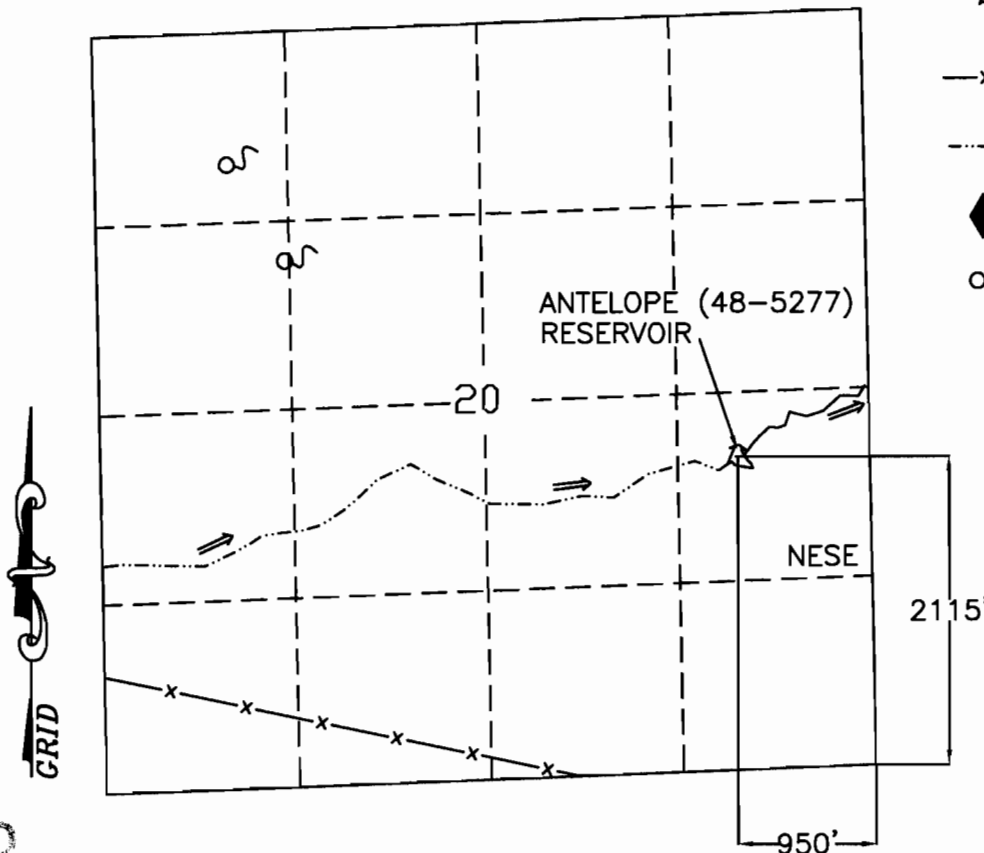

RECEIVED

DEC 18 2003

ANTELOPE (48-5277) RESERVOIR

WATER RESOURCES DIVISION
SALEM, OREGON

1320 660 0 1320
SCALE 1"=1320'

I, Thomas D. Terry, ADM Division of Field Support agree to the findings of the CWRE and do submit this site report and map as my Claim of Beneficial Use of the water as provided under the terms and conditions of my Permit R-13048.

Thomas D. Terry



THIS MAP IS FOR THE PURPOSE OF LOCATING A WATER RIGHT AND IS NOT INTENDED TO PROVIDE LEGAL DIMENSIONS FOR LOCATION OF PROPERTY BOUNDARIES.

ACAD2000I
DWG FILE ANTELOPE-5277

UNITED STATES DEPARTMENT OF THE INTERIOR
BUREAU OF LAND MANAGEMENT
DIVISION OF OPERATIONS VALE DISTRICT

ANTELOPE (48-5277)
RESERVOIR

DESIGNED:

REVIEWED:

APPROVED:

DRAWN:

CG

DATE:

09/02/03

DRAWING NO.

DR-03-9172.45-1204

SCALE: 1"=1320'

SHEET 1 OF 1