


CLAIM OF BENEFICIAL USE MAP

UNDER APPLICATION R-84616; PERMIT R-13055

NW1/4 SE1/4 SEC 11 T 39S R 39E W.M.

U.S.G.S. QUAD - DOOLITTLE CREEK, OREG. - 7 1/2'

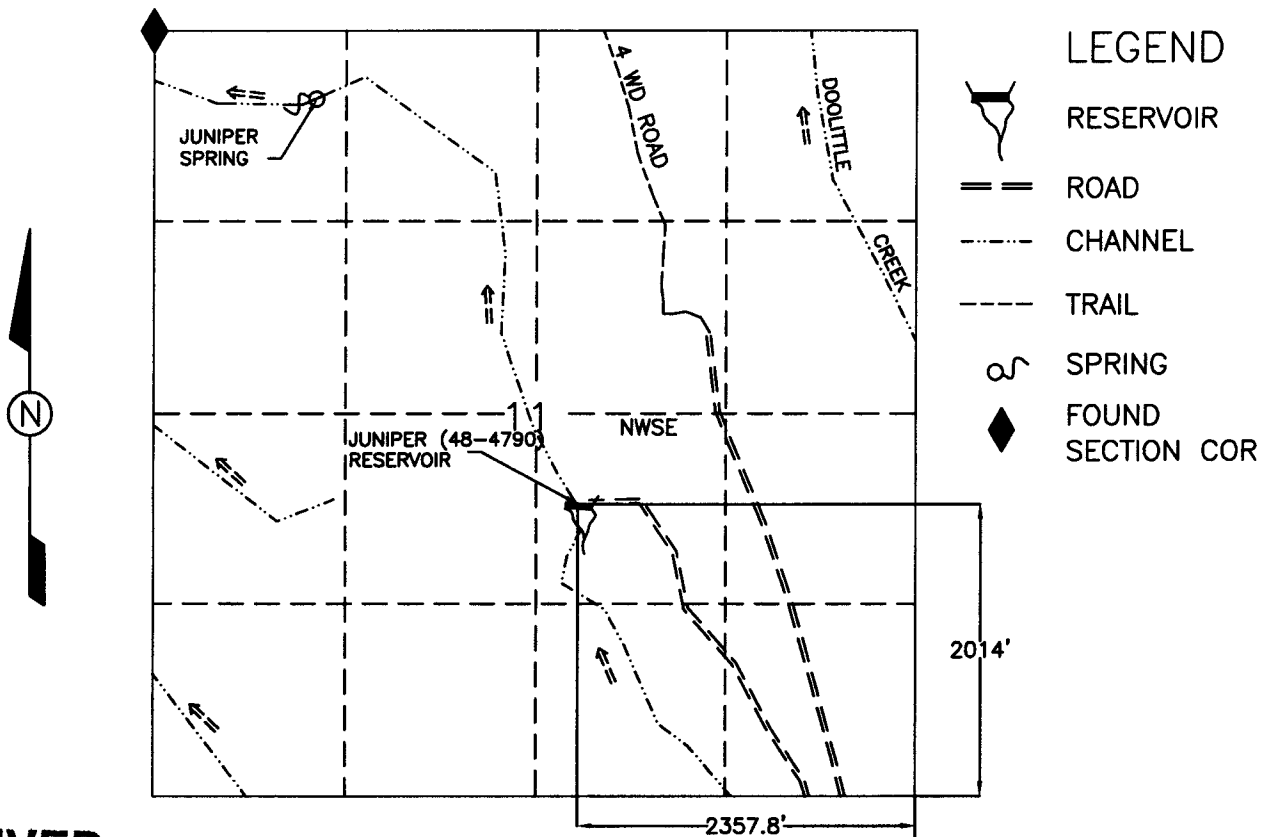

RECEIVED

DEC 18 2003

JUNIPER (68-4790) RESERVOIR

WATER RESOURCES DEPT
SALEM, OREGON

1320 660 0 1320
SCALE 1"=1320'

I, Thomas D. Terry, ADM Division of Field Support agree to the findings of the CWRE and do submit this site report and map as my Claim of Beneficial Use of the water as provided under the terms and conditions of my Permit R-13055

Thomas D. Terry



THIS MAP IS FOR THE PURPOSE OF LOCATING A WATER RIGHT AND IS NOT INTENDED TO PROVIDE LEGAL DIMENSIONS FOR LOCATION OF PROPERTY BOUNDARIES.

ACAD20001
DWG FILE:JUNIPER-BENE

UNITED STATES DEPARTMENT OF THE INTERIOR BUREAU OF LAND MANAGEMENT DIVISION OF OPERATIONS VALE DISTRICT	
JUNIPER (68-4790) RESERVOIR	
DESIGNED:	
REVIEWED:	<i>Long ? Hall</i>
APPROVED:	<i>Thomas D. Terry</i> ADM OPERATIONS AND FIELD SERVICES
DRAWN: CG	SCALE: 1"=1320'
DATE: 09/10/03	SHEET 1 OF 1
DRAWING NO. OR-03-9172.45-1208	