


CLAIM OF BENEFICIAL USE MAP

UNDER APPLICATION R-84617; PERMIT R-13056

NE1/4 SE1/4 SEC 13 T 22S R 38E W.M.

U.S.G.S. QUAD - MONUMENT PEAK, OREG. - 7 1/2'

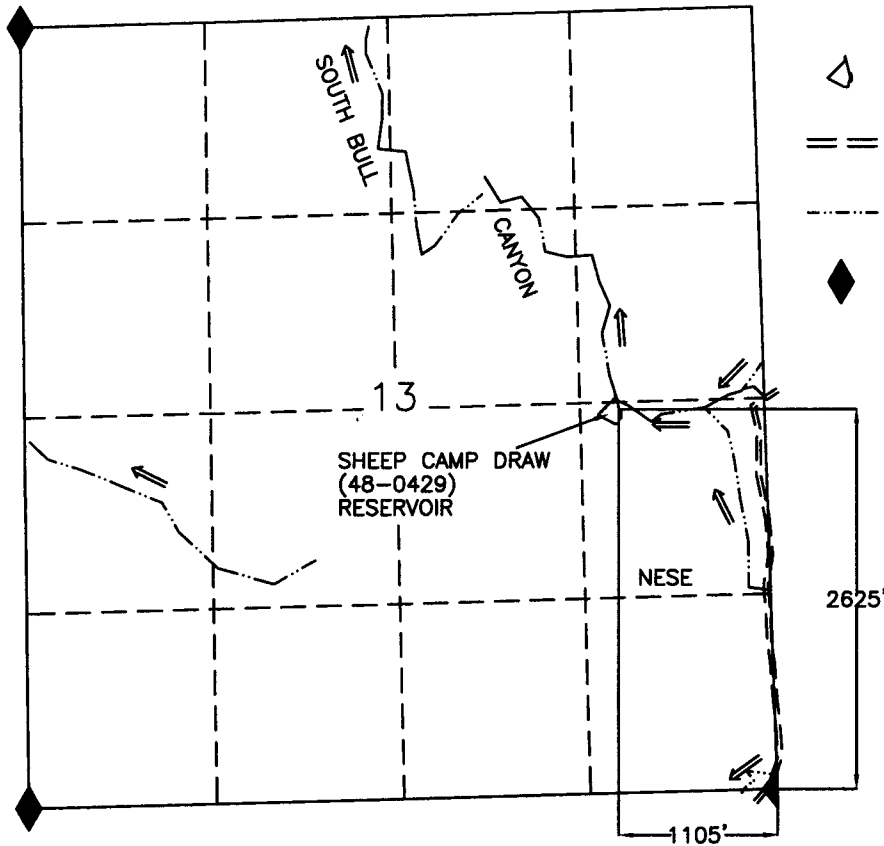


LEGEND

- RESERVOIR
- ROAD
- CHANNEL
- FD SEC COR

RECEIVED

DEC 18 2003

WATER RESOURCES DEPT. SHEEP CAMP DRAW (48-0429) RESERVOIR
SALEM, OREGON

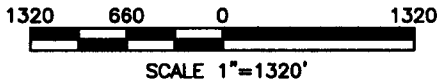

I, Thomas D. Terry, ADM Division of Field Support agree to the findings of the CWRE and do submit this site report and map as my Claim of Beneficial Use of the water as provided under the terms and conditions of my Permit R-13056

Thomas D. Terry



THIS MAP IS FOR THE PURPOSE OF LOCATING A WATER RIGHT AND IS NOT INTENDED TO PROVIDE LEGAL DIMENSIONS FOR LOCATION OF PROPERTY BOUNDARIES.

ACAD2001
DWG FILE: SHEEPCAMP

UNITED STATES DEPARTMENT OF THE INTERIOR BUREAU OF LAND MANAGEMENT DIVISION OF OPERATIONS VALE DISTRICT	
SHEEP CAMP DRAW (48-0429) RESERVOIR	
DESIGNED:	
REVIEWED:	<i>Long? Hall</i>
APPROVED:	<i>Thomas D. Terry</i> ADM OPERATIONS AND FIELD SERVICES
DRAWN: CG	SCALE: 1"=1320'
DATE: 09/18/03	SHEET 1 OF 1
DRAWING NO. OR-03-9172.45-1212	